
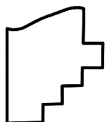


PARENT PARCEL: 04-00-017-102-145

CHILD PARCEL: 04-00-017-102-288 thru -290

STARTING POINT: CL OF AVON BELDEN RD. & BELMONT DR.

21-04400

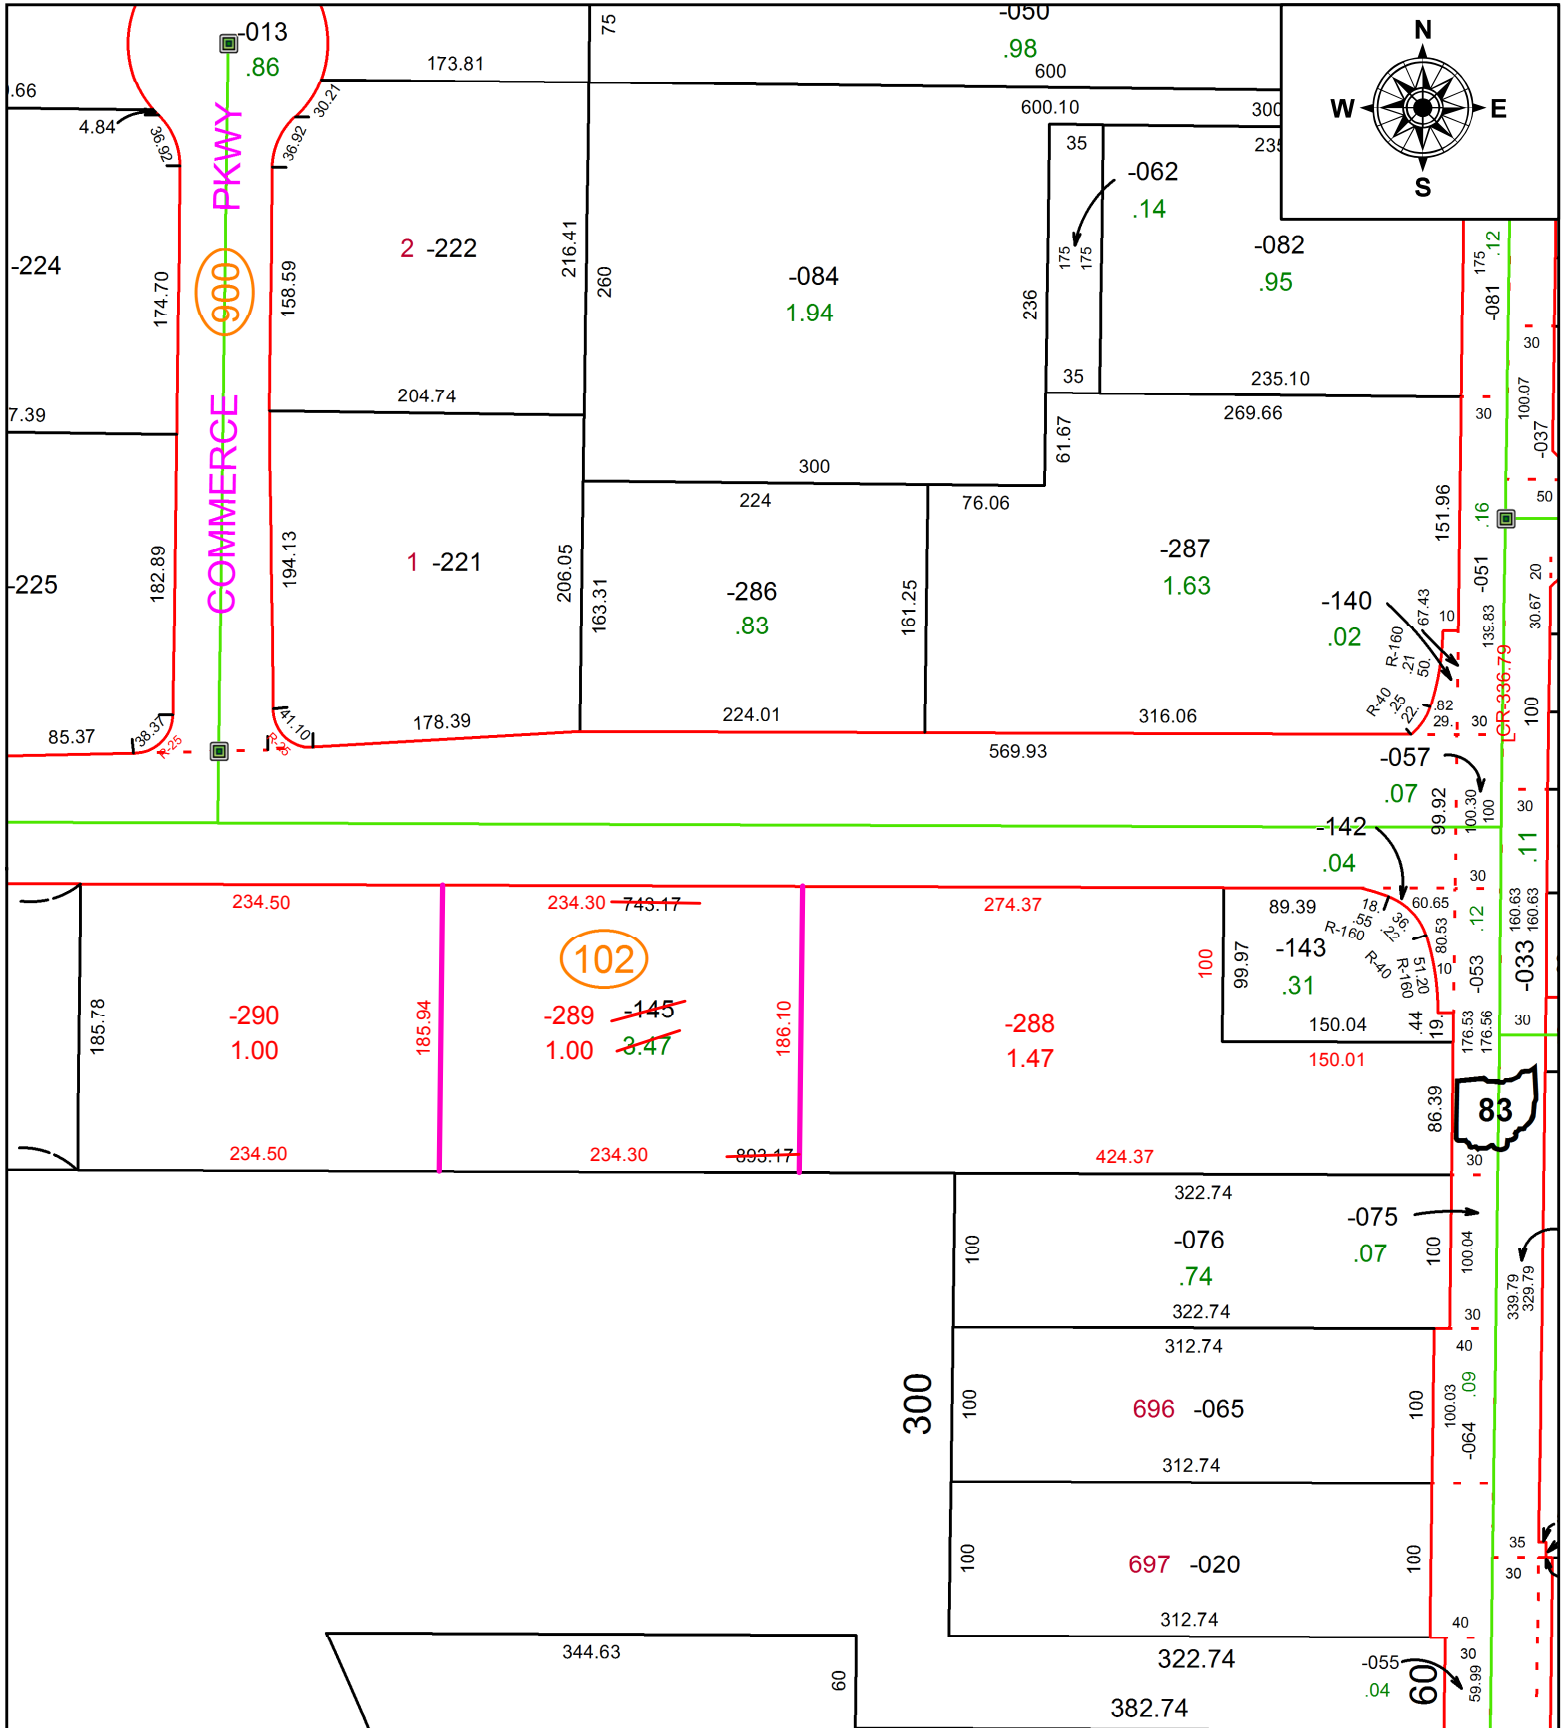

SPLITS/DEEDS PROCESSED
 LORAIN COUNTY TAX MAP DEPARTMENT
 226 MIDDLE AVE. ELYRIA, OH

SURVEYED BY: JAMES RESAR
CLOSURE: 1: 137,646
MAP PAGE(S): 04-00-017
APPROVED BY: DMA **DATE:** 11/3/2021
SCALE: 1" = 125' **PRIOR INSTRUMENT:** 20070226760