


PARENT PARCEL: 12-00-020-121-022

CHILD PARCEL: 12-00-020-121-030, -031


STARTING POINT: S/L 551 AND PT. OF VACATED ALDRIDGE DR. IN WET VIEW PARK

20-04404-U

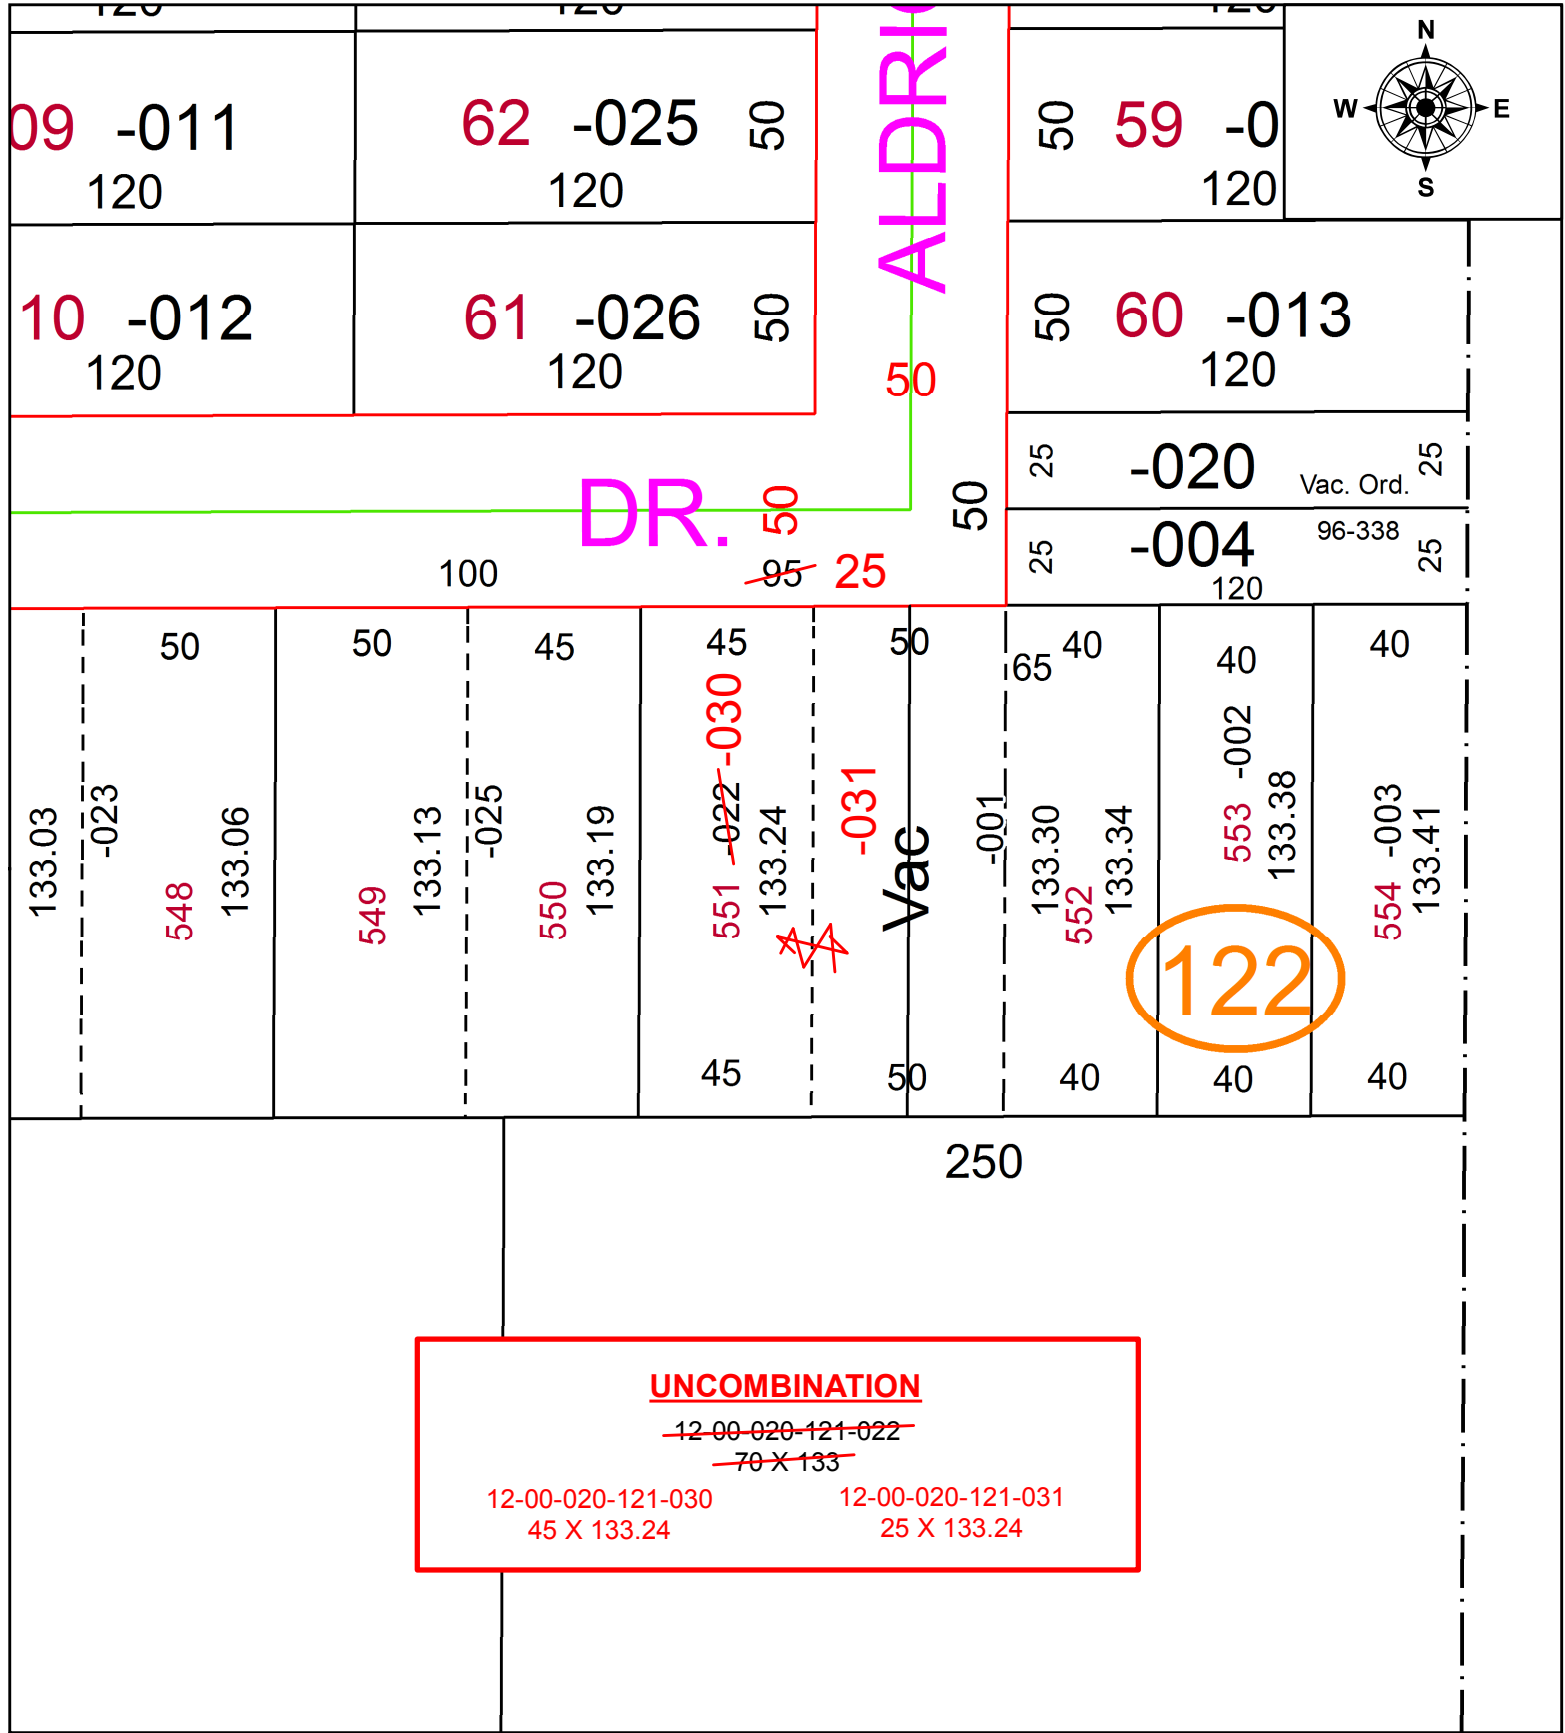

UNCOMBINATION
~~12-00-020-121-022~~
~~70 X 133~~
 12-00-020-121-030 12-00-020-121-031
 45 X 133.24 25 X 133.24

122

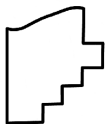

SPLITS/DEEDS PROCESSED
 LORAIN COUNTY TAX MAP DEPARTMENT
 226 MIDDLE AVE. ELYRIA, OH

SURVEYED BY: _____ N/A
 CLOSURE: _____ N/A
 MAP PAGE(S): _____ 12-00-020
 APPROVED BY: _____ RRM DATE: _____ 9-25-20
 SCALE: _____ 1" = 50 PRIOR INSTRUMENT: _____ 20180663122