


PARENT PARCEL: 09-00-017-000-001, -007-000-018, -008-000-026, -016-000-006, 05-00-051-000-011

CHILD PARCEL: 09-00-017-000-008 thru -011

STARTING POINT: C.L. OF RUSSIA RD & S.W. CORNER OF O.L. 17

21-04406

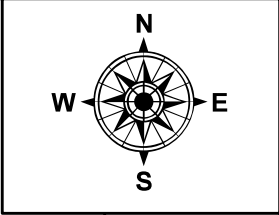


17


2399.09
~~2755.61~~

~~001~~ ~~009~~
~~83.05~~ ~~81.05~~

-011
~~79.05~~
79.77

Ac. Corr. per survey Timothy Hozalski

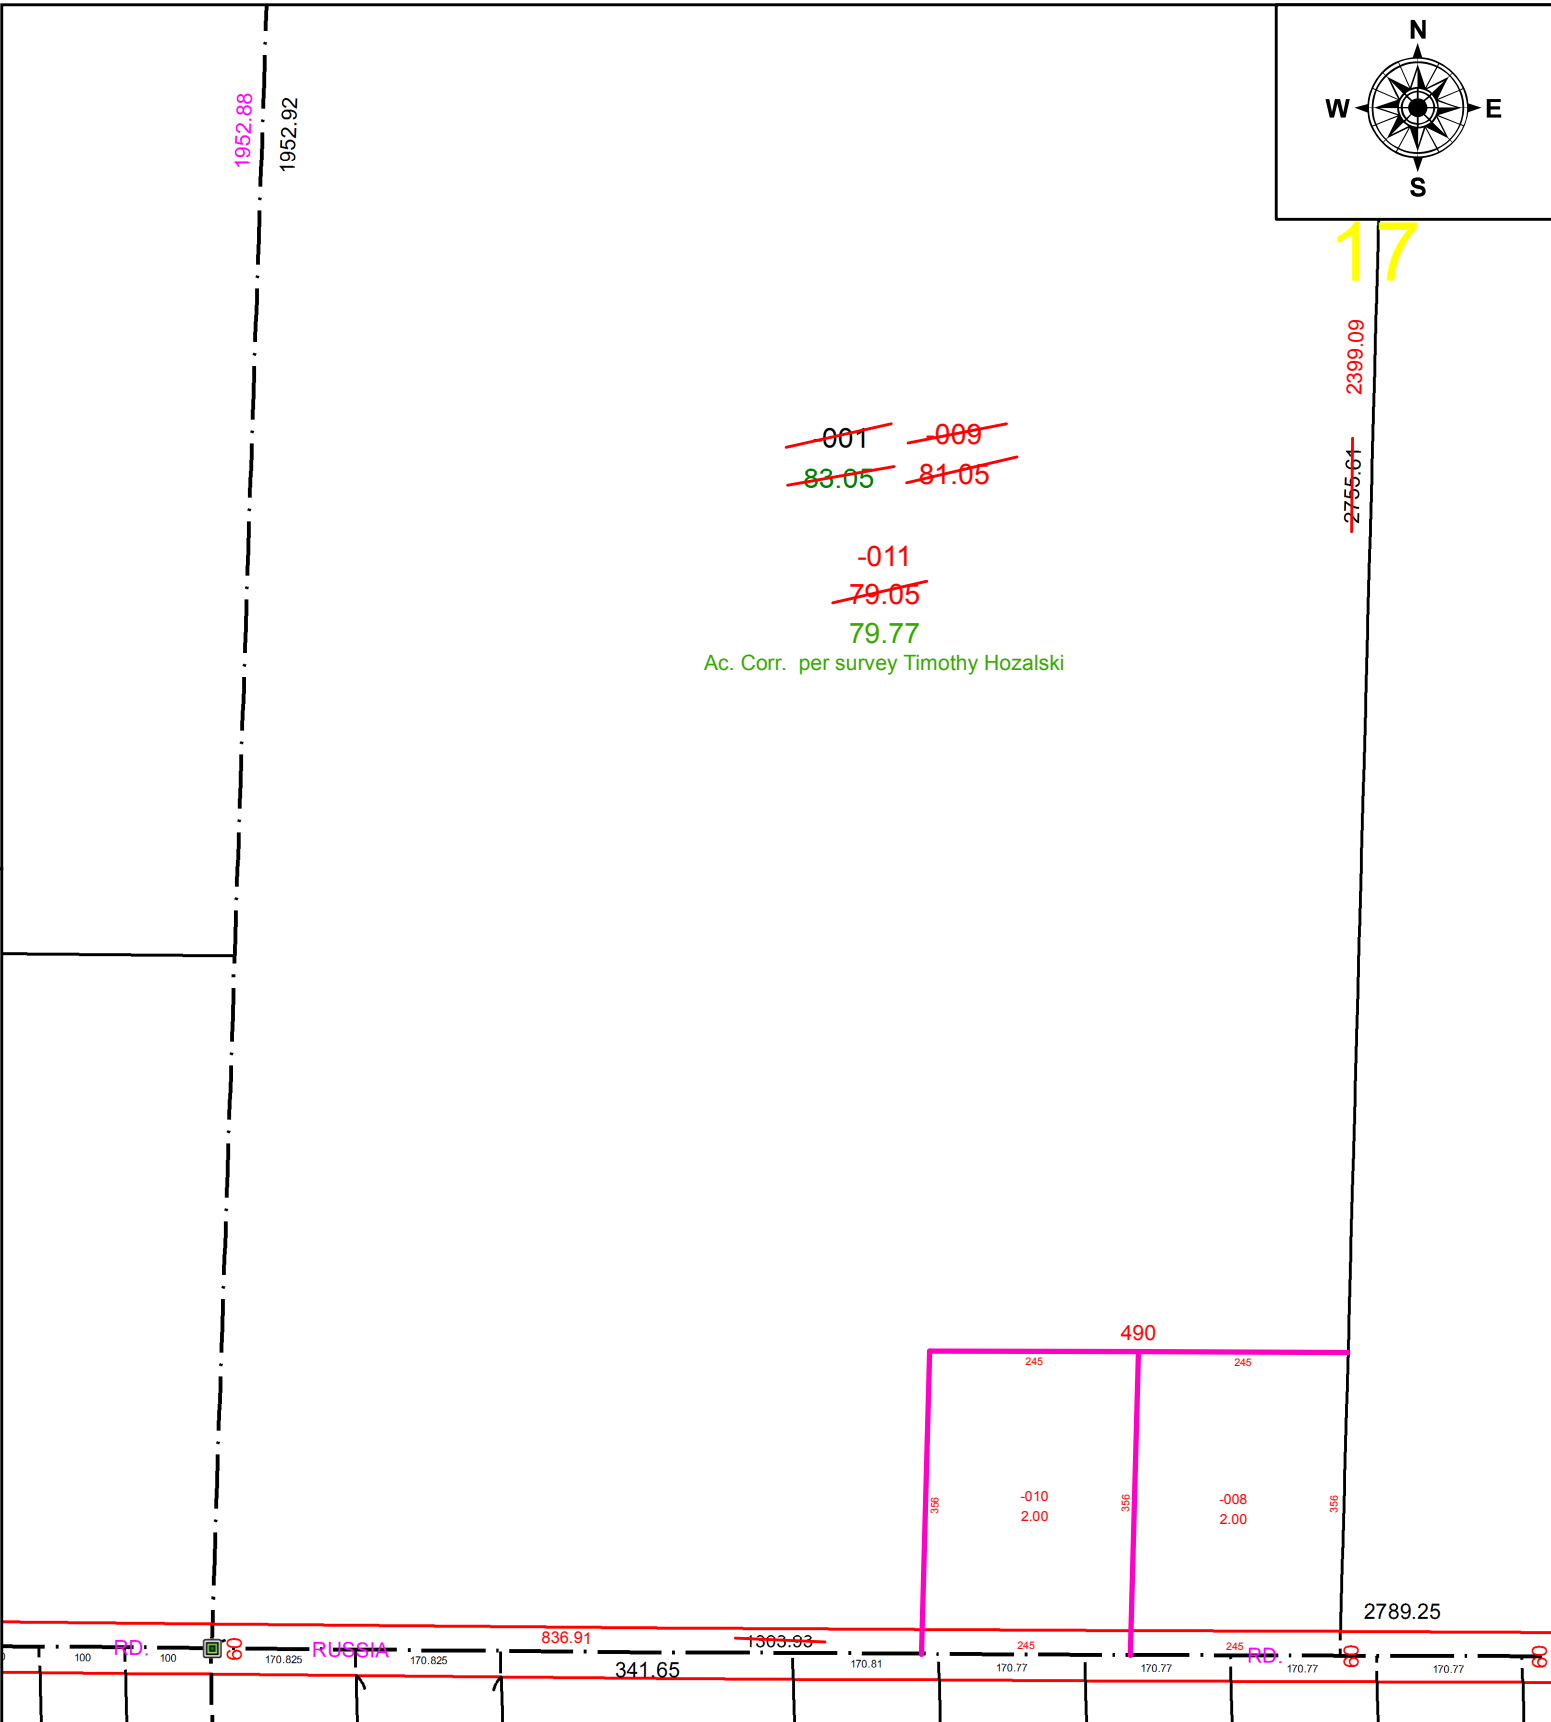

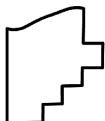
SPLITS/DEEDS PROCESSED
LORAIN COUNTY TAX MAP DEPARTMENT
226 MIDDLE AVE. ELYRIA, OH

SURVEYED BY: TIMOTHY HOZALSKI
CLOSURE: 1: 53,151
MAP PAGE(S): 09-00-007
APPROVED BY: DMA DATE: 11/10/2021
SCALE: 1" = 225' PRIOR INSTRUMENT: 20180670720