


PARENT PARCEL: ADD TO DUPLICATE

CHILD PARCEL: 04-00-011-101-123 PER DV264/610, 04-00-011-101-124 PER DV 264/609

20-04407-A

STARTING POINT: NORTH LINE OF O.L.11 & N.W. CORNER OF DAILEY, & N.W. CORNER OF HUBBARD

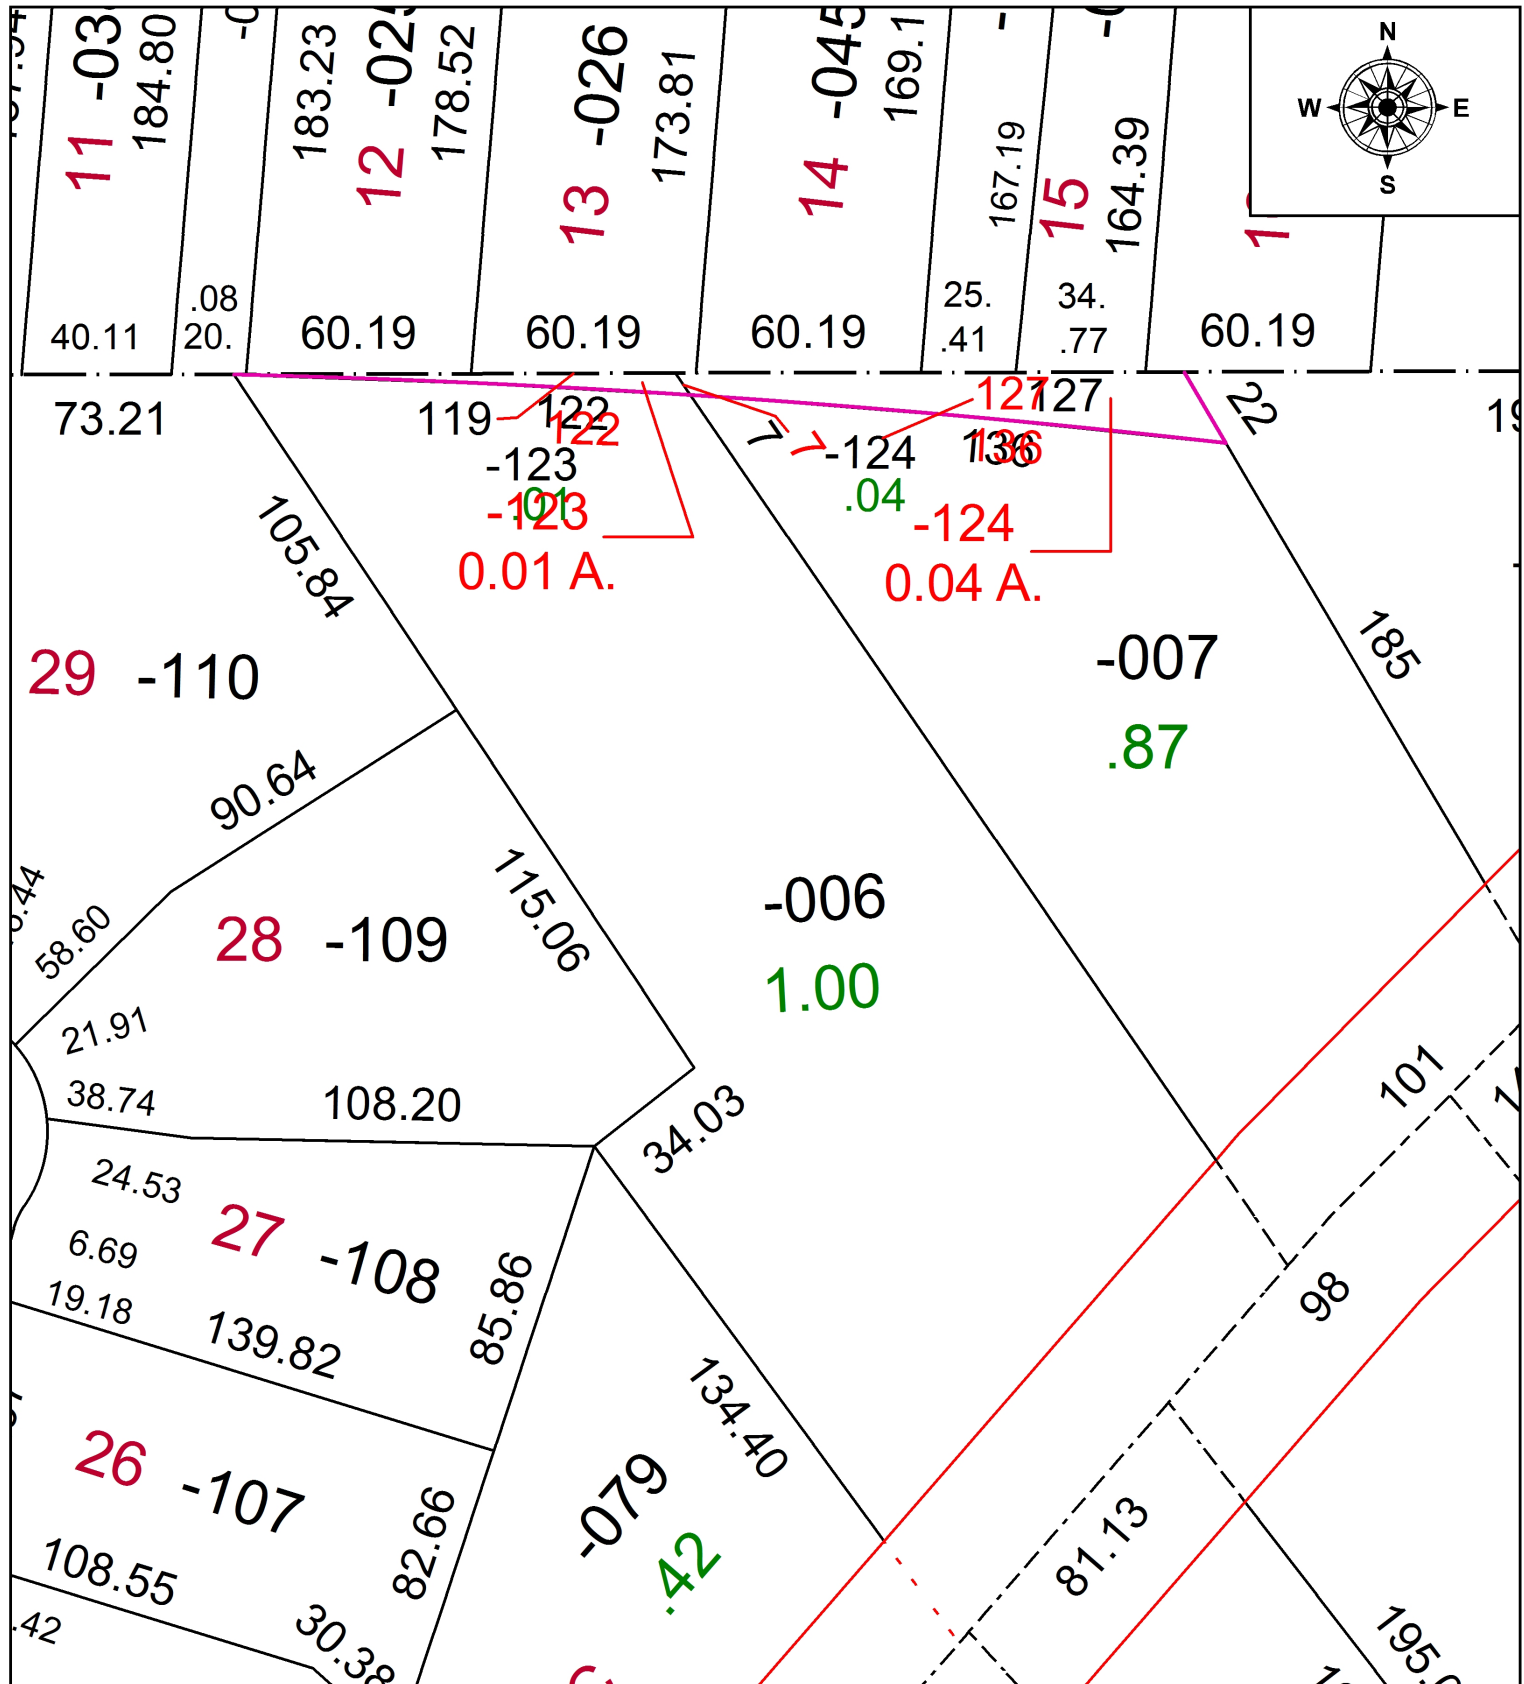

SPLITS/DEEDS PROCESSED
 LORAIN COUNTY TAX MAP DEPARTMENT
 226 MIDDLE AVE. ELYRIA, OH

SURVEYED BY:	NA
CLOSURE:	NA
MAP PAGE(S):	04-00-011
APPROVED BY:	TJS
DATE:	10/5/2020
SCALE:	1" = 60'
PRIOR INSTRUMENT:	DV XXXX/XXXX