
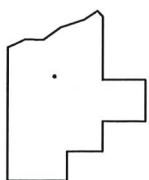


PARENT PARCEL: 04-00-017-118-007, 04-00-020-101-184 & -222
 CHILD PARCEL: 04-00-017-118-045 & -046, 04-00-020-101-223 thru -228
 STARTING POINT: I.P. MON BOX, CL OF LEGACY POINTE PKWY & CL OF LEGENDS RD.

21-04407

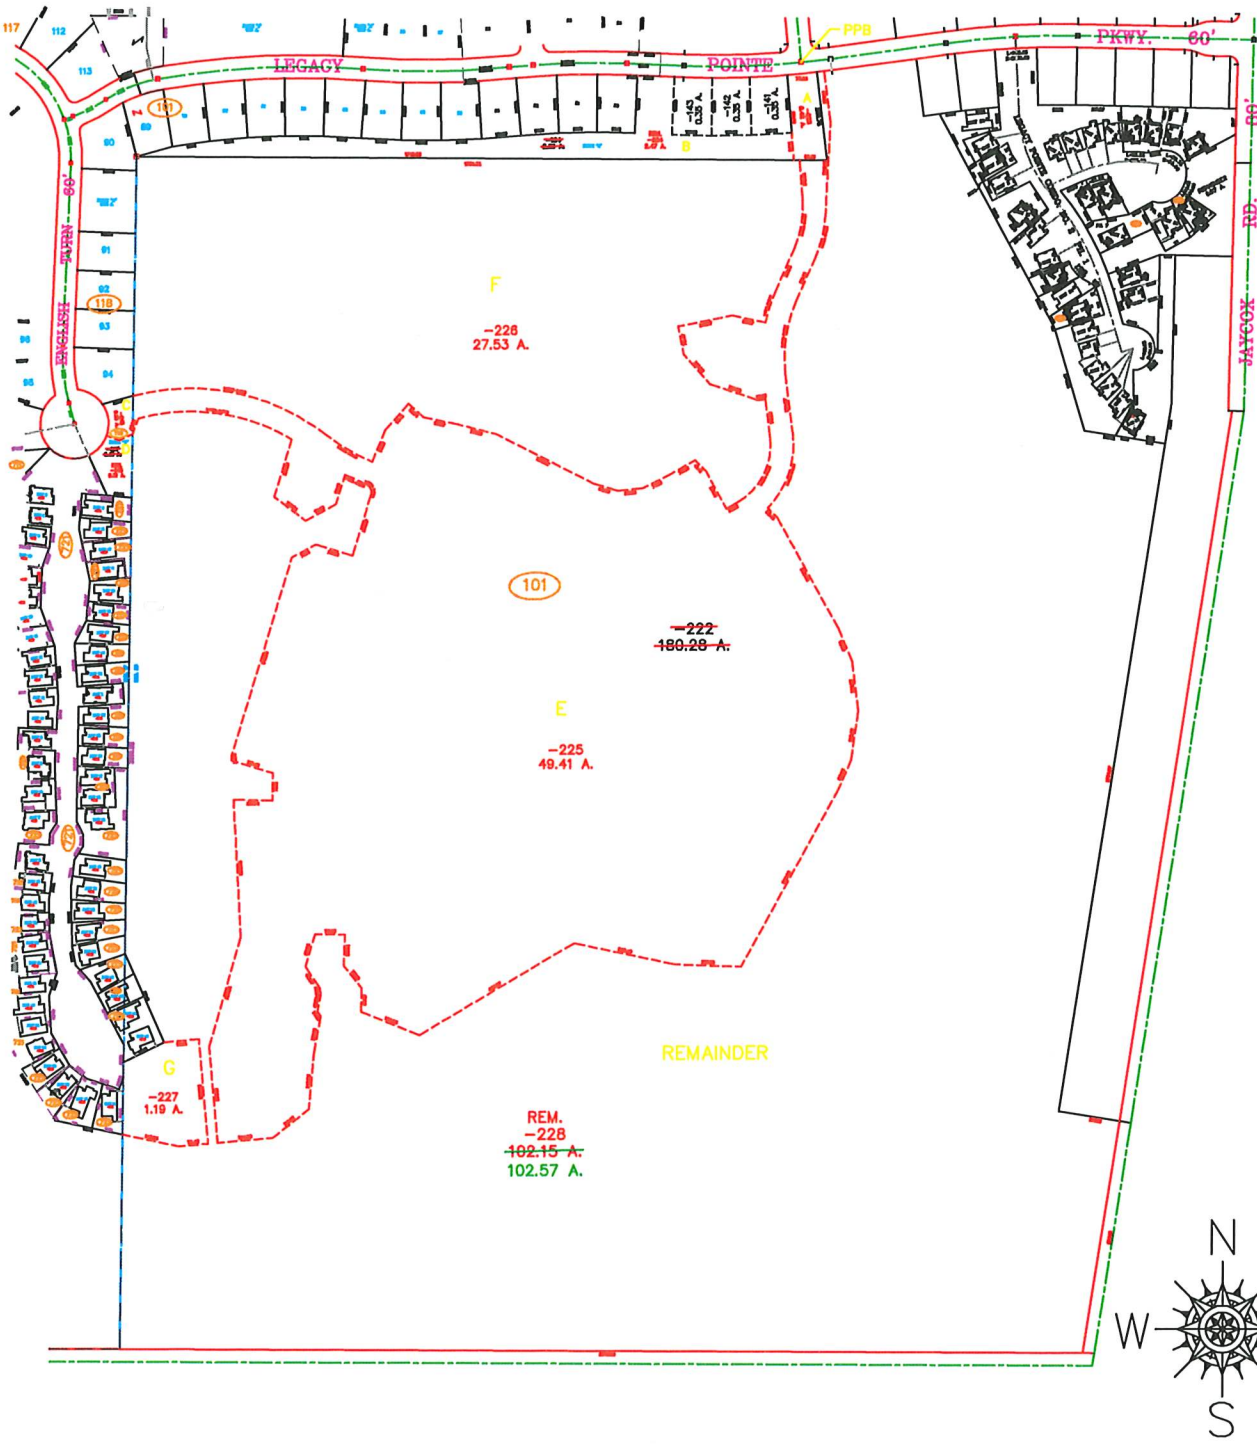

SPLITS/DEEDS PROCESSED
 LORAIN COUNTY TAX MAP DEPARTMENT
 226 MIDDLE AVE. ELYRIA, OHIO

SURVEYED BY: JAMES SAYLER
 CLOSURE: 0.01 : 10,000
 MAP PAGE(S): 04-00-017 & -020
 APPROVED BY: TJS DATE: 11/19/2021
 SCALE: 1" = 500' PRIOR INSTRUMENT: 2019-0742238