


PARENT PARCEL: 12-00-013-000-037

CHILD PARCEL:

STARTING POINT: INTERSECTIOIN OF C/L OF EMMONS RD. AND C/L OF BOONE RD.

20-04409-A

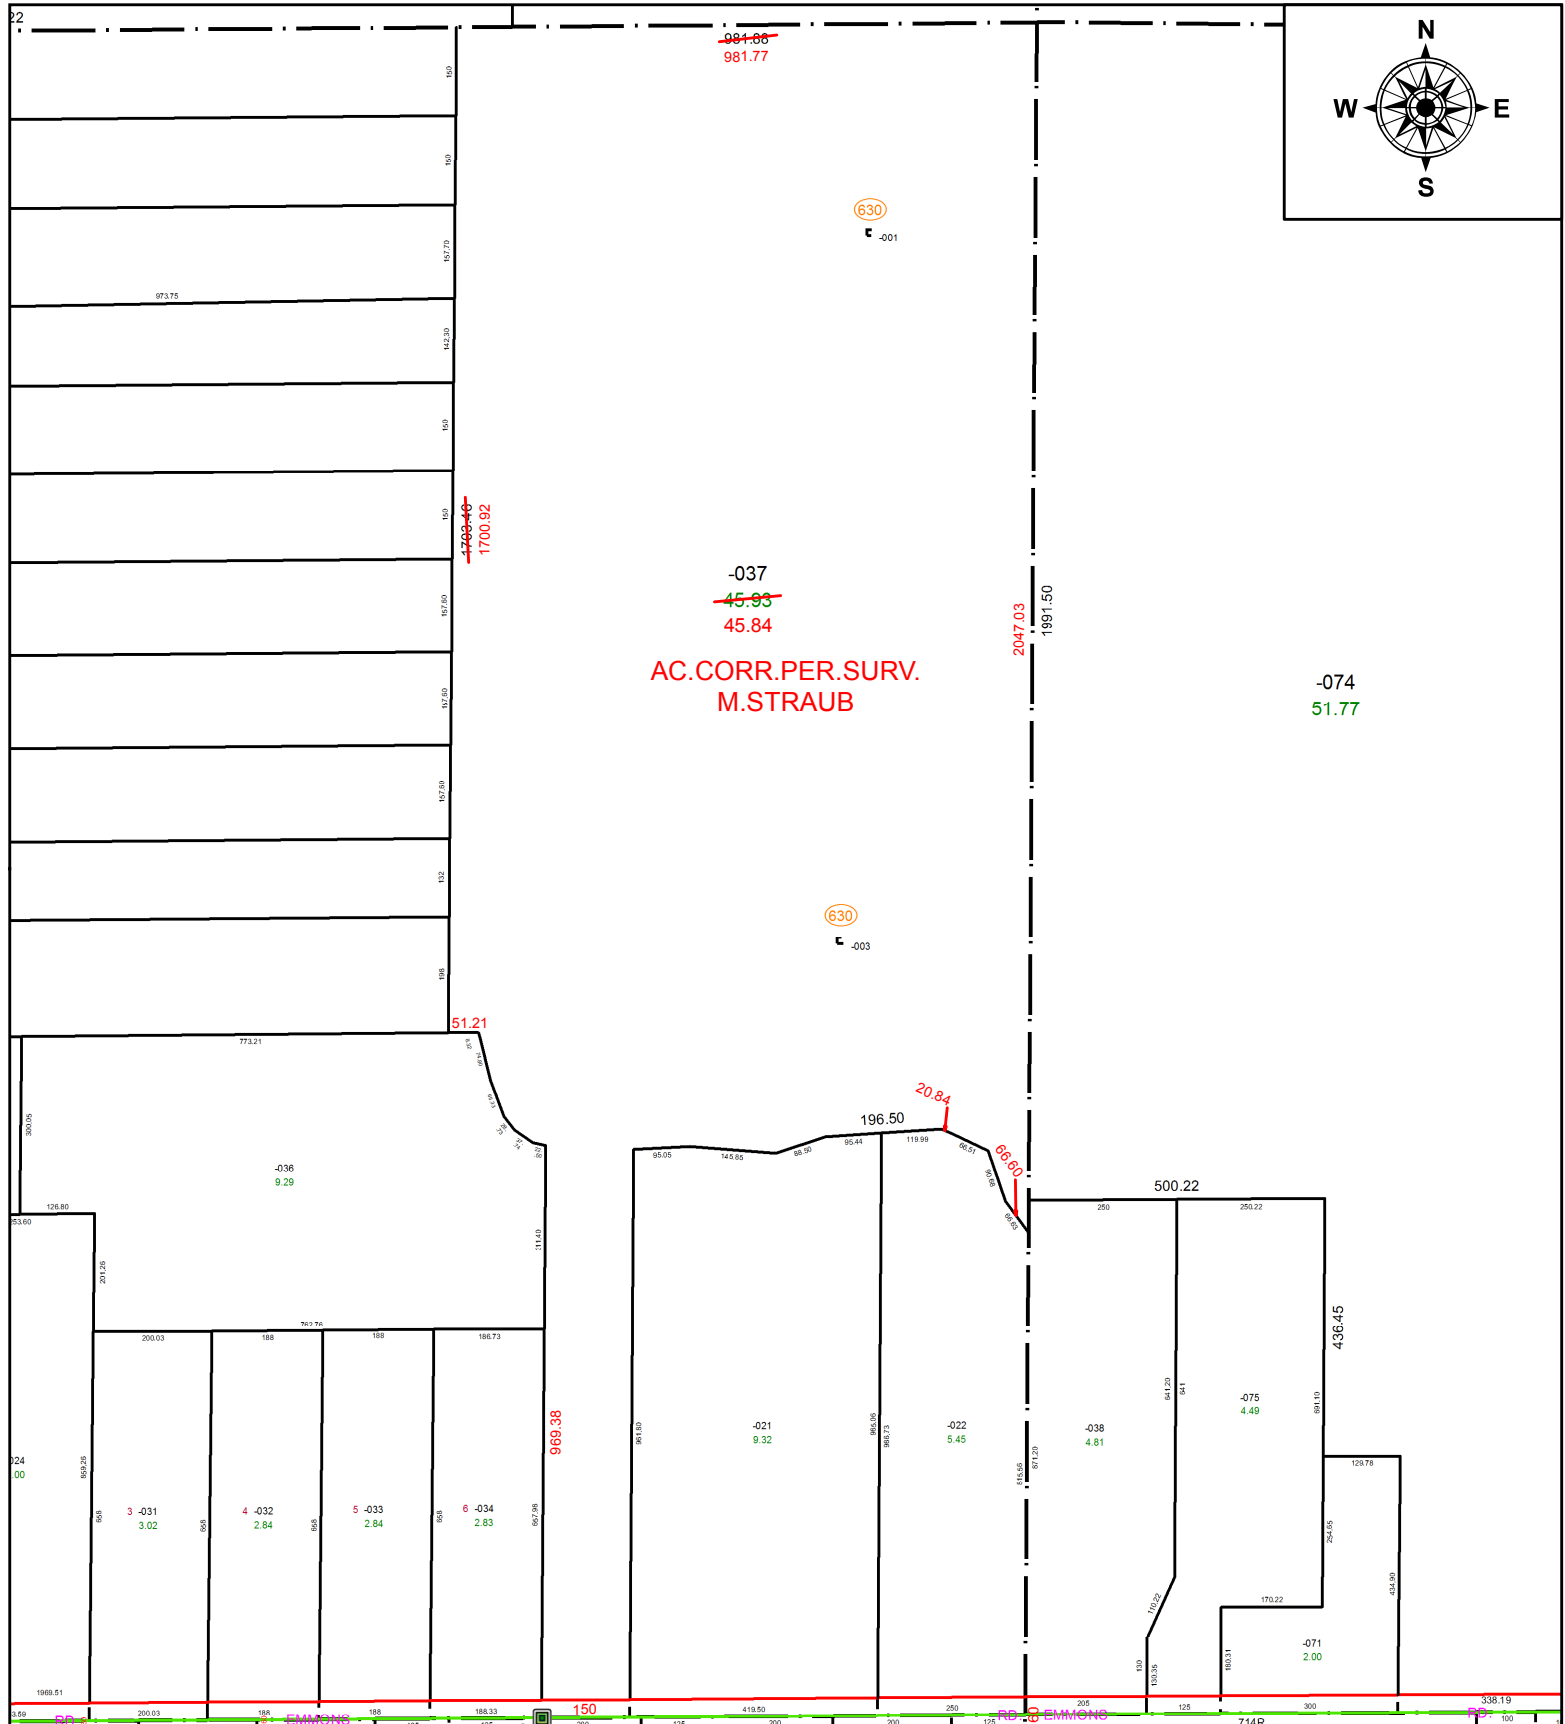

SPLITS/DEEDS PROCESSED
LORAIN COUNTY TAX MAP DEPARTMENT
226 MIDDLE AVE. ELYRIA, OH

SURVEYED BY: MICHAEL A. STRAUB

CLOSURE: 1:926,593

MAP PAGE(S): 12-00-013

APPROVED BY: RRM DATE: 10-20-20

SCALE: 1" = 325 PRIOR INSTRUMENT: 2020077734