
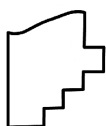


PARENT PARCEL: 05-00-024-106-005

CHILD PARCEL: 05-00-024-106-006 & -007

STARTING POINT: SOUTH LINE OF TENNY AVE. & EAST LINE OF CHURCH ST.

21-04409

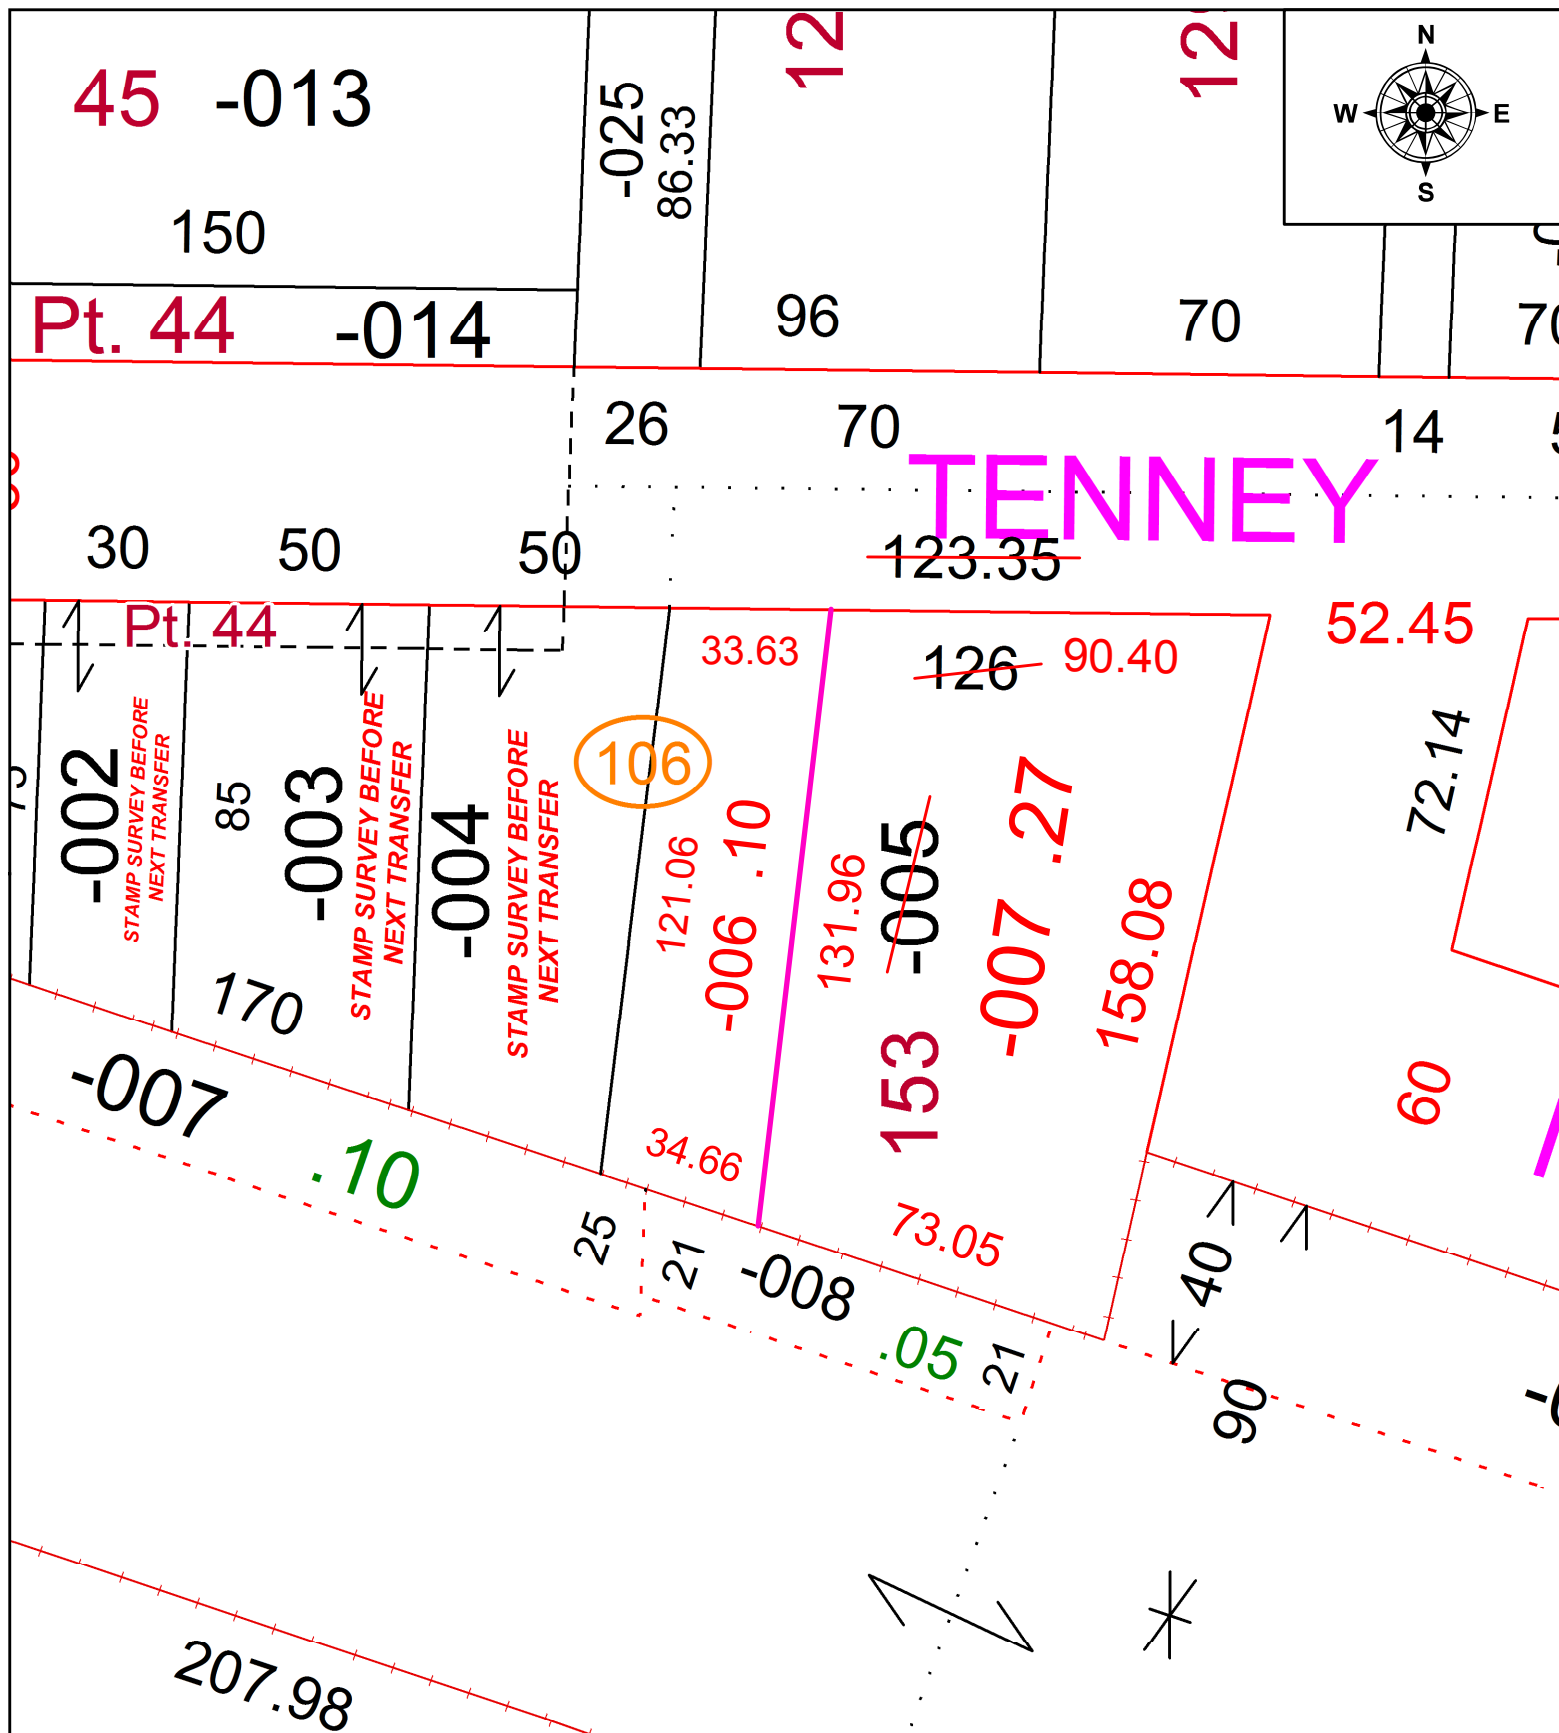

SPLITS/DEEDS PROCESSED
 LORAIN COUNTY TAX MAP DEPARTMENT
 226 MIDDLE AVE. ELYRIA, OH

SURVEYED BY: PATRICK MCGANNON
 CLOSURE: 1: 54,408
 MAP PAGE(S): 05-00-024
 APPROVED BY: DMA DATE: 11/15/2021
 SCALE: 1" = 40' PRIOR INSTRUMENT: 20210799588