
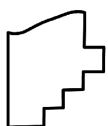


PARENT PARCEL: 21-07-000-000-033

CHILD PARCEL: 21-07-000-000-037 & -038

STARTING POINT: CL OF BURSLEY RD. & HAWLEY RD.

21-04410

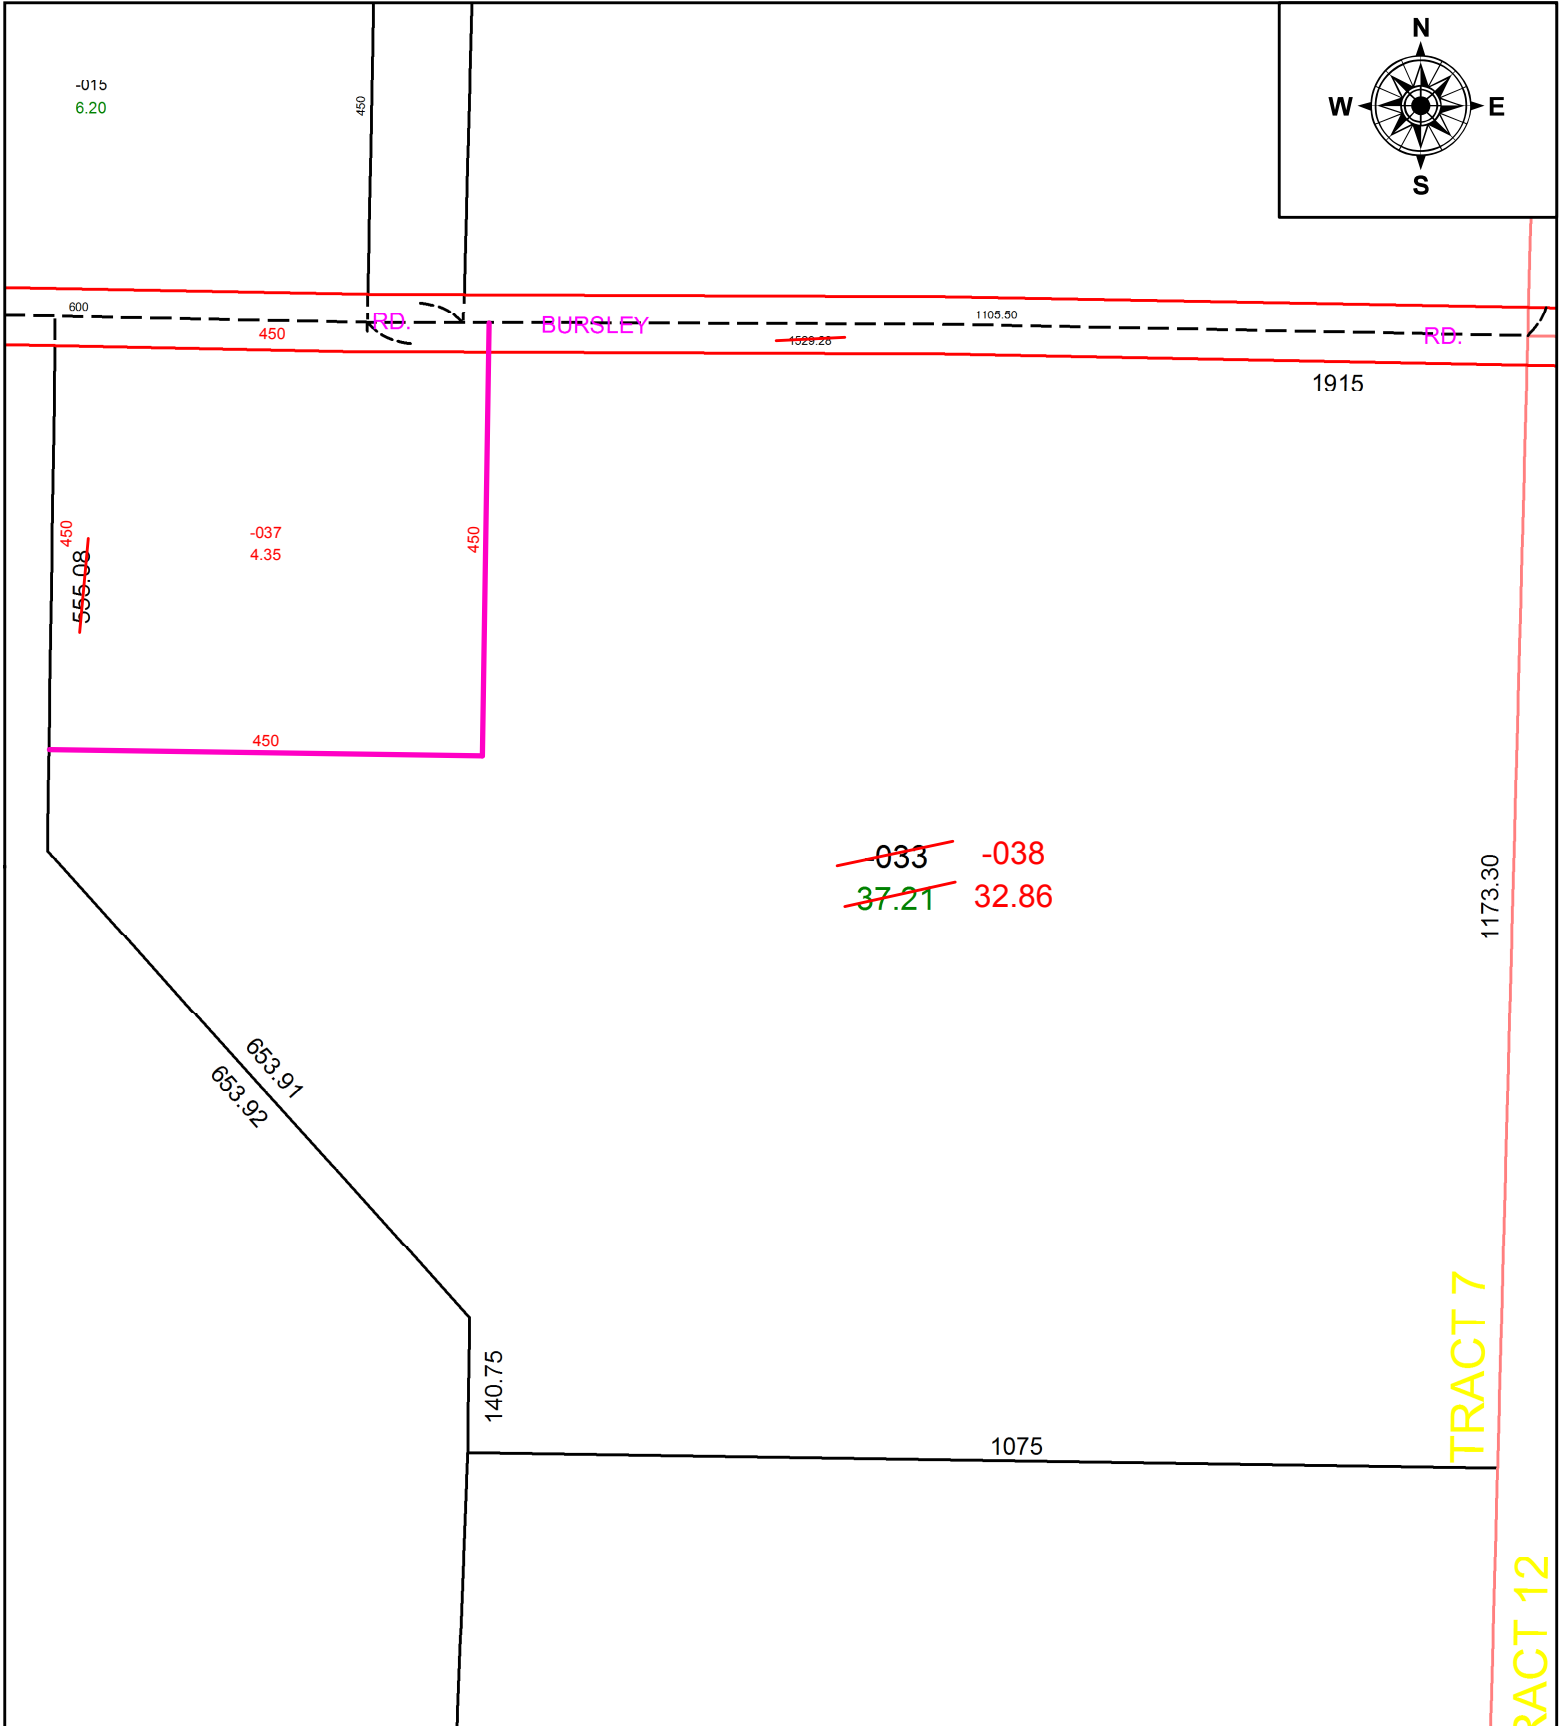

SPLITS/DEEDS PROCESSED
 LORAIN COUNTY TAX MAP DEPARTMENT
 226 MIDDLE AVE. ELYRIA, OH

SURVEYED BY: WILFREDO BARBOSA

CLOSURE: 1: 2147483648

MAP PAGE(S): 21-07-000

APPROVED BY: DMA DATE: 11/16/2021

SCALE: 1" = 200' PRIOR INSTRUMENT: 20190727688