
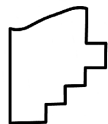


PARENT PARCEL: 06-23-007-000-018

CHILD PARCEL:

STARTING POINT: INTERSECTION OF C/L OF MURRAY RIDGE RD, AND C/L OF GRISWOLD RD,

20-04413-C

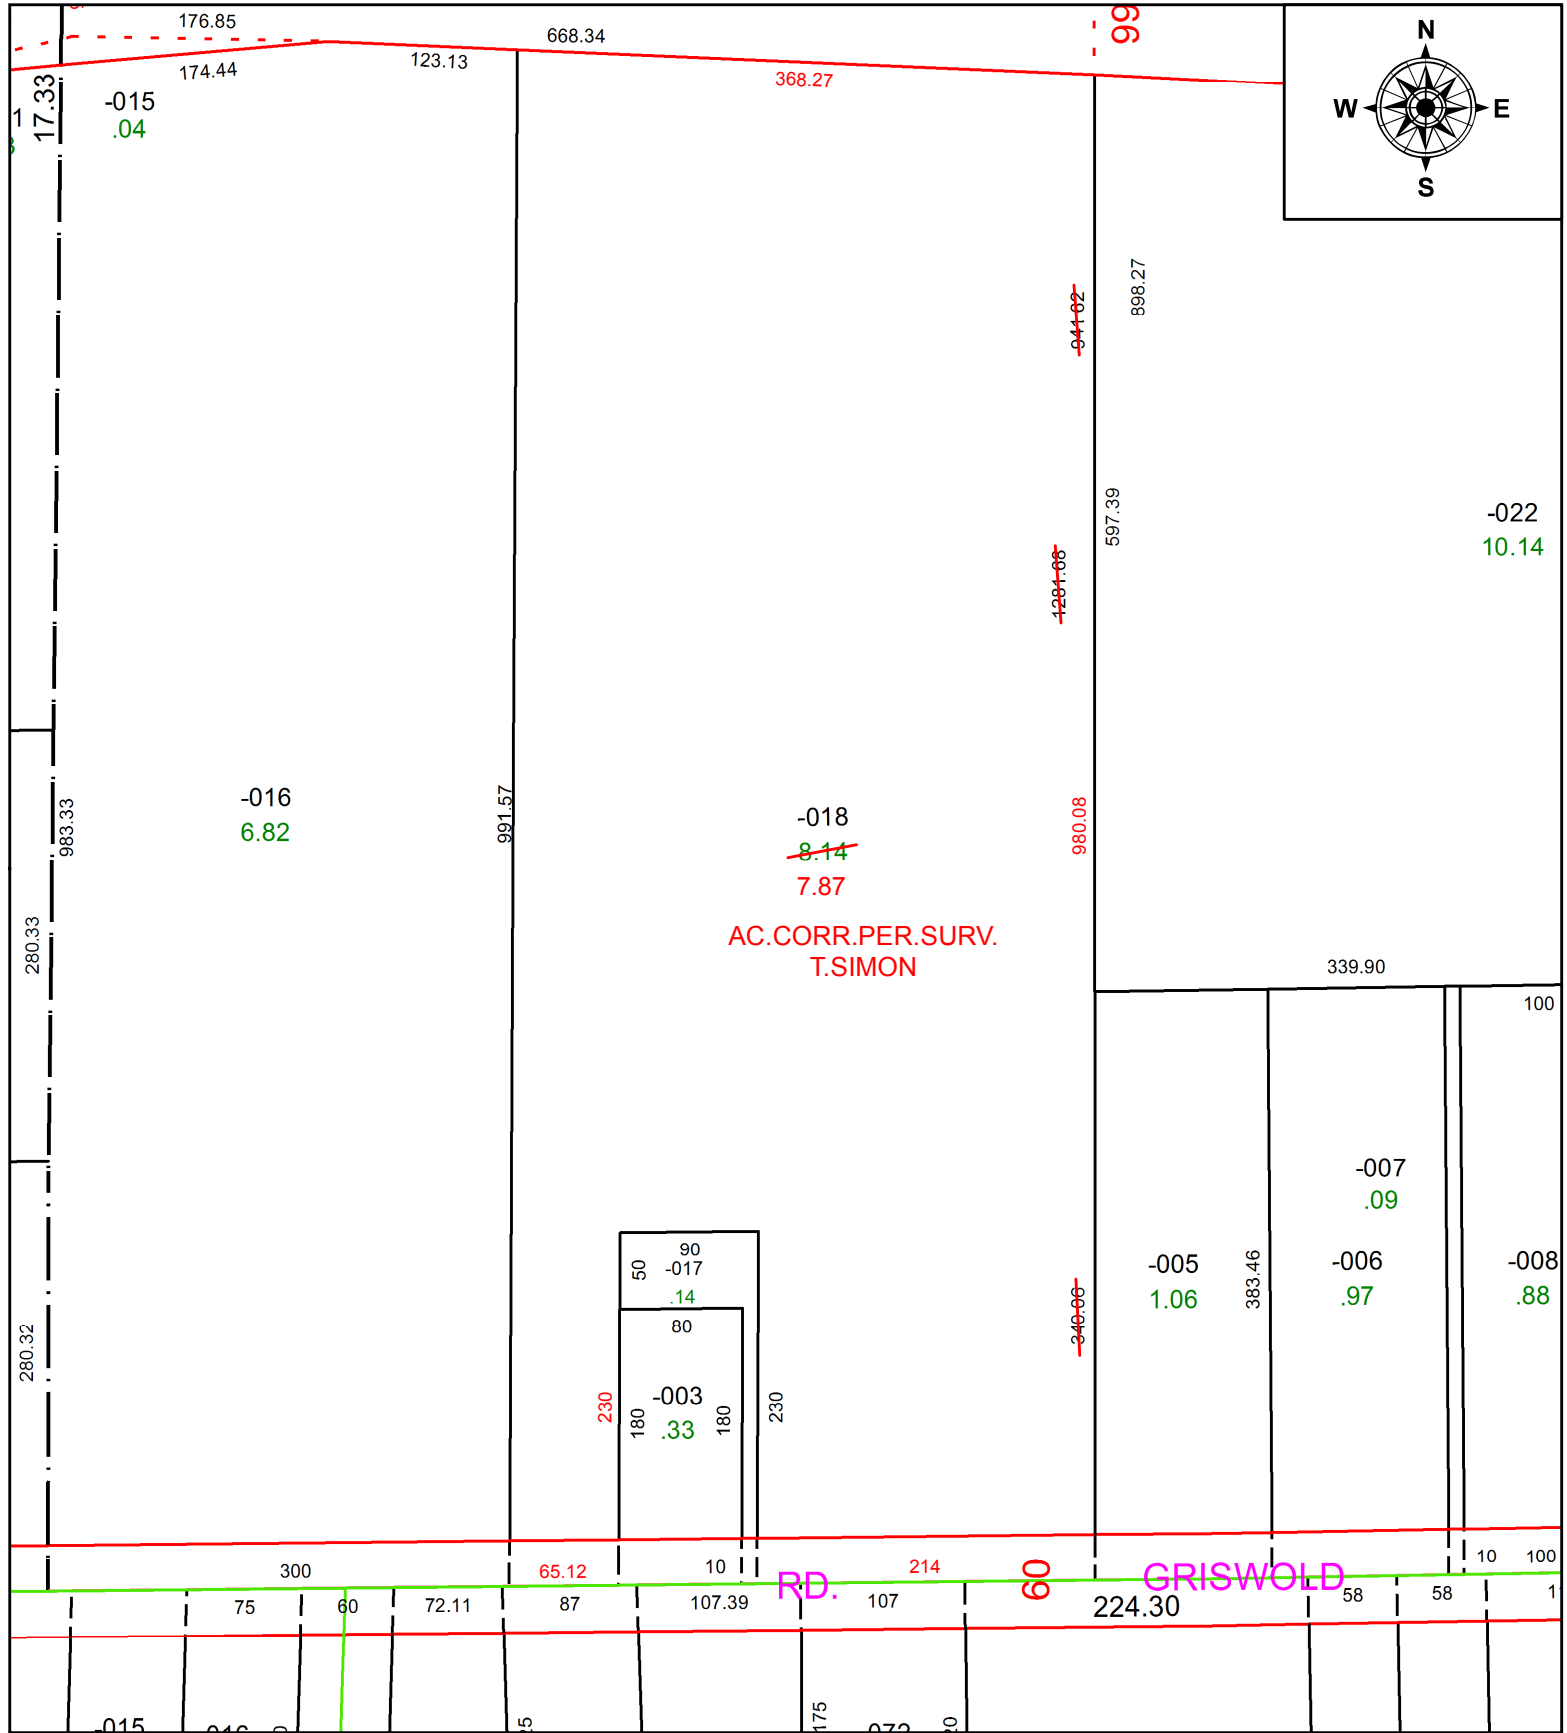

**SPLITS/DEEDS PROCESSED**  
 LORAIN COUNTY TAX MAP DEPARTMENT  
 226 MIDDLE AVE. ELYRIA, OH

SURVEYED BY: THOMAS A. SIMON  
 CLOSURE: 1:785,154  
 MAP PAGE(S): 6-23-007  
 APPROVED BY: RRM DATE: 10-9-20  
 SCALE: 1" = 125 PRIOR INSTRUMENT: 20190718740