


PARENT PARCEL: 03-00-047-108-016, -017, -018

CHILD PARCEL: 03-00-047-108-032, -033, -034

STARTING POINT: WEST LINE OF CONCORD DRIVE AND NE CORNER OF S/L 55

21-04416

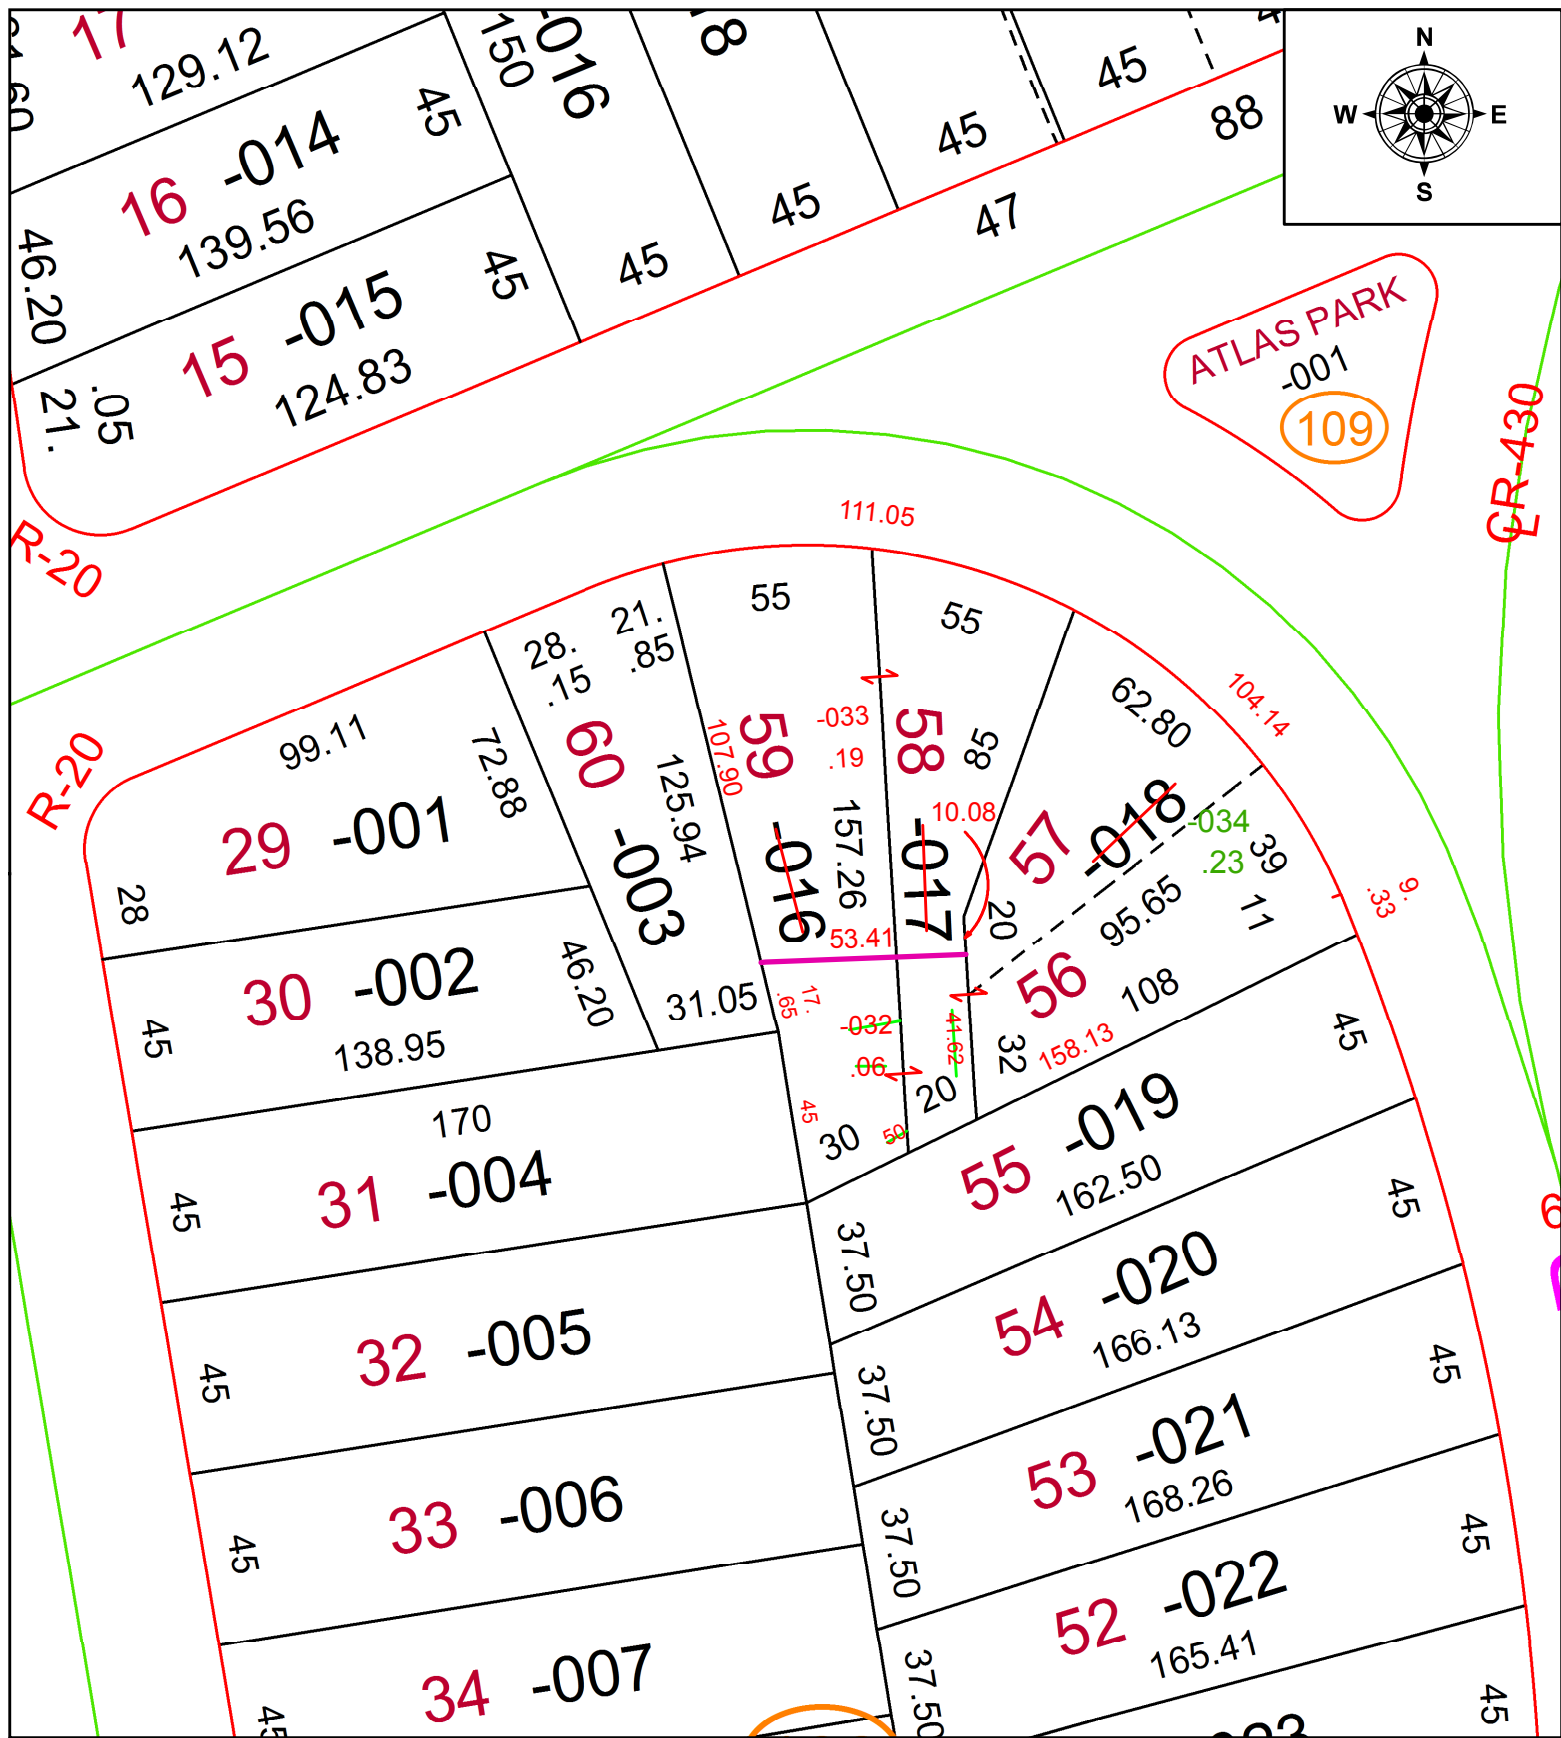

SPLITS/DEEDS PROCESSED
 LORAIN COUNTY TAX MAP DEPARTMENT
 226 MIDDLE AVE. ELYRIA, OH

SURVEYED BY:	JOHN A. DECHANT JR
CLOSURE:	1: 35644
MAP PAGE(S):	03-00-047-A
APPROVED BY:	AC DATE: 12/6/2021
SCALE:	1" = 50 PRIOR INSTRUMENT: 2019- 0740080