
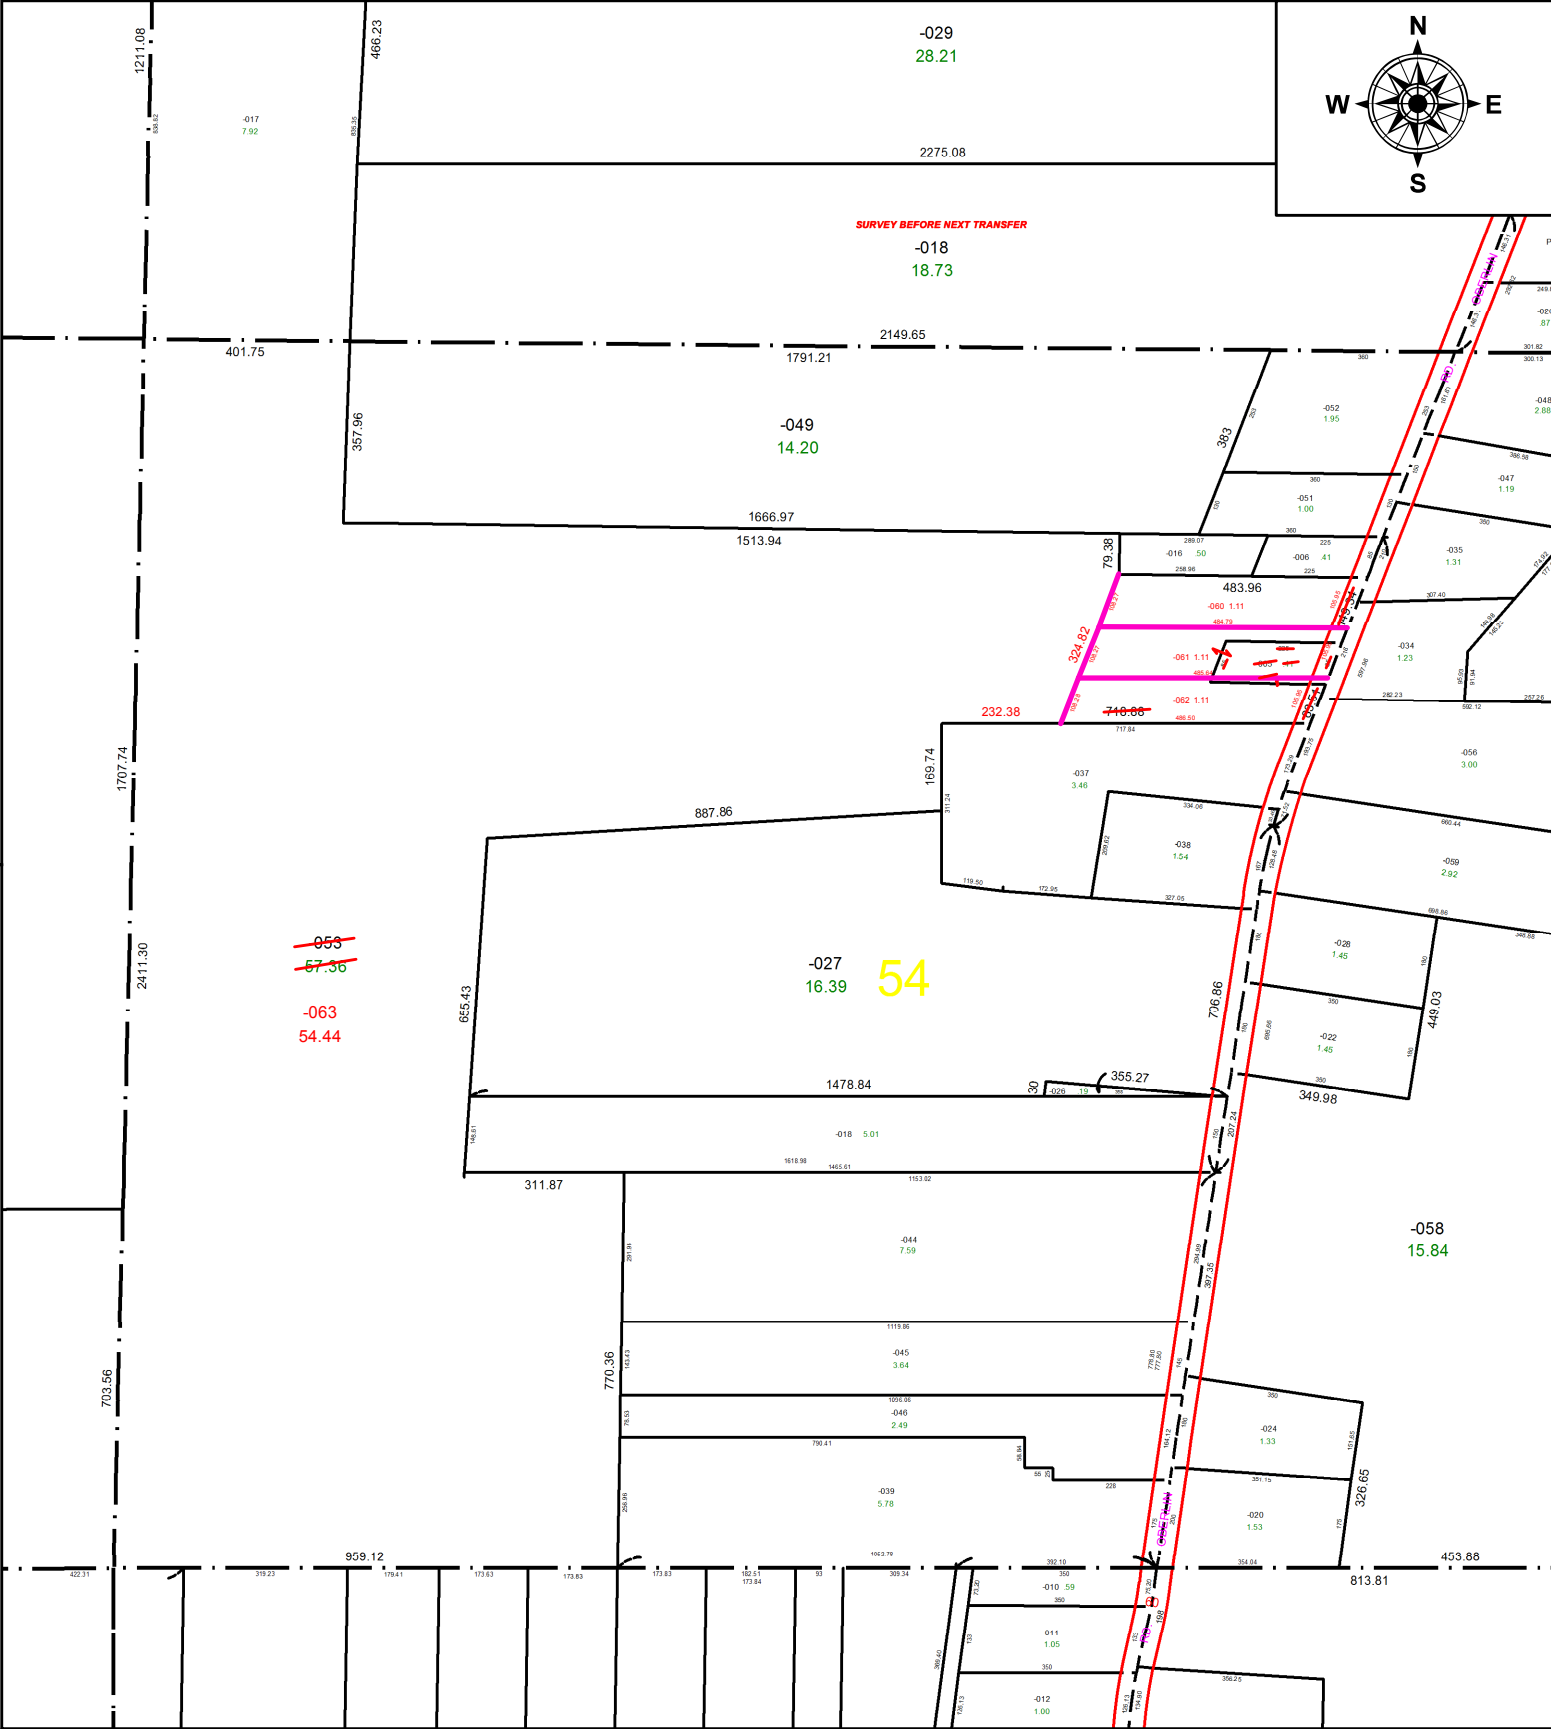


PARENT PARCEL: 05-00-054-000-005 & -053

CHILD PARCEL: 05-00-054-000-060 THRU -063


STARTING POINT: S.W. CORNER OF ORIGINAL LOT 55 AMHERST TWP.

21-04419

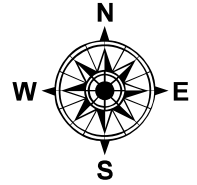

~~053~~
~~57.36~~
-063
54.44

54

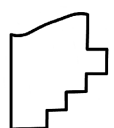

SPLITS/DEEDS PROCESSED
LORAIN COUNTY TAX MAP DEPARTMENT
226 MIDDLE AVE. ELYRIA, OH

SURVEYED BY: AMY KELLY
CLOSURE: 1: 286,171
MAP PAGE(S): 05-00-054
APPROVED BY: DMA DATE: 12/13/2021
SCALE: 1" = 375' PRIOR INSTRUMENT: 2021-0820615