
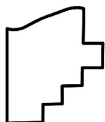


PARENT PARCEL: 03-00-072-000-035, 03-00-012-000-199, 03-00-073-000-070, & 03-00-011-101-015

CHILD PARCEL: 03-00-072-000-041, -042, 03-00-012-000-200, -201, -202, 03-00-011-101-016, -017

STARTING POINT: INTERSECTION OF C/L OF NORTH RIDGE RD & O.L.S 11 & 73

21-04420

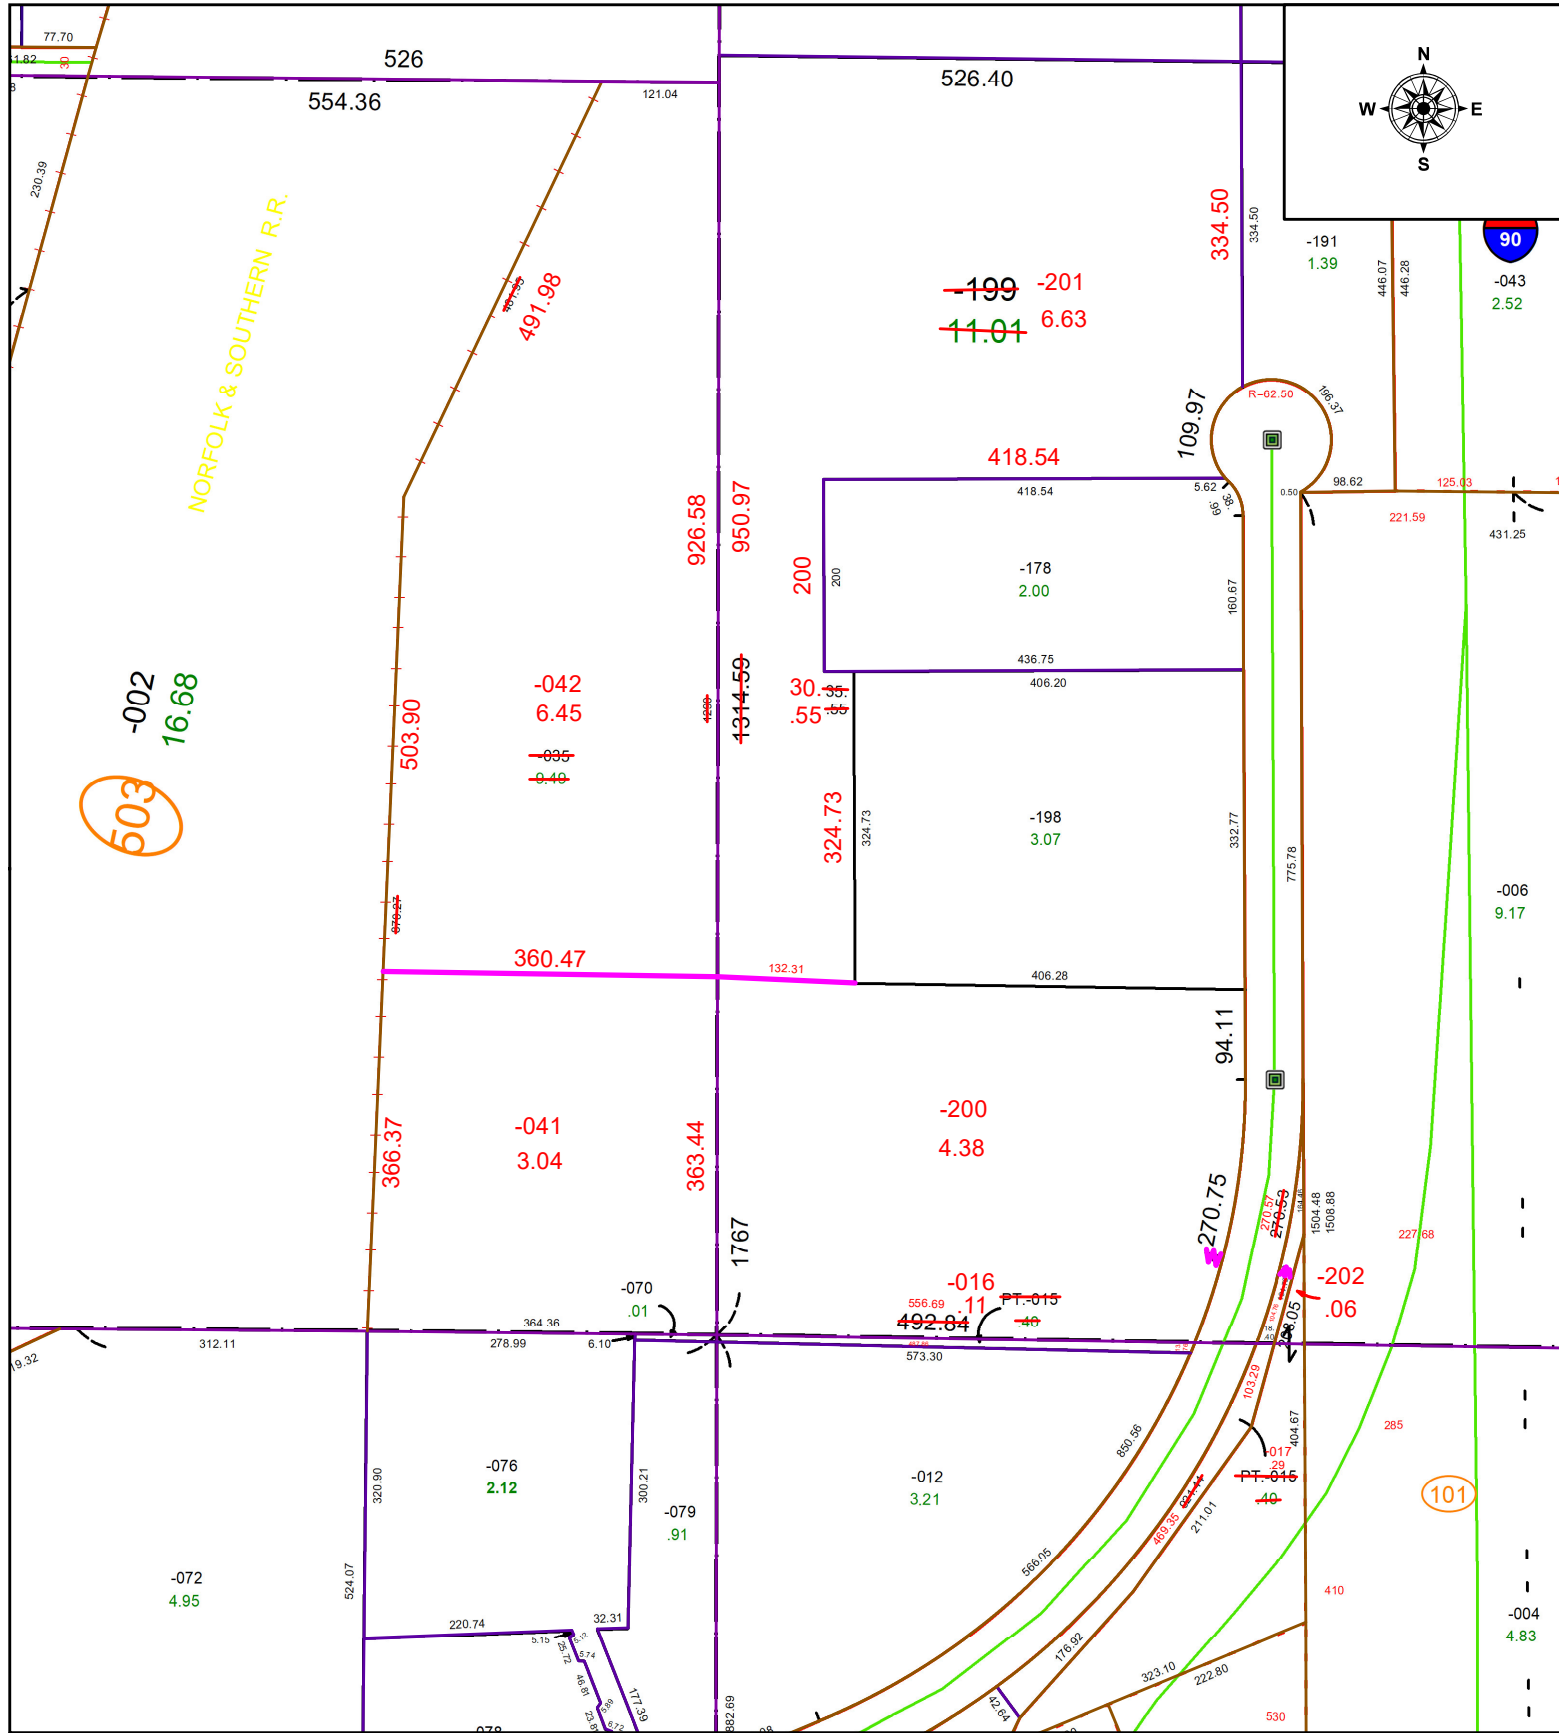

SPLITS/DEEDS PROCESSED
 LORAIN COUNTY TAX MAP DEPARTMENT
 226 MIDDLE AVE. ELYRIA, OH

SURVEYED BY: AMY M. KELLY
CLOSURE: 1: 88,366
MAP PAGE(S): 03-00-072
APPROVED BY: WRZ **DATE:** 12/21/2021
SCALE: 1" = 200 **PRIOR INSTRUMENT:** 2021-0845403