
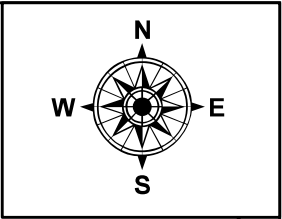


PARENT PARCEL: 01-00-066-000-036

CHILD PARCEL: 01-00-066-000-037 & -038

STARTING POINT: C/L OF GORE ORPHANAGE RD AND NORTH LINE OF OL 66

21-04425

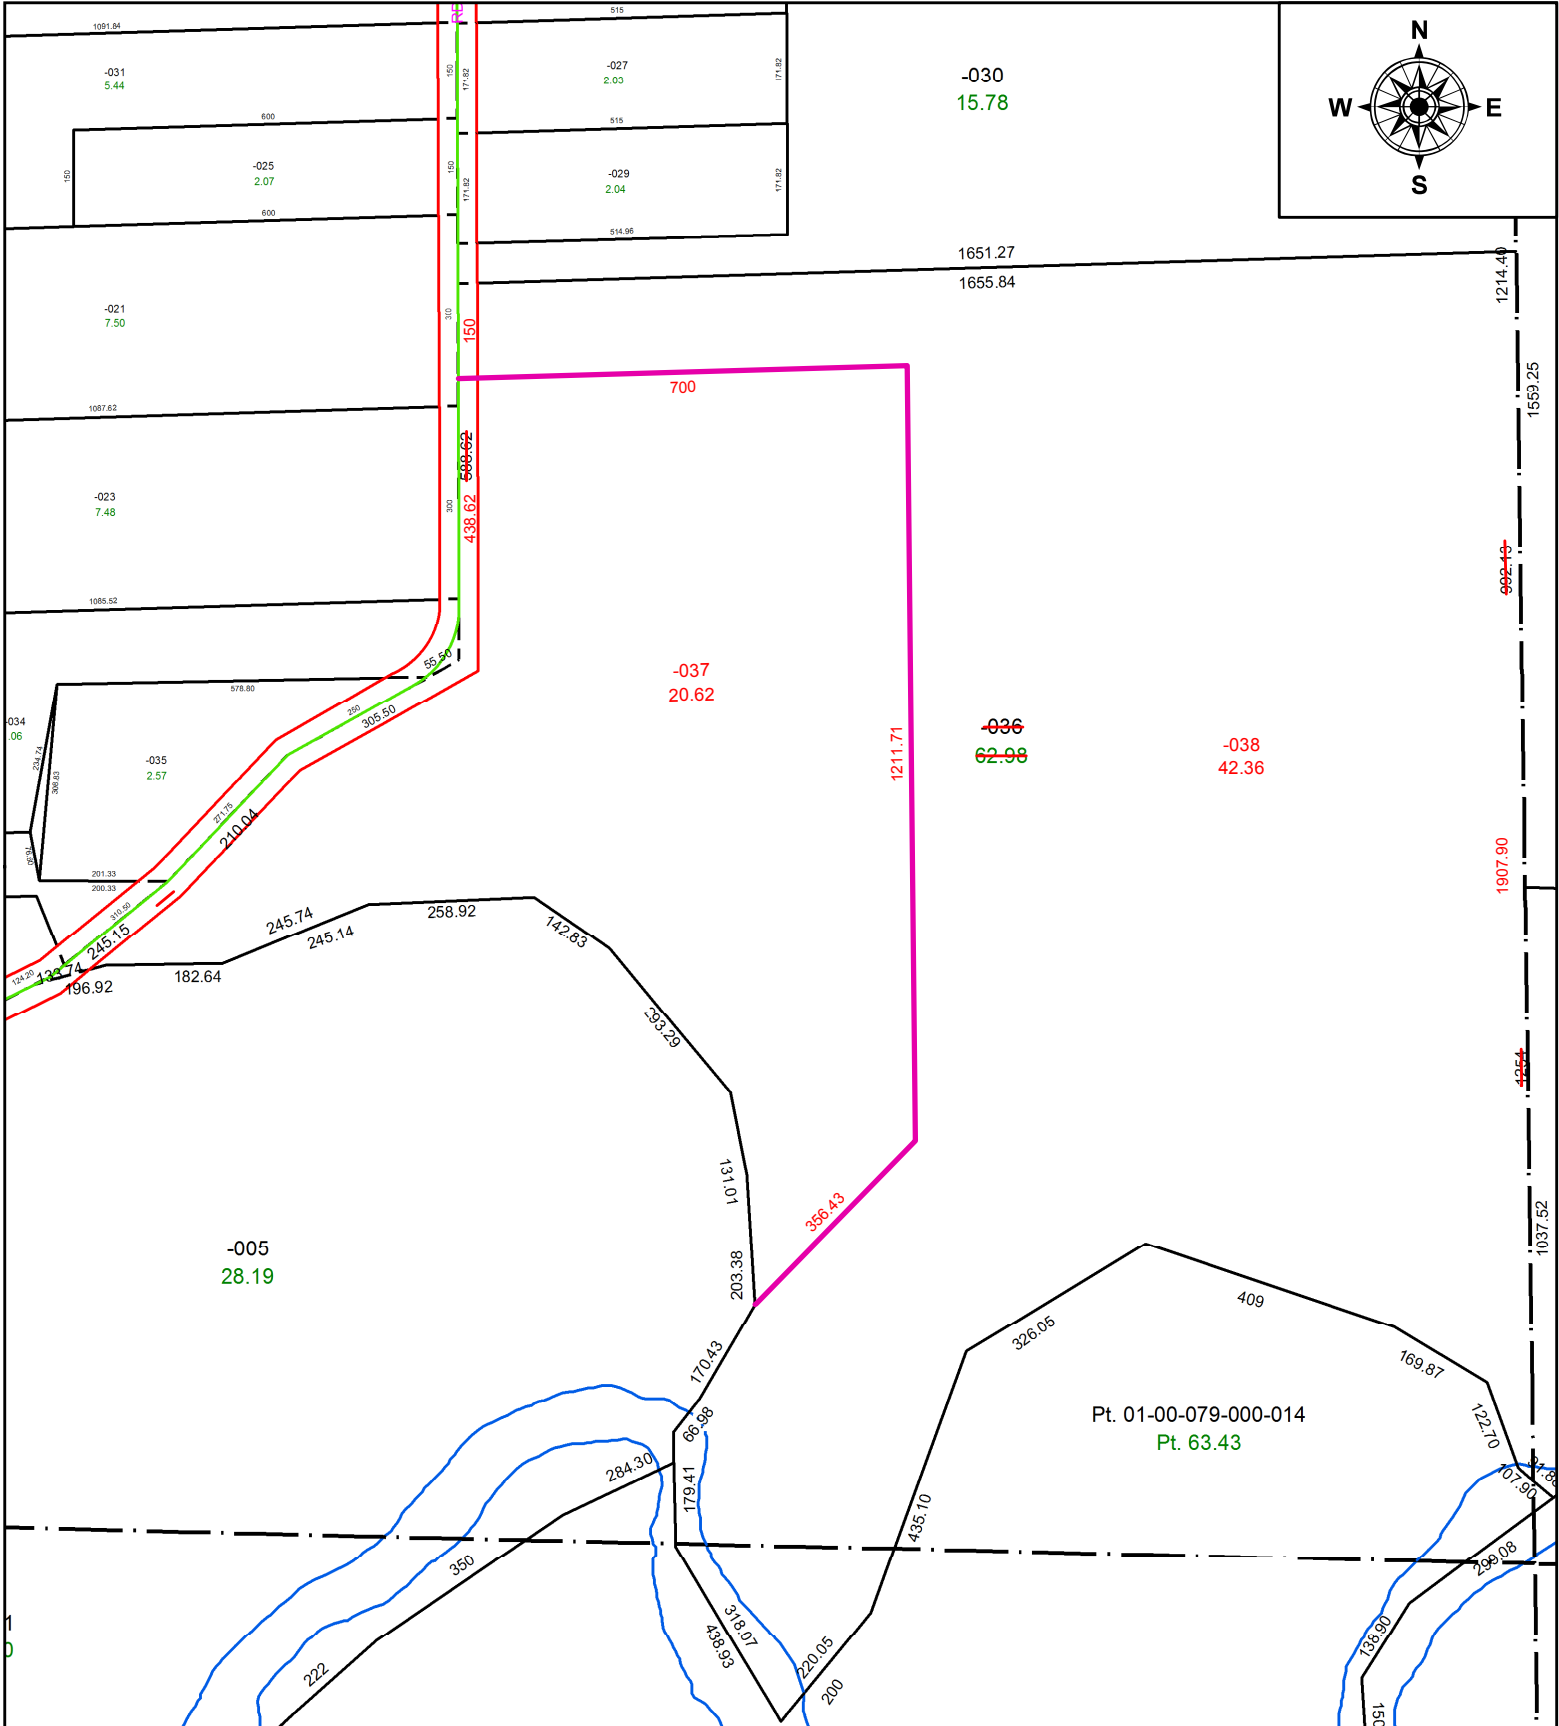

**SPLITS/DEEDS PROCESSED**  
 LORAIN COUNTY TAX MAP DEPARTMENT  
 226 MIDDLE AVE. ELYRIA, OH

**SURVEYED BY:** JOHN A. DECHANT JR.  
**CLOSURE:** 1: 1044465  
**MAP PAGE(S):** 01-00-066  
**APPROVED BY:** AC **DATE:** 1/3/2022  
**SCALE:** 1" = 300 **PRIOR INSTRUMENT:** 2021- 0854967