
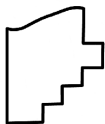


PARENT PARCEL: 02-01-008-101-202

CHILD PARCEL:

STARTING POINT: NORTHWEST CORNER OF O.L.8

20-04427-C

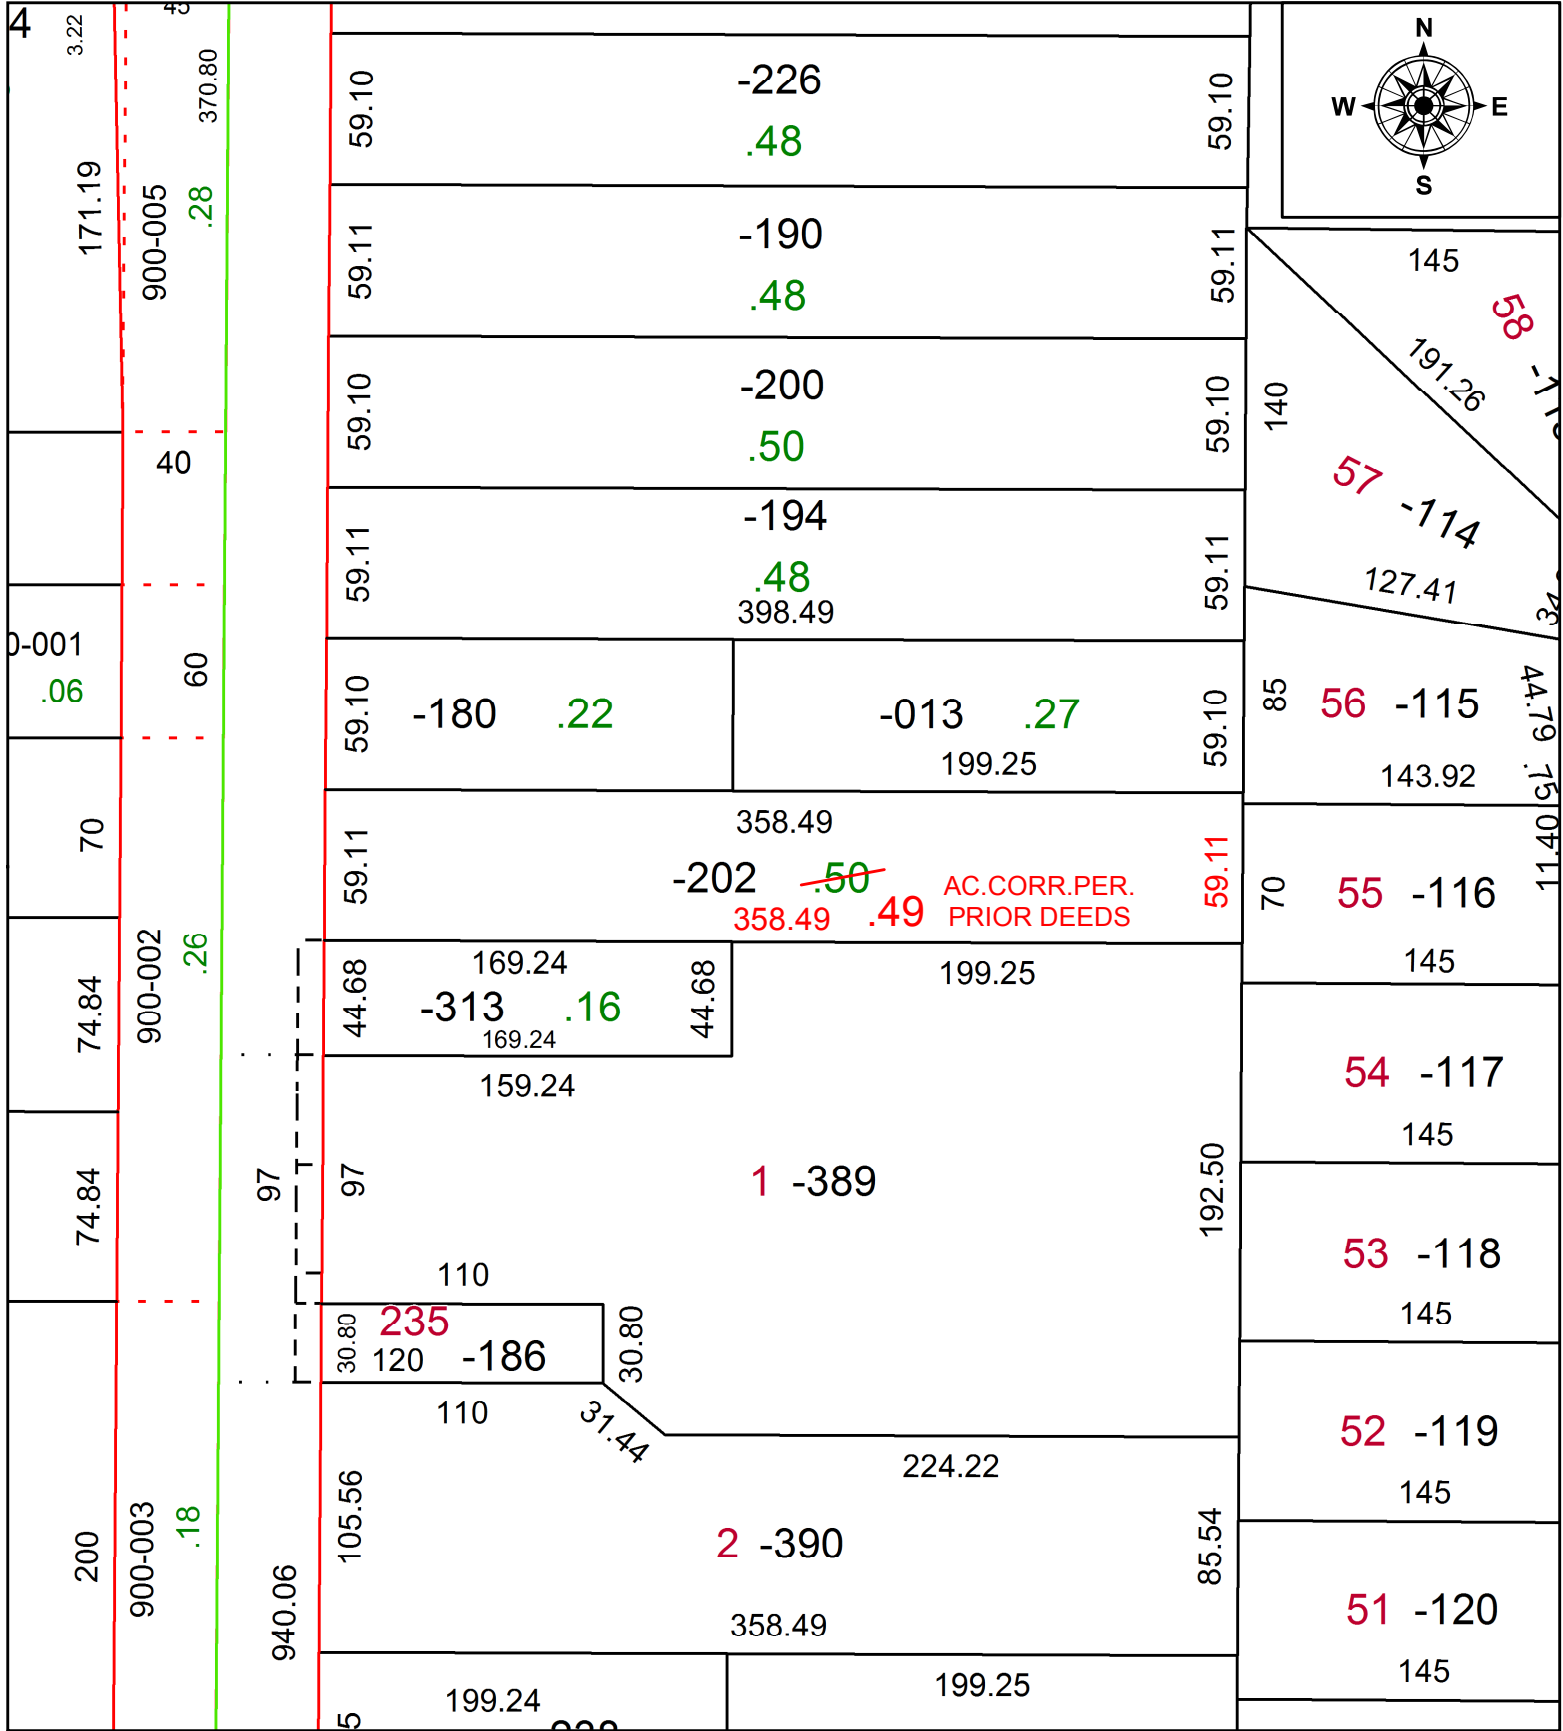

**SPLITS/DEEDS PROCESSED**  
 LORAIN COUNTY TAX MAP DEPARTMENT  
 226 MIDDLE AVE. ELYRIA, OH

SURVEYED BY: \_\_\_\_\_ N/A  
 CLOSURE: \_\_\_\_\_ N/A  
 MAP PAGE(S): \_\_\_\_\_ 2-01-008  
 APPROVED BY: \_\_\_\_\_ RRM DATE: \_\_\_\_\_ 10-30-20  
 SCALE: \_\_\_\_\_ 1" = 75 PRIORITY INSTRUMENT: \_\_\_\_\_ 20090287719