
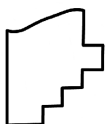


PARENT PARCEL: 06-26-020-000-008, -009

CHILD PARCEL: 06-26-020-000-012

STARTING POINT: E LINE OF EAST AVE AND S LINE OF O/L 20

22-04427

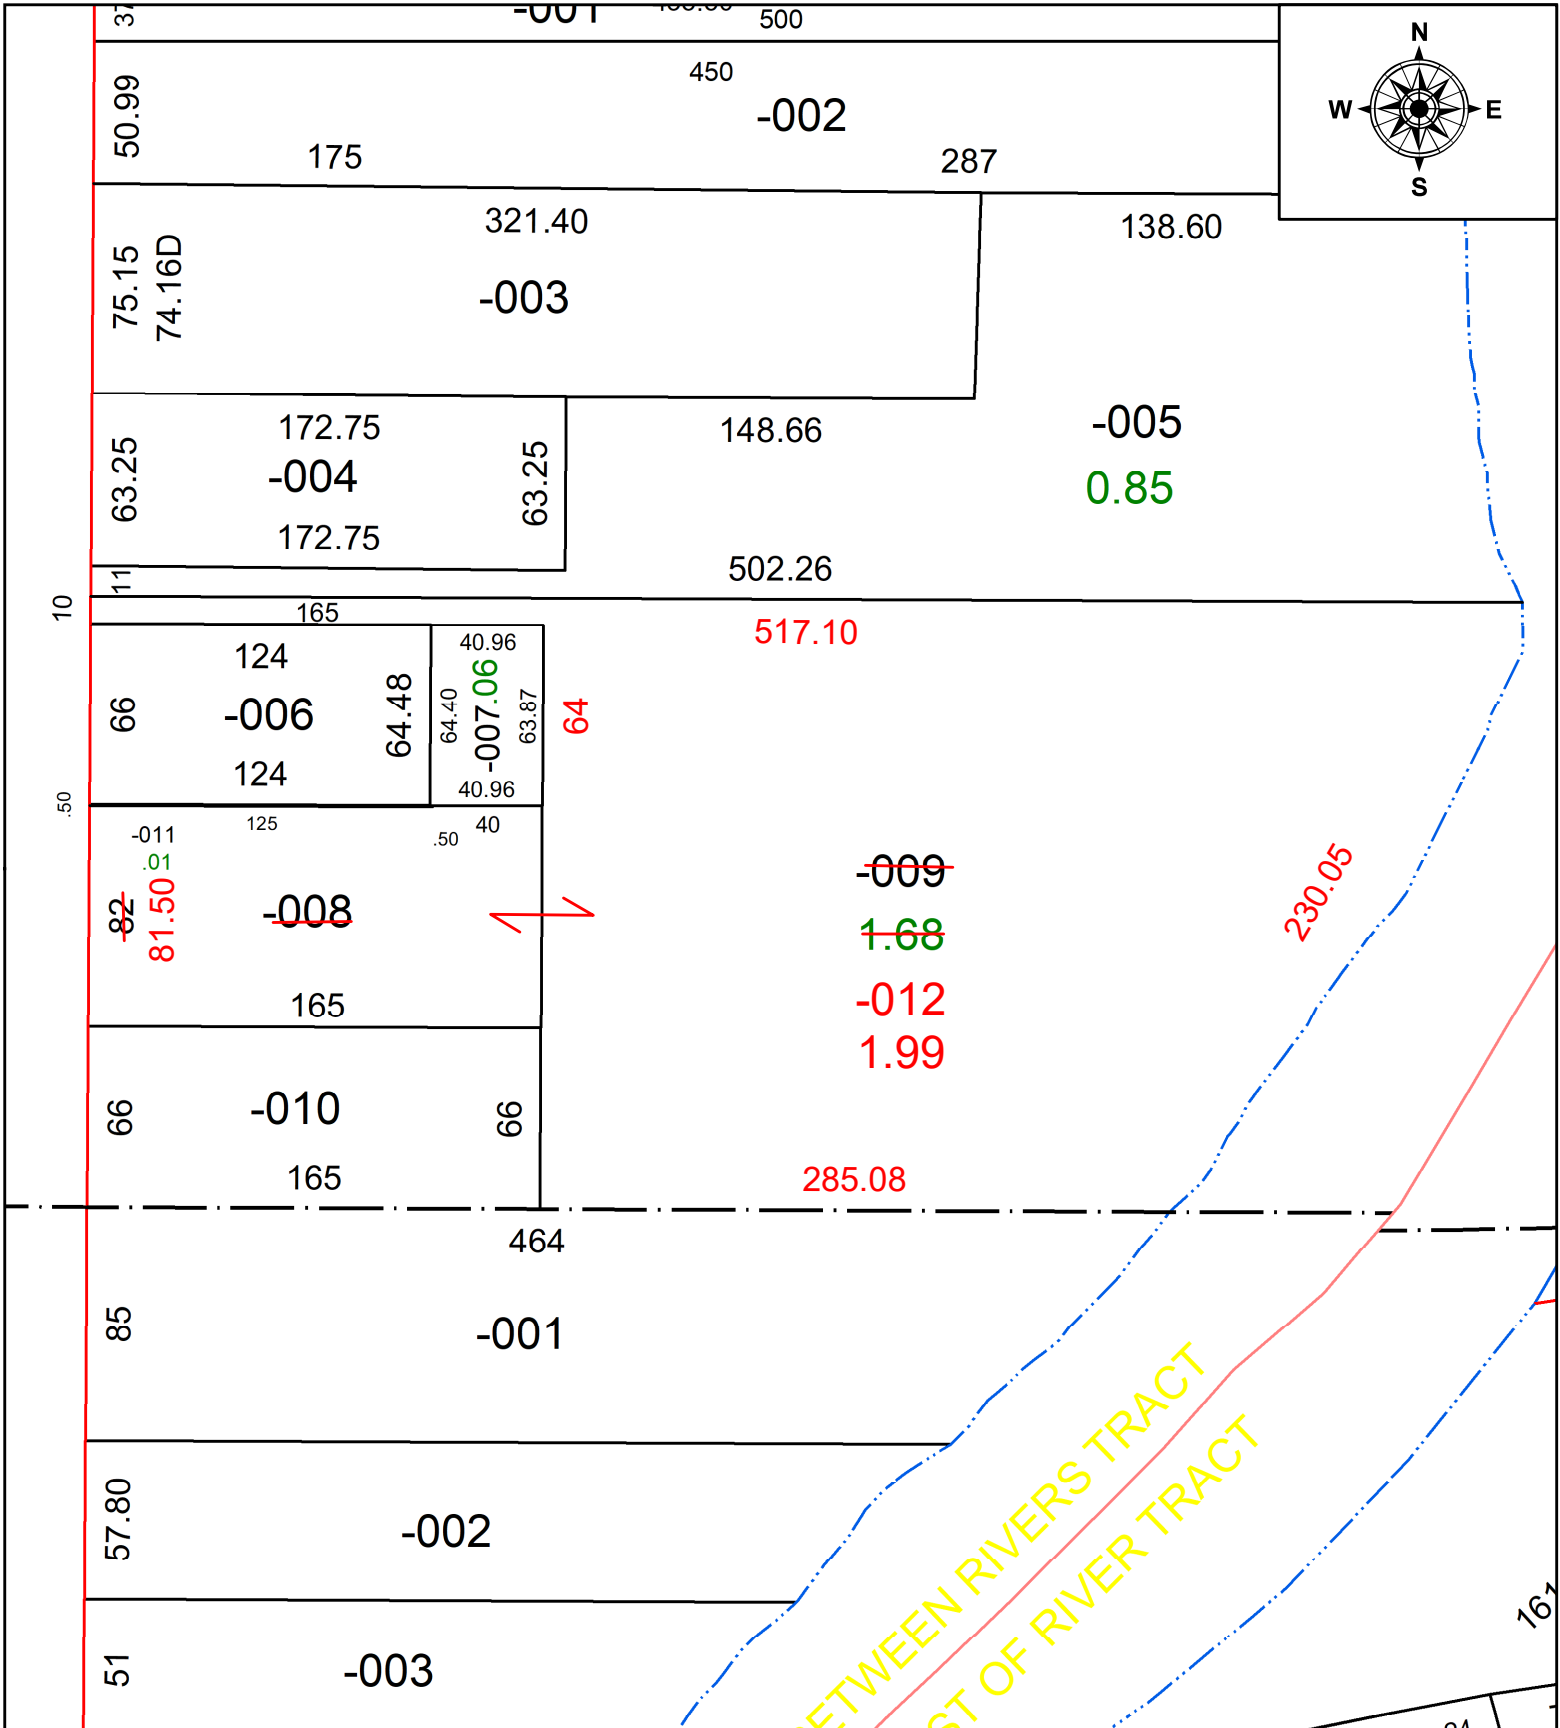

SPLITS/DEEDS PROCESSED
 LORAIN COUNTY TAX MAP DEPARTMENT
 226 MIDDLE AVE. ELYRIA, OH

SURVEYED BY: JAMES RESAR
 CLOSURE: 1: 159978
 MAP PAGE(S): 06-26-020
 APPROVED BY: AC DATE: 3/29/2022
 SCALE: 1" = 70 PRIOR INSTRUMENT: 2016-0577245