


PARENT PARCEL: 05-00-043-106-006, -007

CHILD PARCEL: 05-00-043-106-016

STARTING POINT: COMBINATION

22-04429

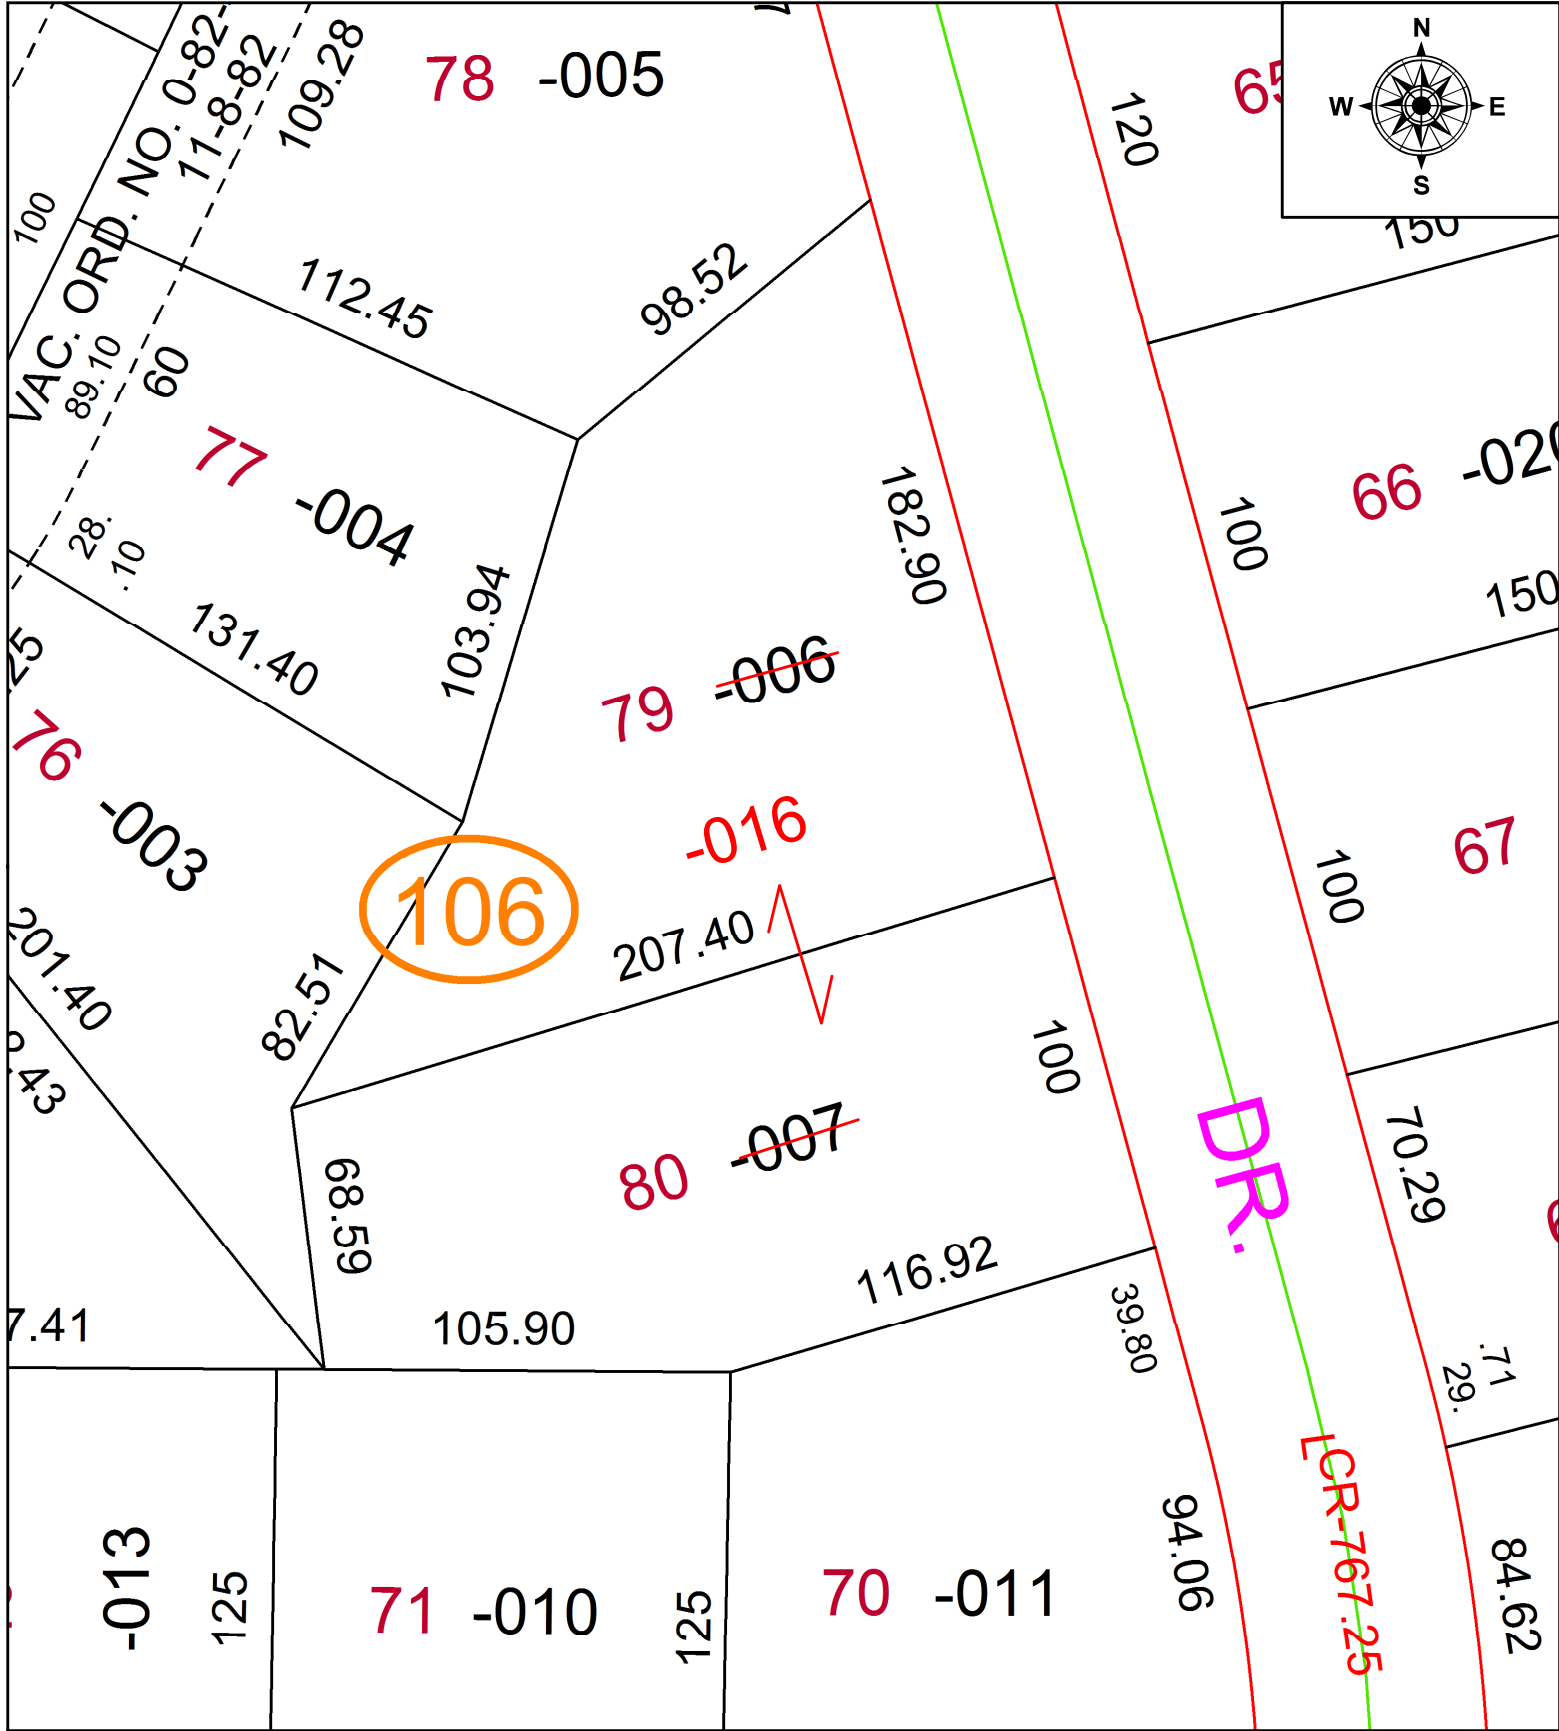

**SPLITS/DEEDS PROCESSED**  
LORAIN COUNTY TAX MAP DEPARTMENT  
226 MIDDLE AVE. ELYRIA, OH

SURVEYED BY: PATRICK A. MCGANNON

CLOSURE: N/A

MAP PAGE(S): 05-00-043

APPROVED BY: AC DATE: 1/10/2022

SCALE: 1" = 50 PRIOR INSTRUMENT: 2002-0877541