
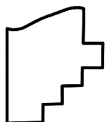


PARENT PARCEL: 09-00-085-103-028, -033

CHILD PARCEL: 09-00-085-103-036

STARTING POINT: FRONTAGE & DEPTH TO AC CORR PER SURV BY RICHARD FREDRICKSON

22-04431

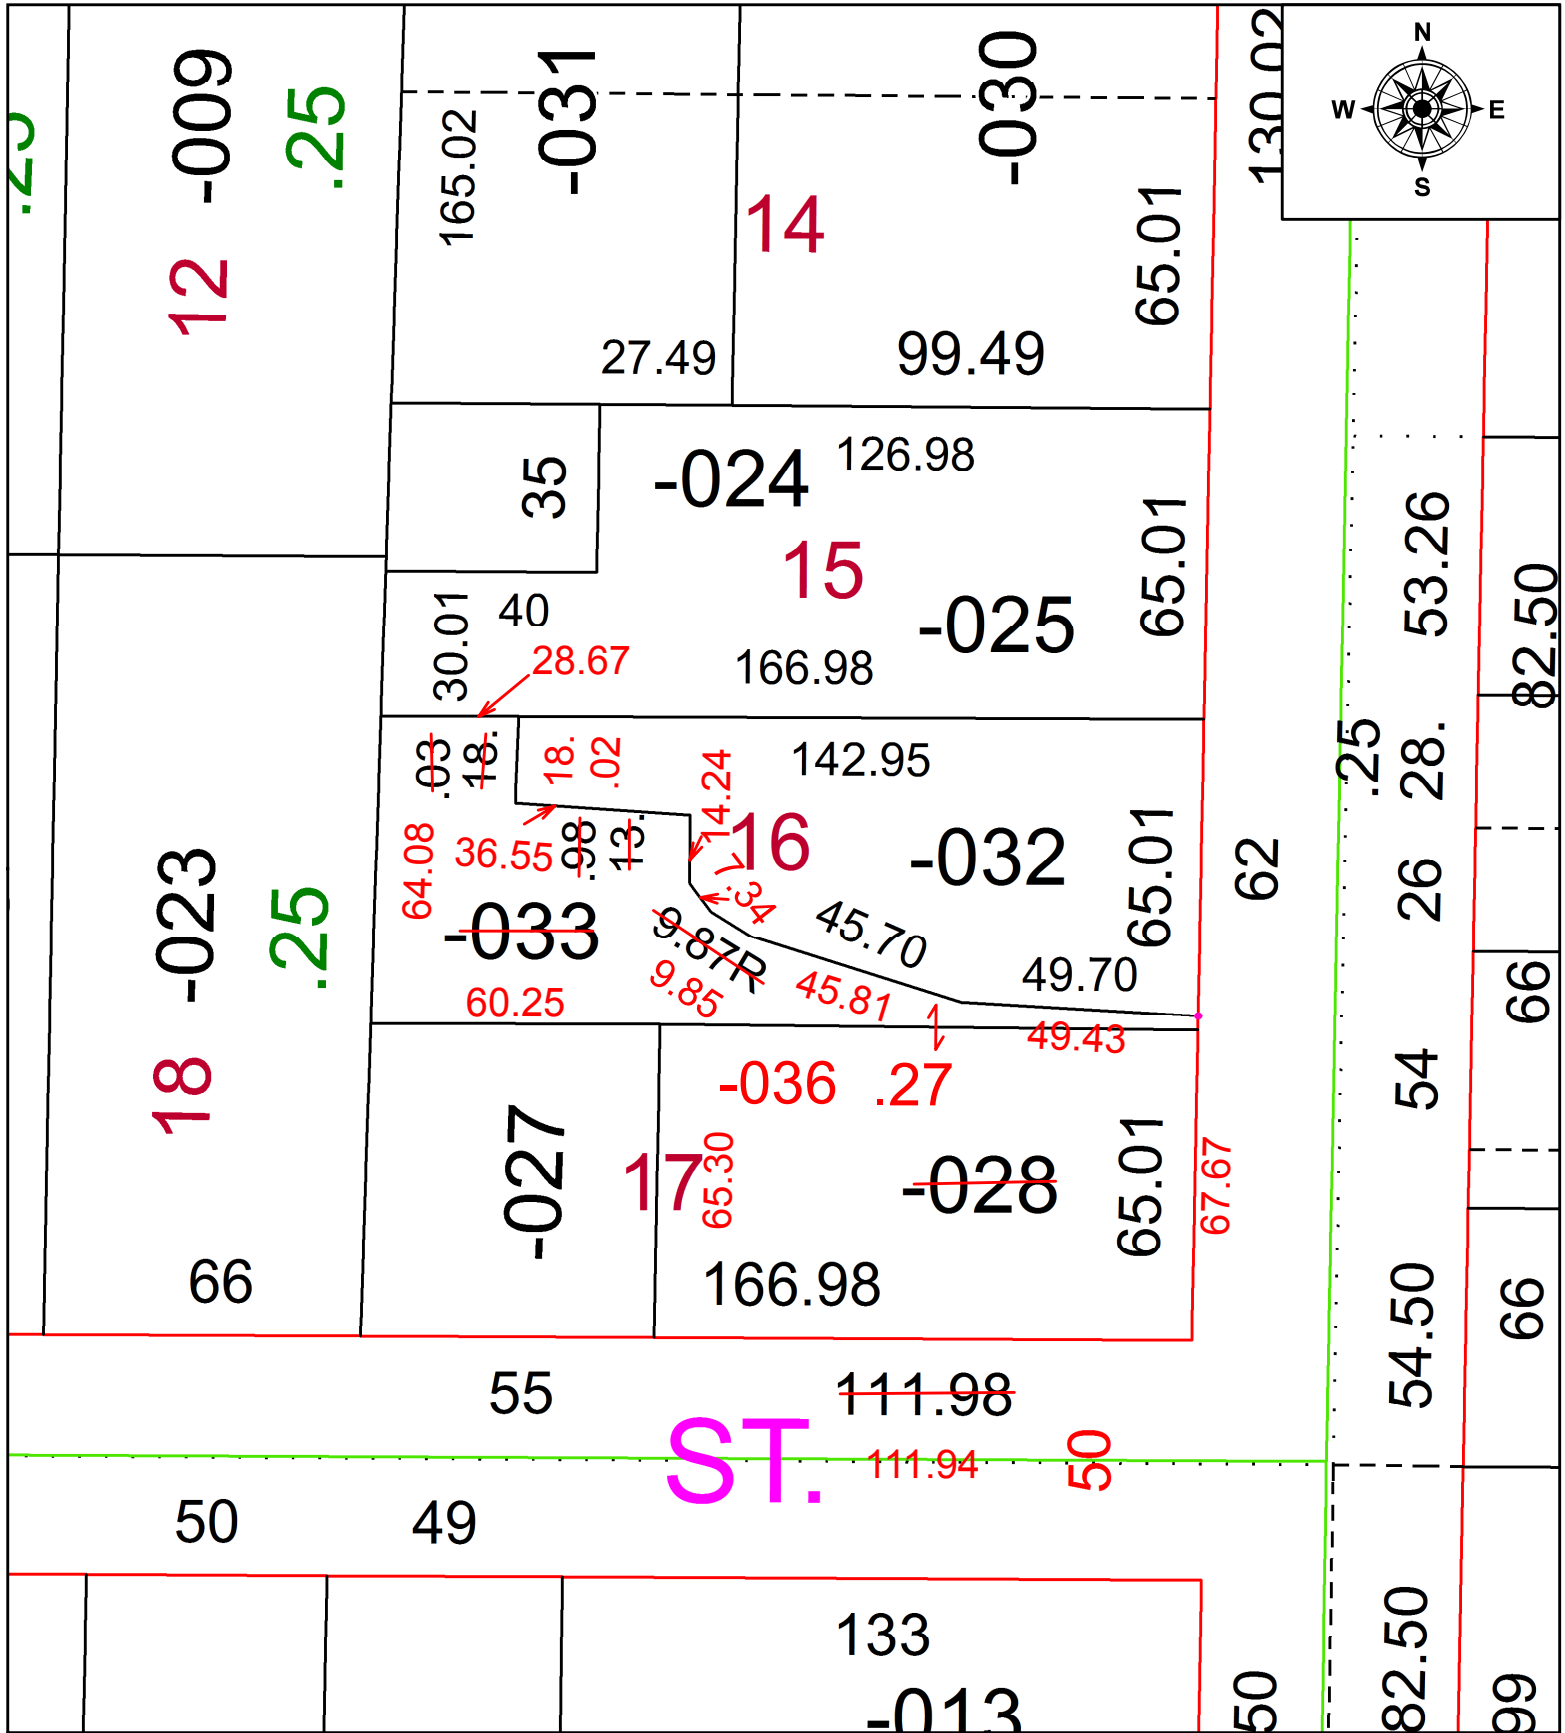

**SPLITS/DEEDS PROCESSED**  
 LORAIN COUNTY TAX MAP DEPARTMENT  
 226 MIDDLE AVE. ELYRIA, OH

SURVEYED BY: RICHARD A. FREDRICKSON

CLOSURE: 1: 89949

MAP PAGE(S): 09-00-085-A

APPROVED BY: AC DATE: 1/12/2022

SCALE: 1" = 40 PRIOR INSTRUMENT: 2016-0606789