
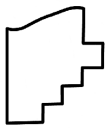


PARENT PARCEL: 05-00-005-106-012, 05-00-016-101-049, -084, -182

CHILD PARCEL: 05-00-016-101-189, -190, 191 ST. TRNS. 05-00-016-101-049 & -182, 05-00-005-106-012

22-04432

STARTING POINT: CL OF WILLOW CREEK DR. & SOUTH LAKE ST.

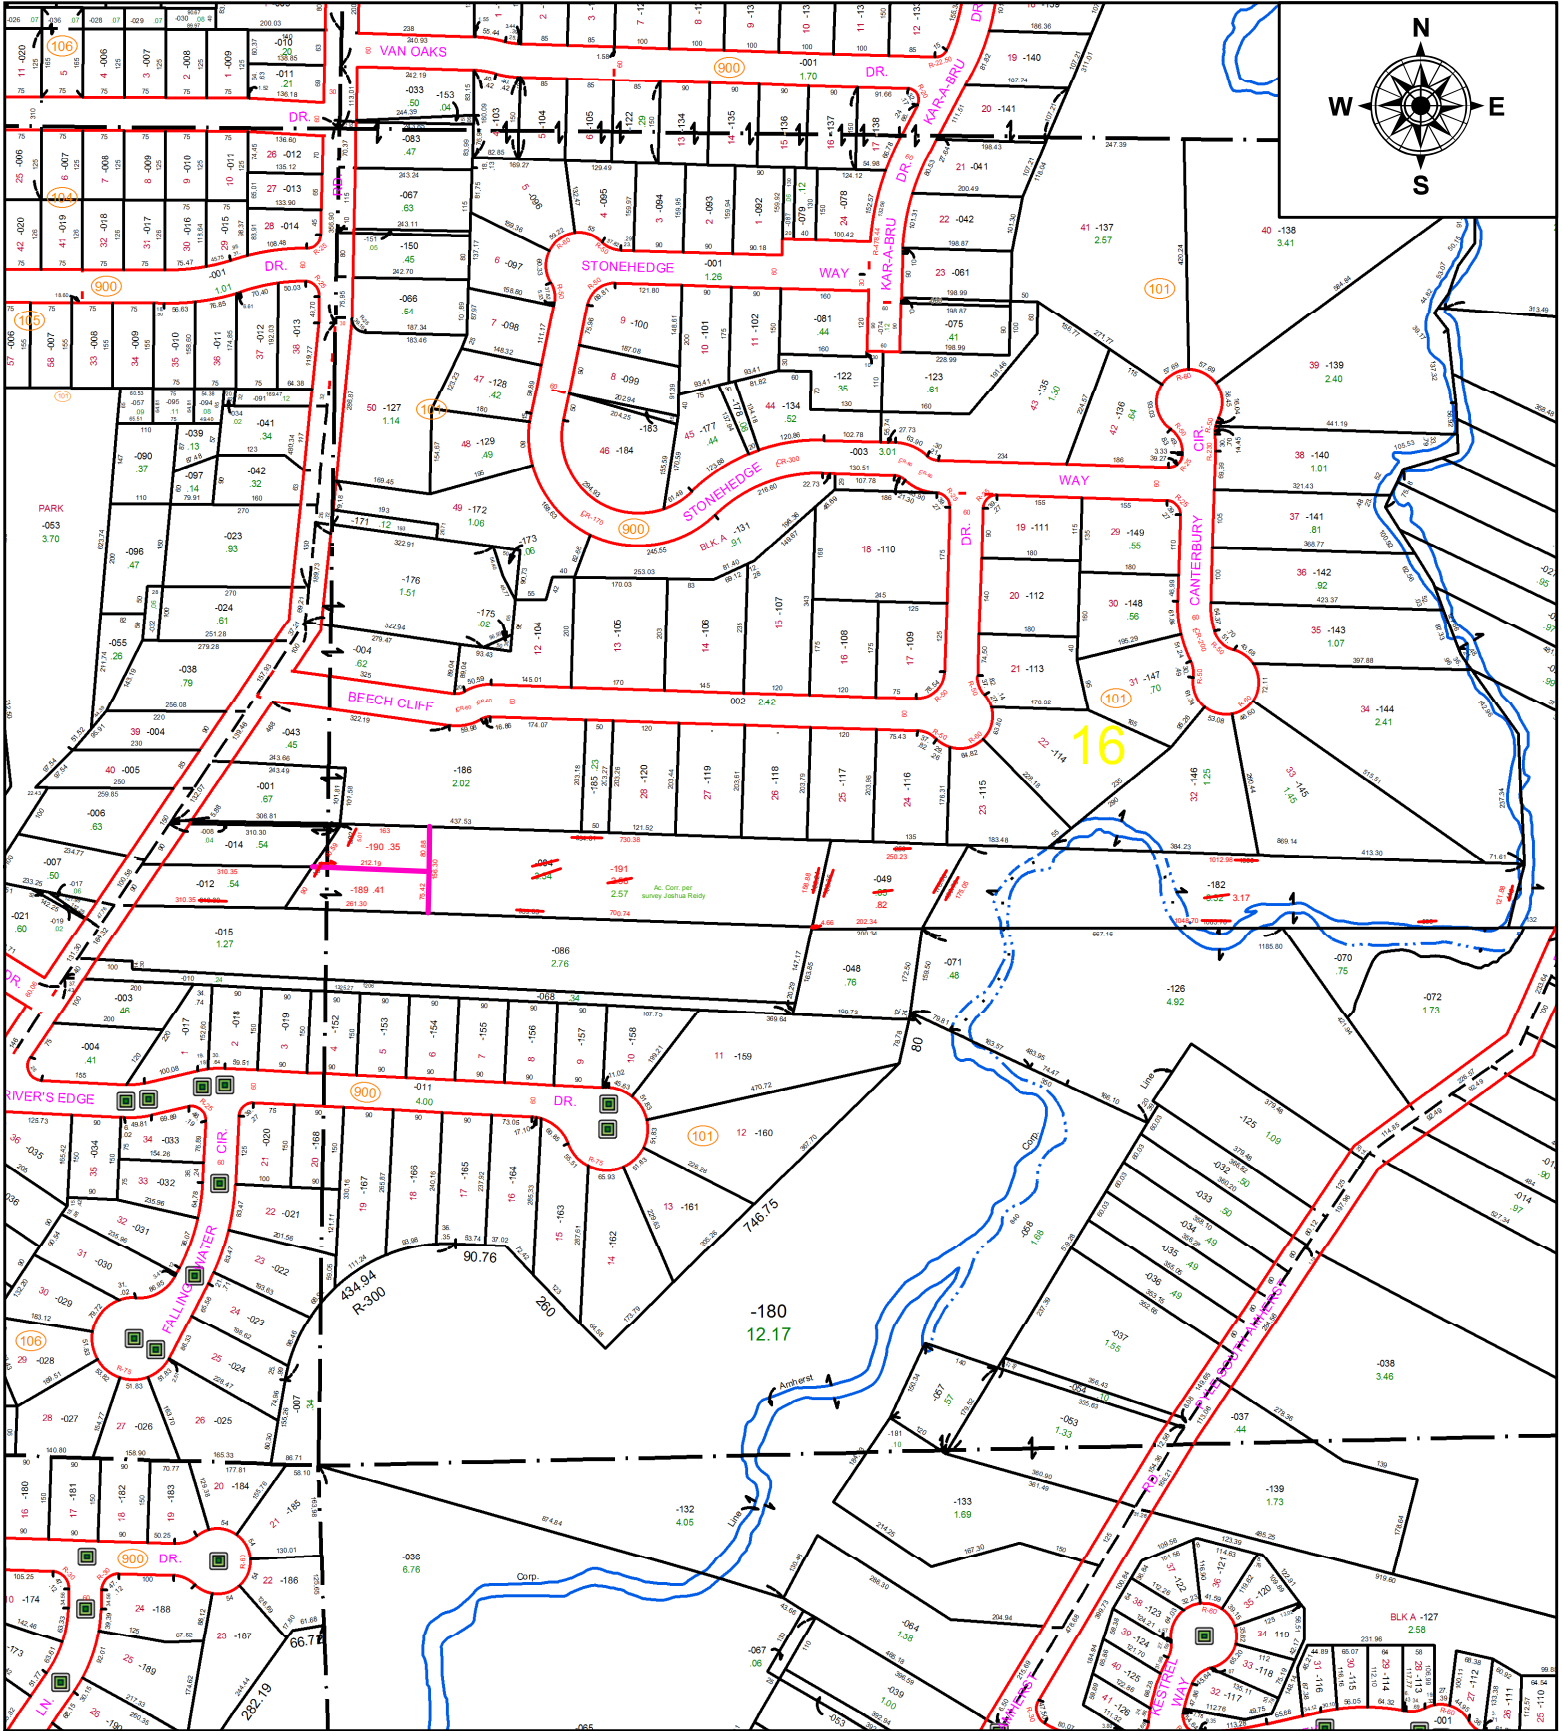


**SPLITS/DEEDS PROCESSED**  
 LORAIN COUNTY TAX MAP DEPARTMENT  
 226 MIDDLE AVE. ELYRIA, OH

**SURVEYED BY:** JOSHUA REIDY  
**CLOSURE:** 1: 85.605  
**MAP PAGE(S):** 05-00-005: 05-00-016  
**APPROVED BY:** DMA **DATE:** 1/13/2022  
**SCALE:** 1" = 350 **PRIOR INSTRUMENT:** 2011-0387999





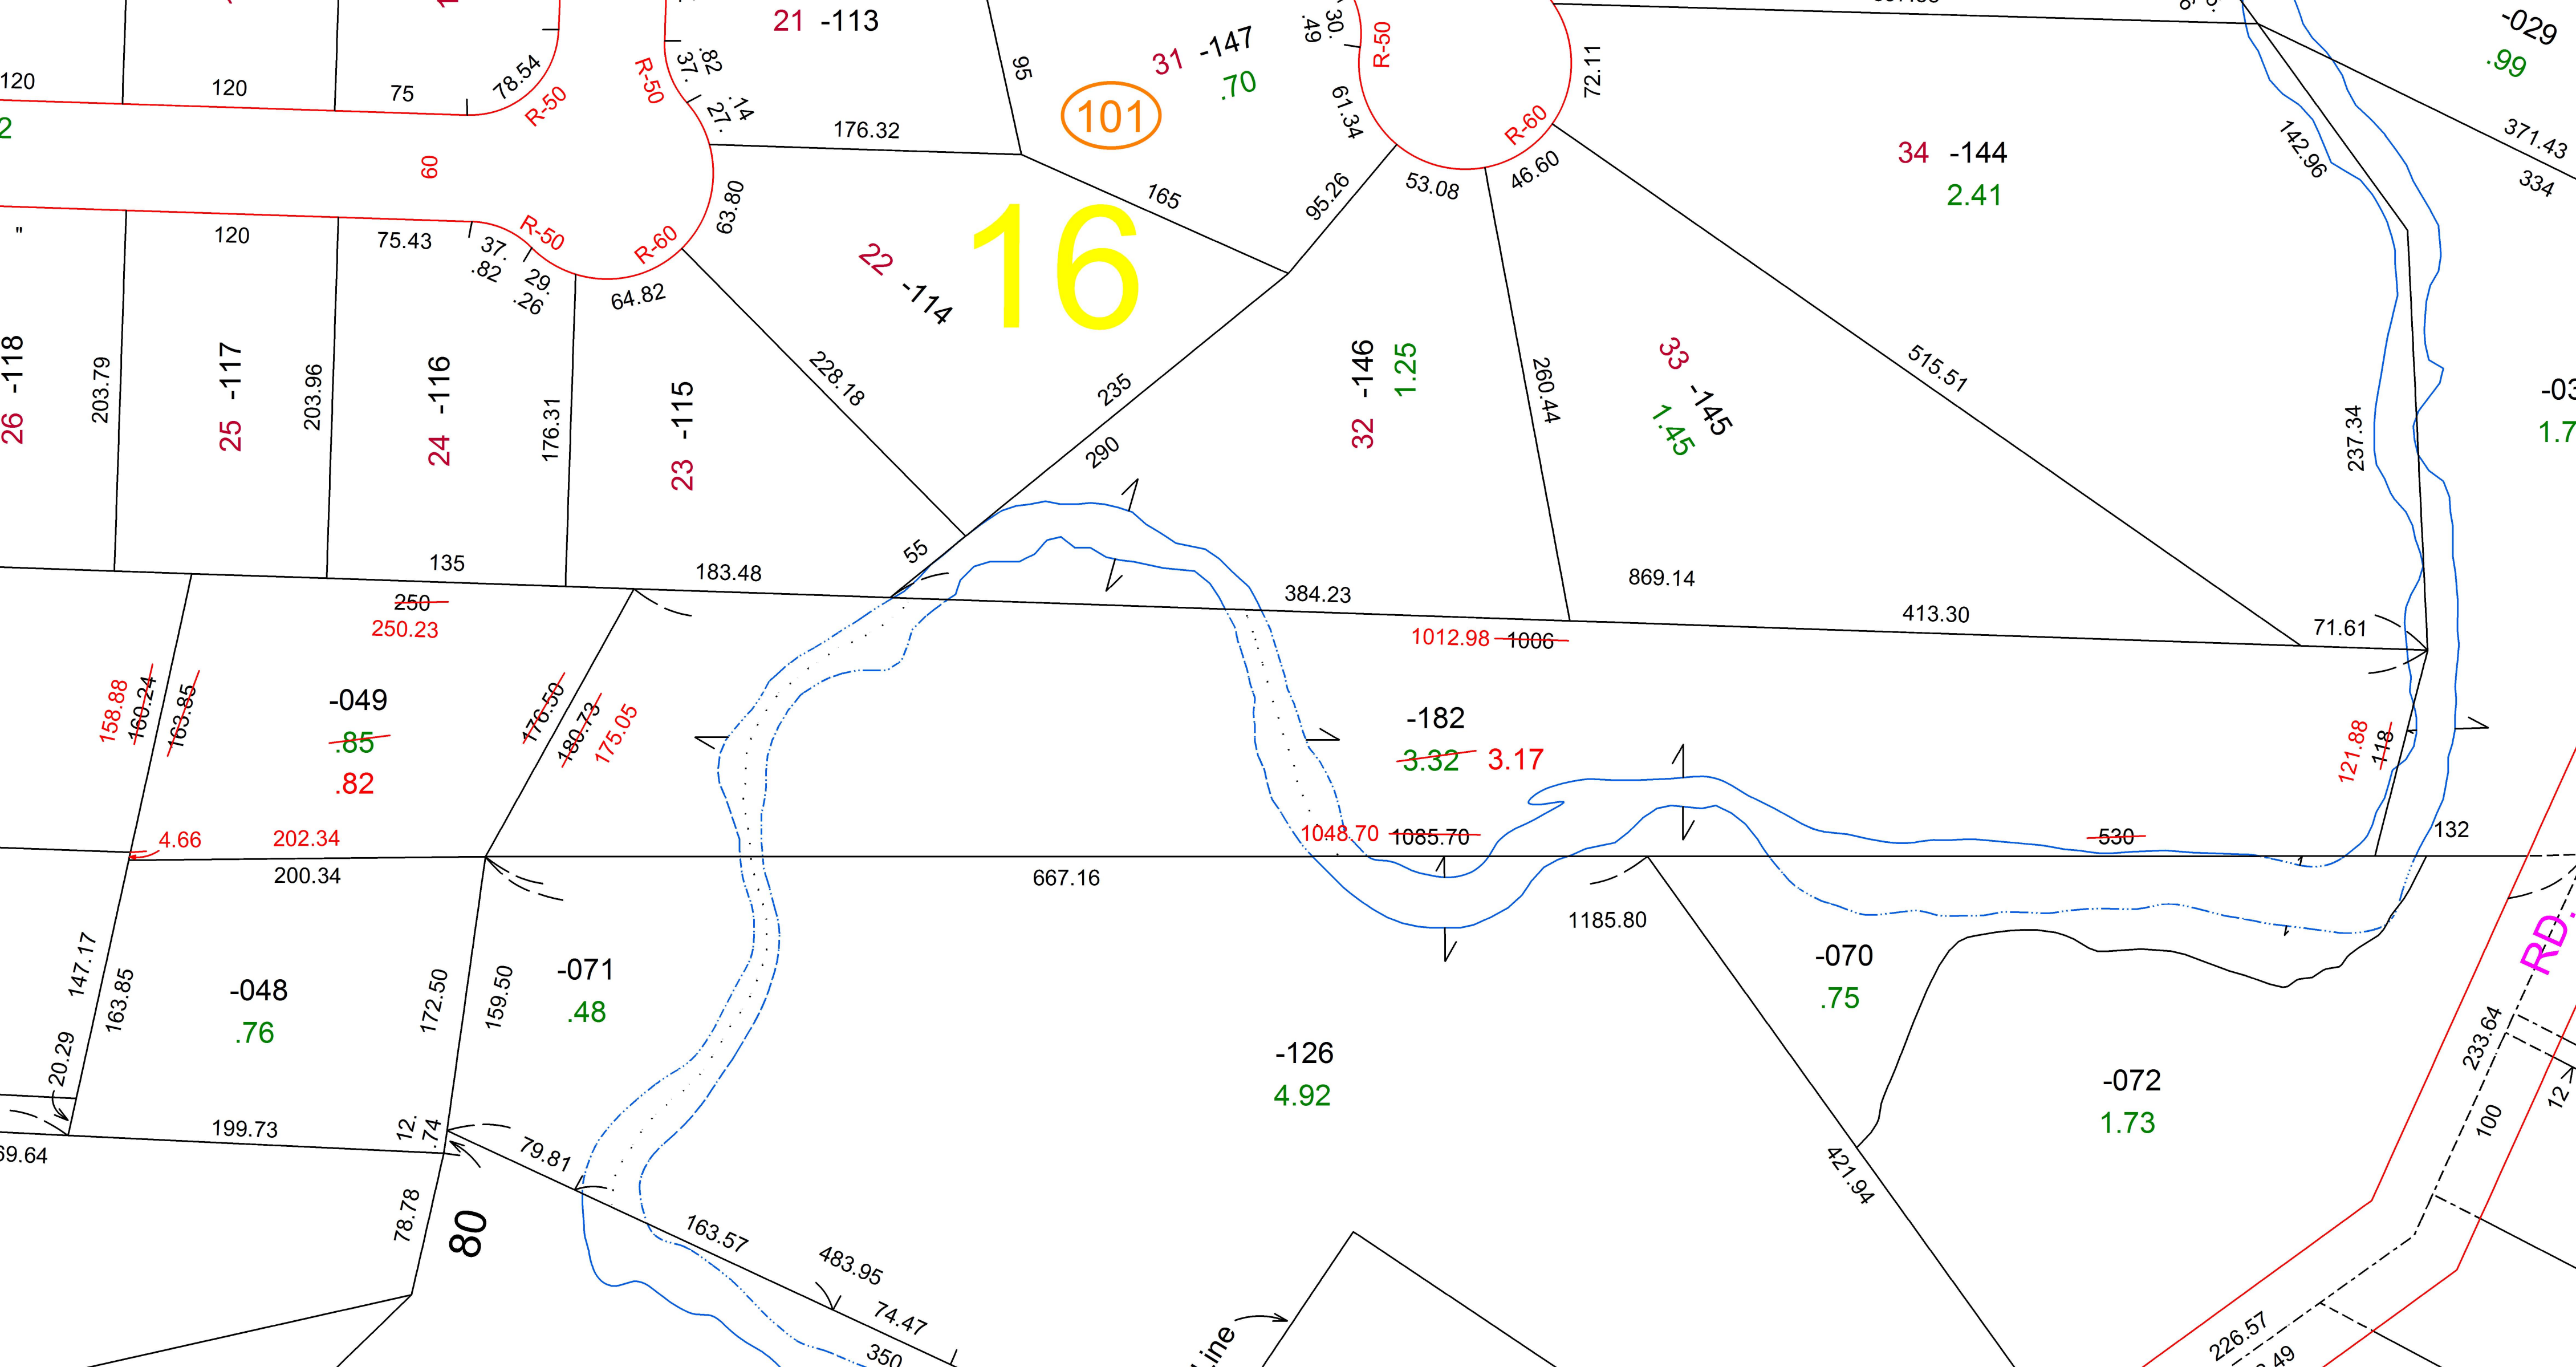

16

101

21 -113

31 -147  
.70

34 -144  
2.41

33 -145  
1.45

32 -146  
1.25

-049  
~~.85~~  
.82

-182  
~~3.32~~ 3.17

-048  
.76

-071  
.48

-126  
4.92

-070  
.75

-072  
1.73

80

RD.

line

