


PARENT PARCEL: 19-03-052-000-002



CHILD PARCEL:

STARTING POINT: NORTHEAST CORNER OF O.L.52 TR. 3

20-04440-C

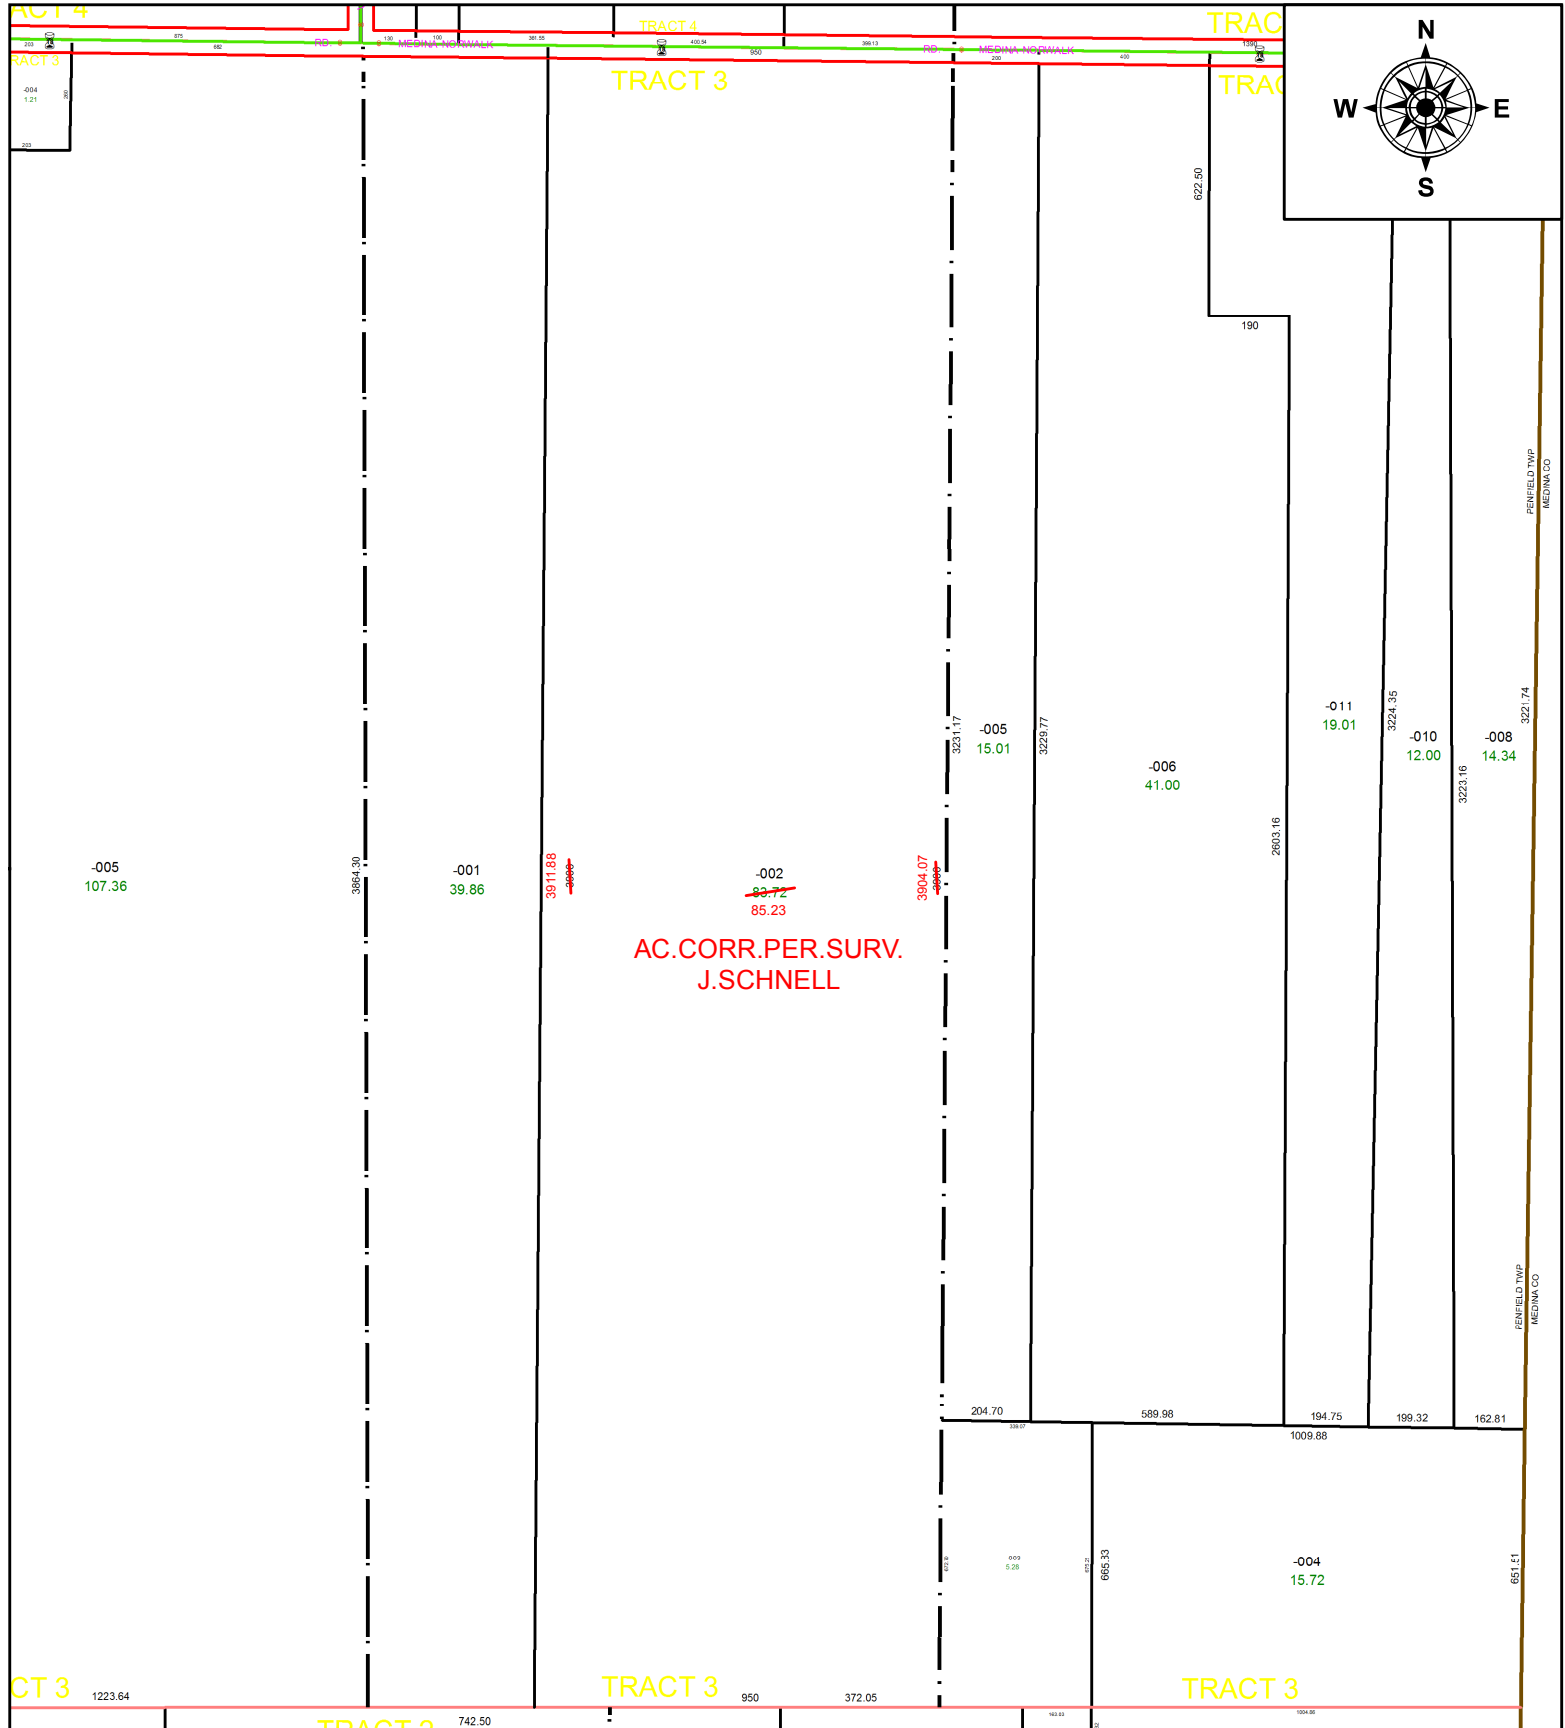

AC. CORR. PER. SURV.
J. SCHNELL

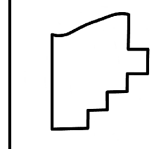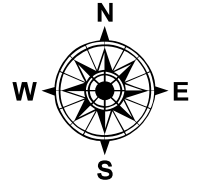

SPLITS/DEEDS PROCESSED
LORAIN COUNTY TAX MAP DEPARTMENT
226 MIDDLE AVE. ELYRIA, OH

SURVEYED BY:	JARROD R. SCHNELL
CLOSURE:	1:929,203
MAP PAGE(S):	19-03-052
APPROVED BY:	RRM
DATE:	11-19-20
SCALE:	1" = 450
PRIOR INSTRUMENT:	20110393194