
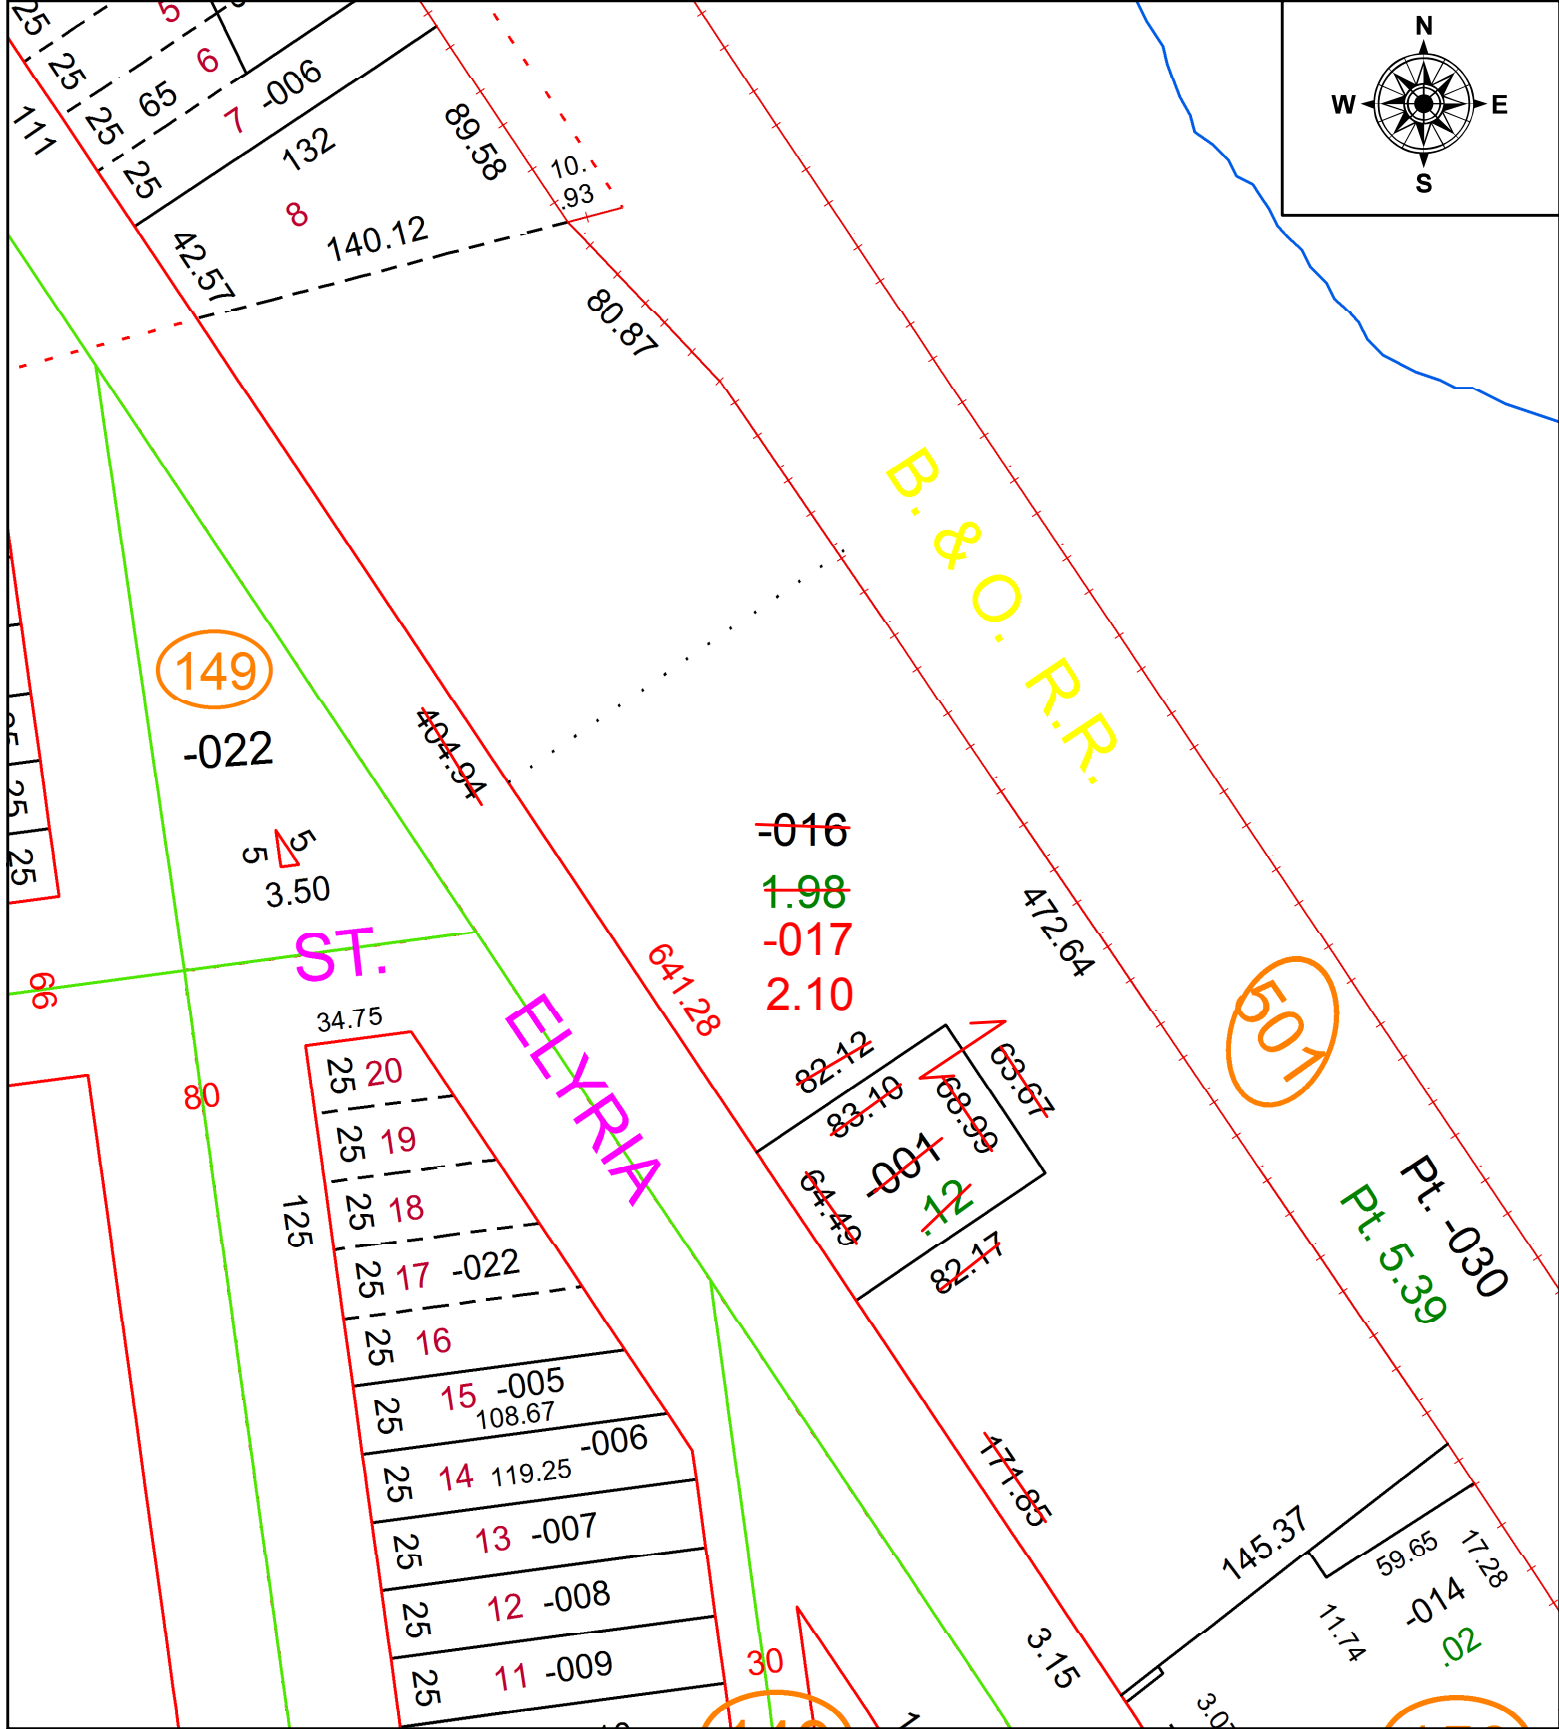


PARENT PARCEL: 02-01-003-150-001 & 02-01-003-150-016

CHILD PARCEL: 02-01-003-150-017

STARTING POINT: SE CORNER OF S/L 8 AND WEST LINE OF BALTIMORE AND OHIO RR

22-04441

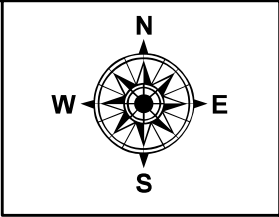

SPLITS/DEEDS PROCESSED
 LORAIN COUNTY TAX MAP DEPARTMENT
 226 MIDDLE AVE. ELYRIA, OH

SURVEYED BY: TIMOTHY R. DURR
CLOSURE: 1: 942368
MAP PAGE(S): 02-01-003-F
APPROVED BY: AC **DATE:** 2/17/2022
SCALE: 1" = 70 **PRIOR INSTRUMENT:** 2021- 0834788