
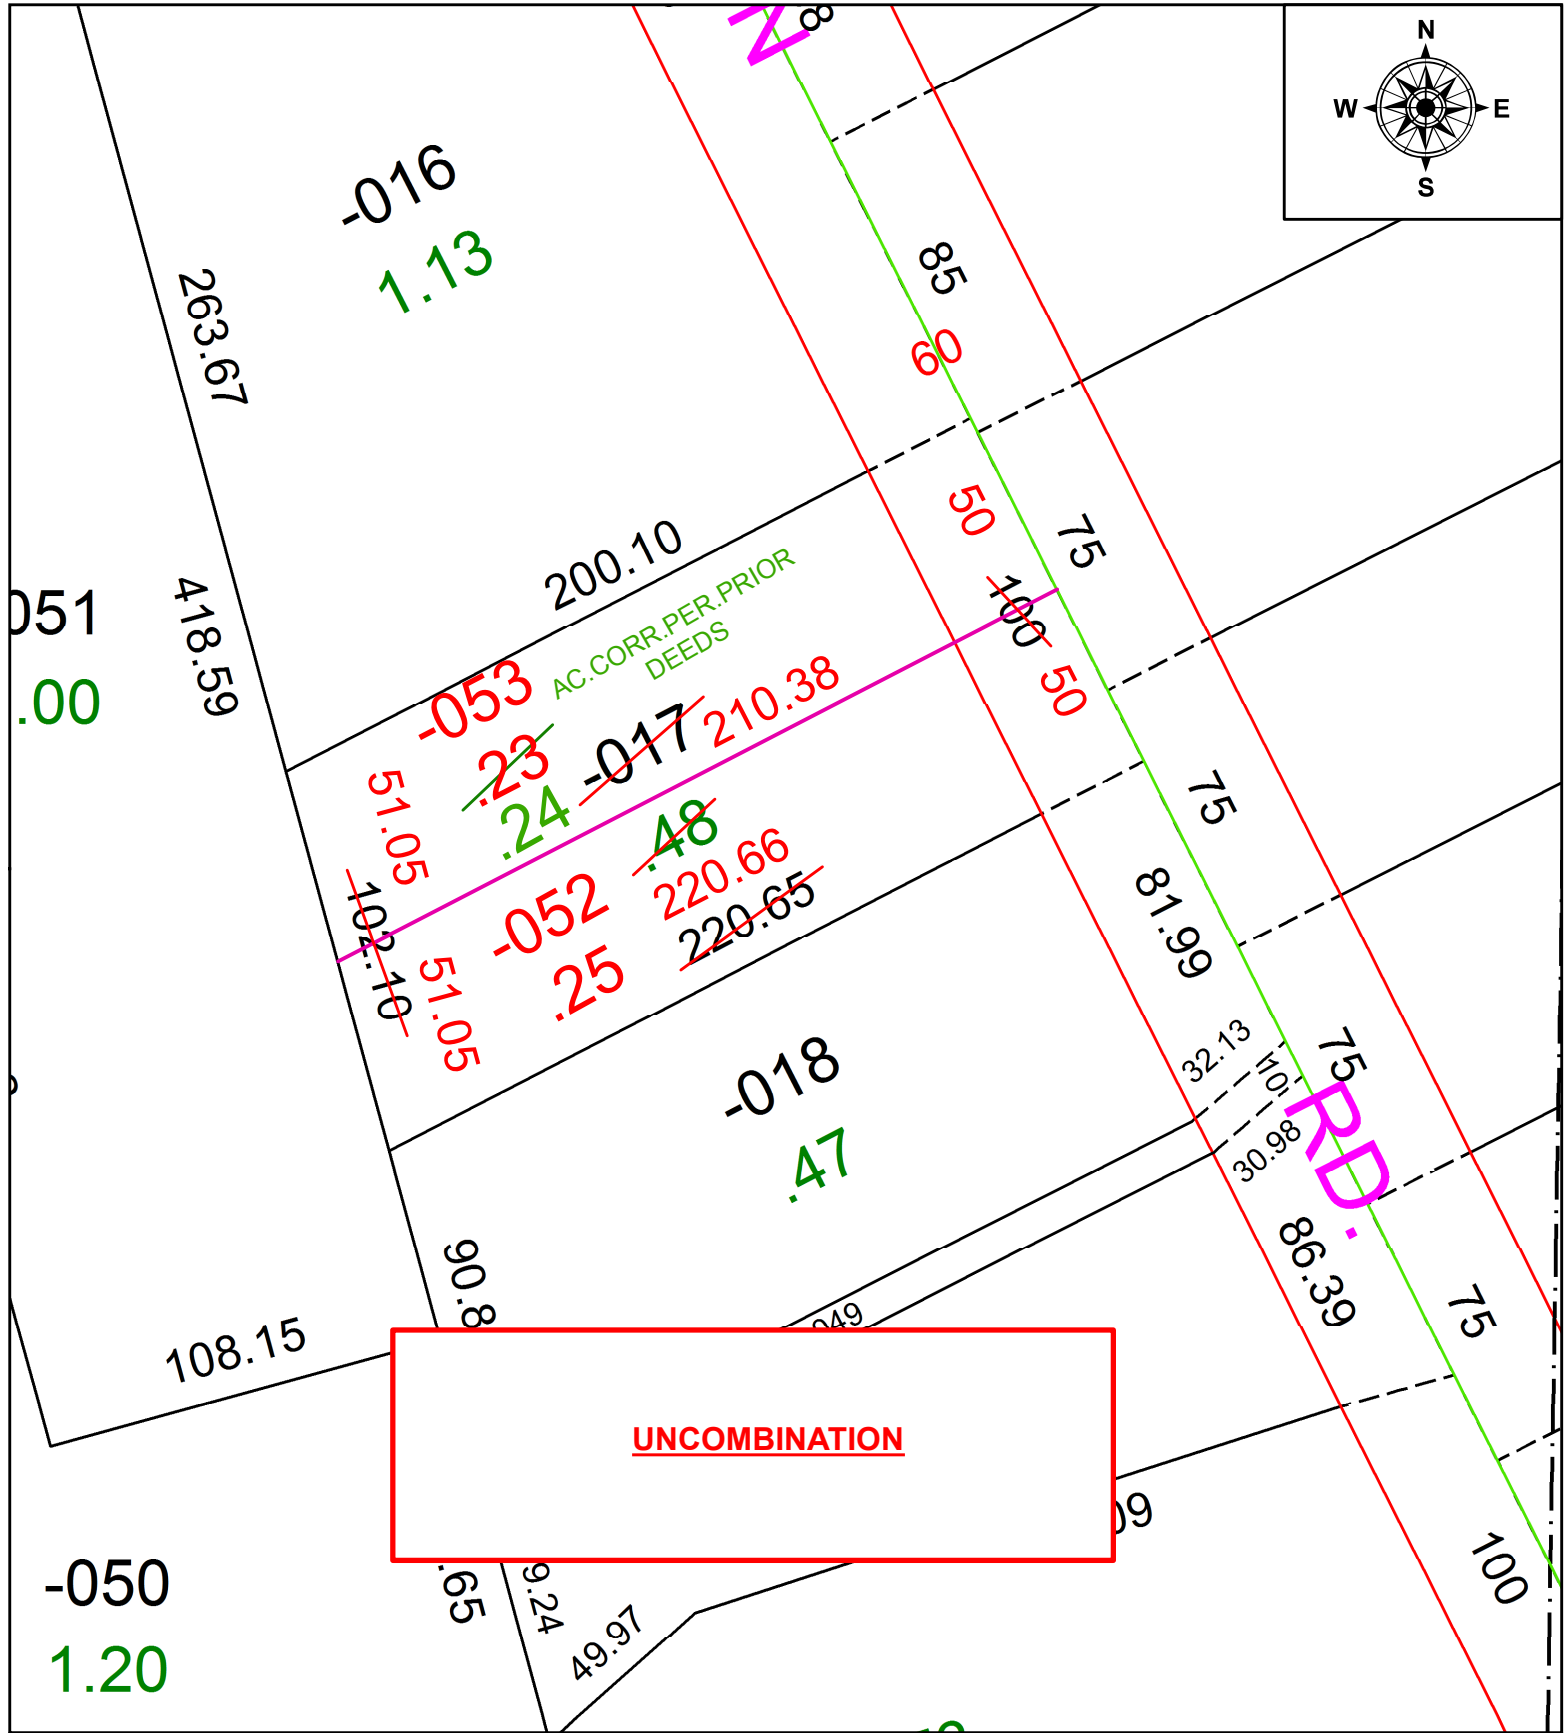


PARENT PARCEL: 05-00-060-105-017


CHILD PARCEL: 05-00-060-105-052, -053

STARTING POINT: INTERSECTION OF C/L OF OBERLIN RD, AND C/L OF NORTH RIDGE RD.

20-04442-U

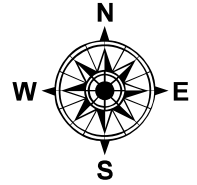

**UNCOMBINATION**

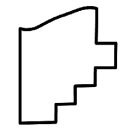

**SPLITS/DEEDS PROCESSED**  
LORAIN COUNTY TAX MAP DEPARTMENT  
226 MIDDLE AVE. ELYRIA, OH

SURVEYED BY:	N/A
CLOSURE:	N/A
MAP PAGE(S):	5-00-060
APPROVED BY:	RRM DATE: 11-23-20
SCALE:	1" = 50
PRIOR INSTRUMENT:	20150562561