
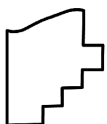


PARENT PARCEL: 13-08-014-000-002

CHILD PARCEL:

STARTING POINT: NORTHEAST CORNER OF O.L.14 TR.8

20-04443-A

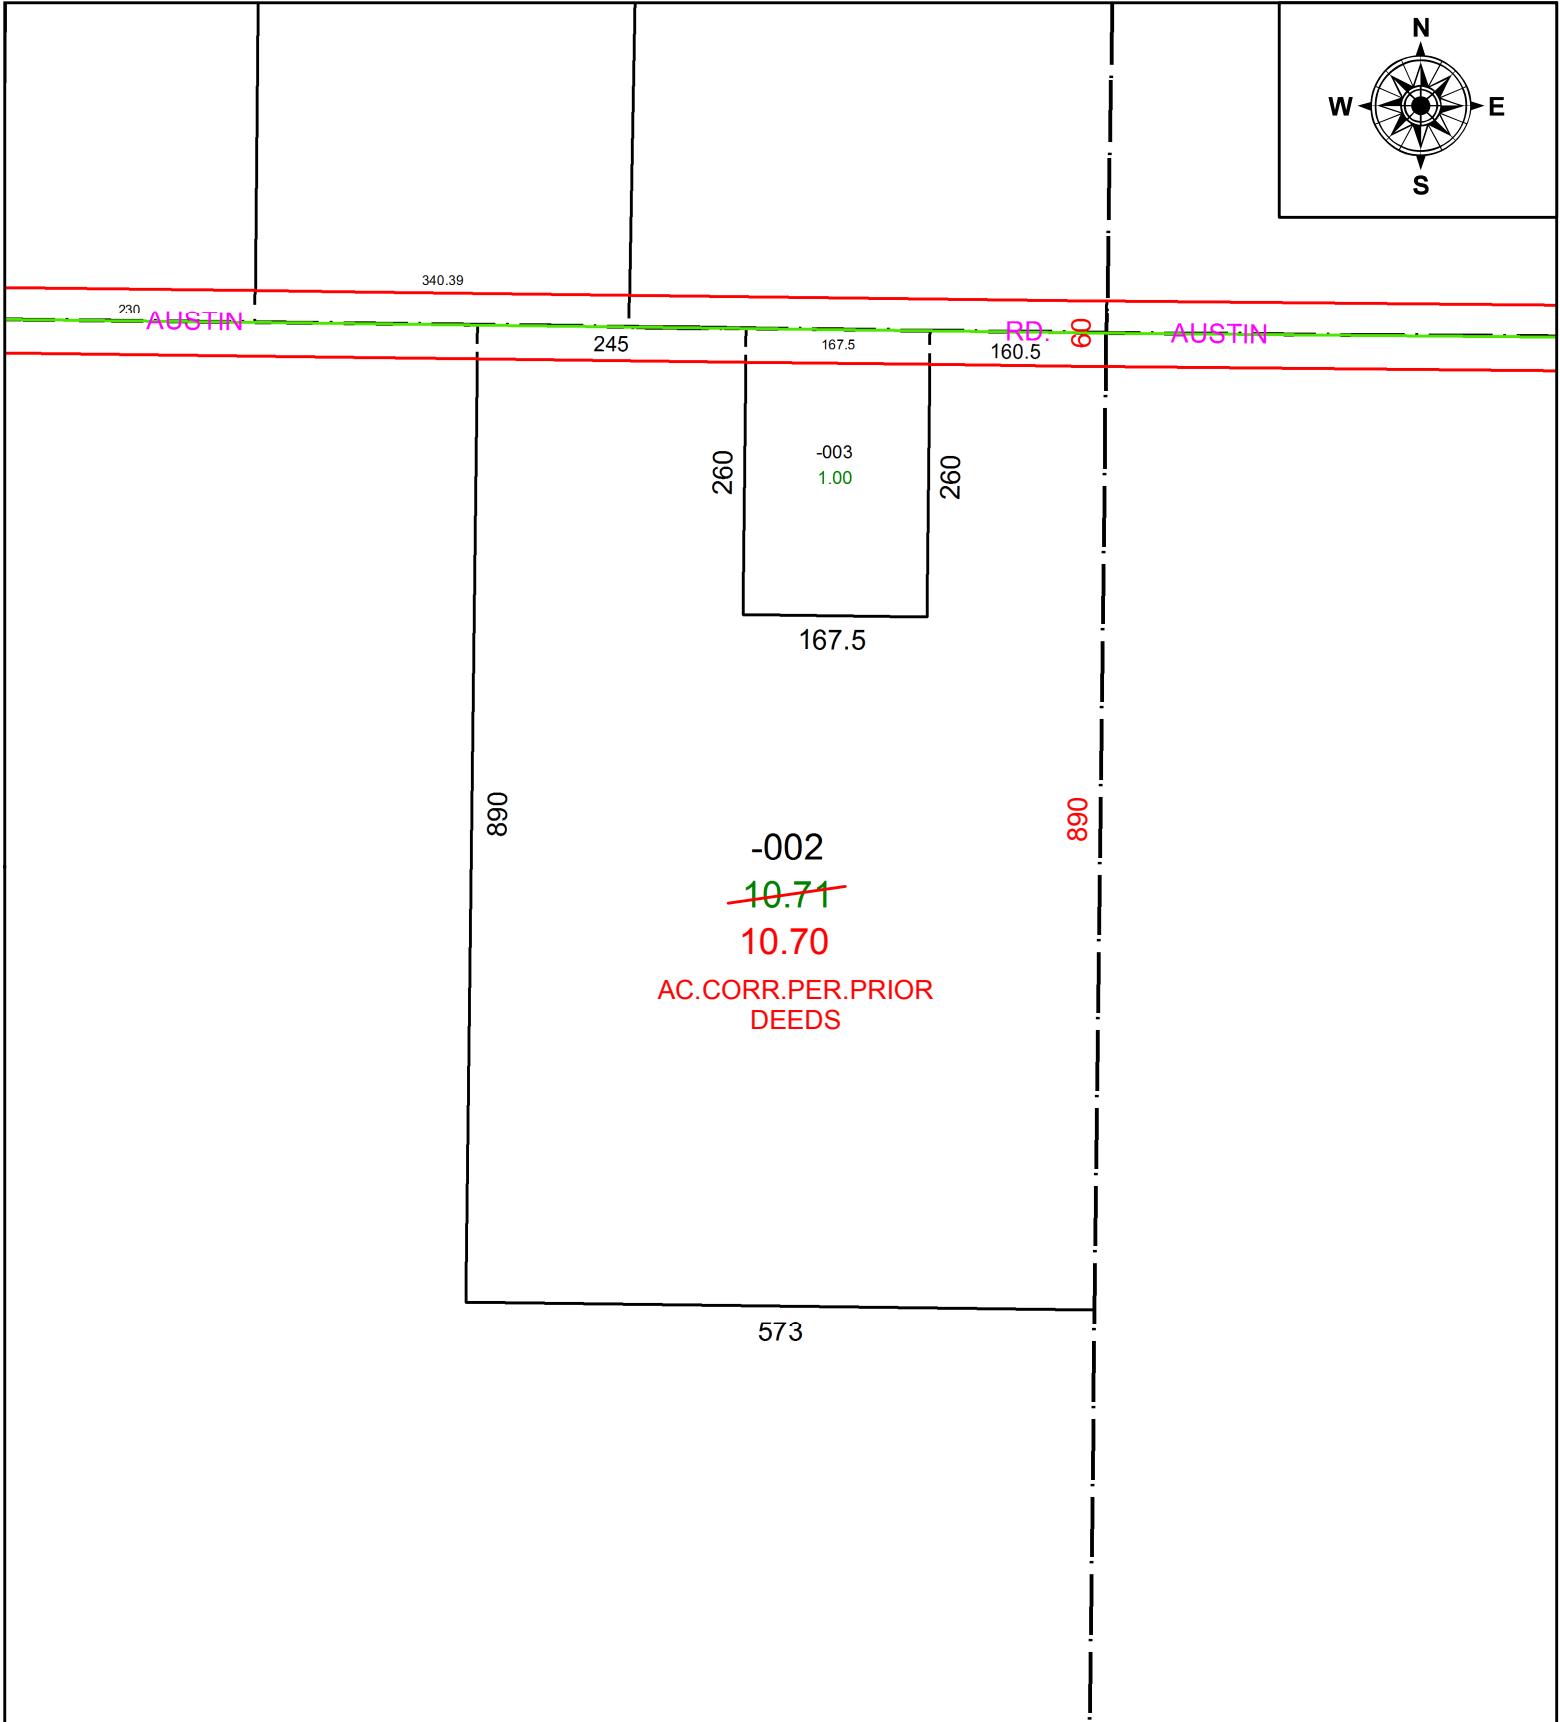

SPLITS/DEEDS PROCESSED
 LORAIN COUNTY TAX MAP DEPARTMENT
 226 MIDDLE AVE. ELYRIA, OH

SURVEYED BY: _____ N/A
 CLOSURE: _____ N/A
 MAP PAGE(S): _____ 13-08-014
 APPROVED BY: _____ RRM DATE: _____ 11-23-20
 SCALE: _____ 1" = 175 PRIOR INSTRUMENT: _____ 20200778187