


PARENT PARCEL: 12-00-040-101-020


CHILD PARCEL:

STARTING POINT: INTERSECTION OF C/L OF WEST RIVER RD. AND C/L OF SPRAGUE RD.

20-04444-C

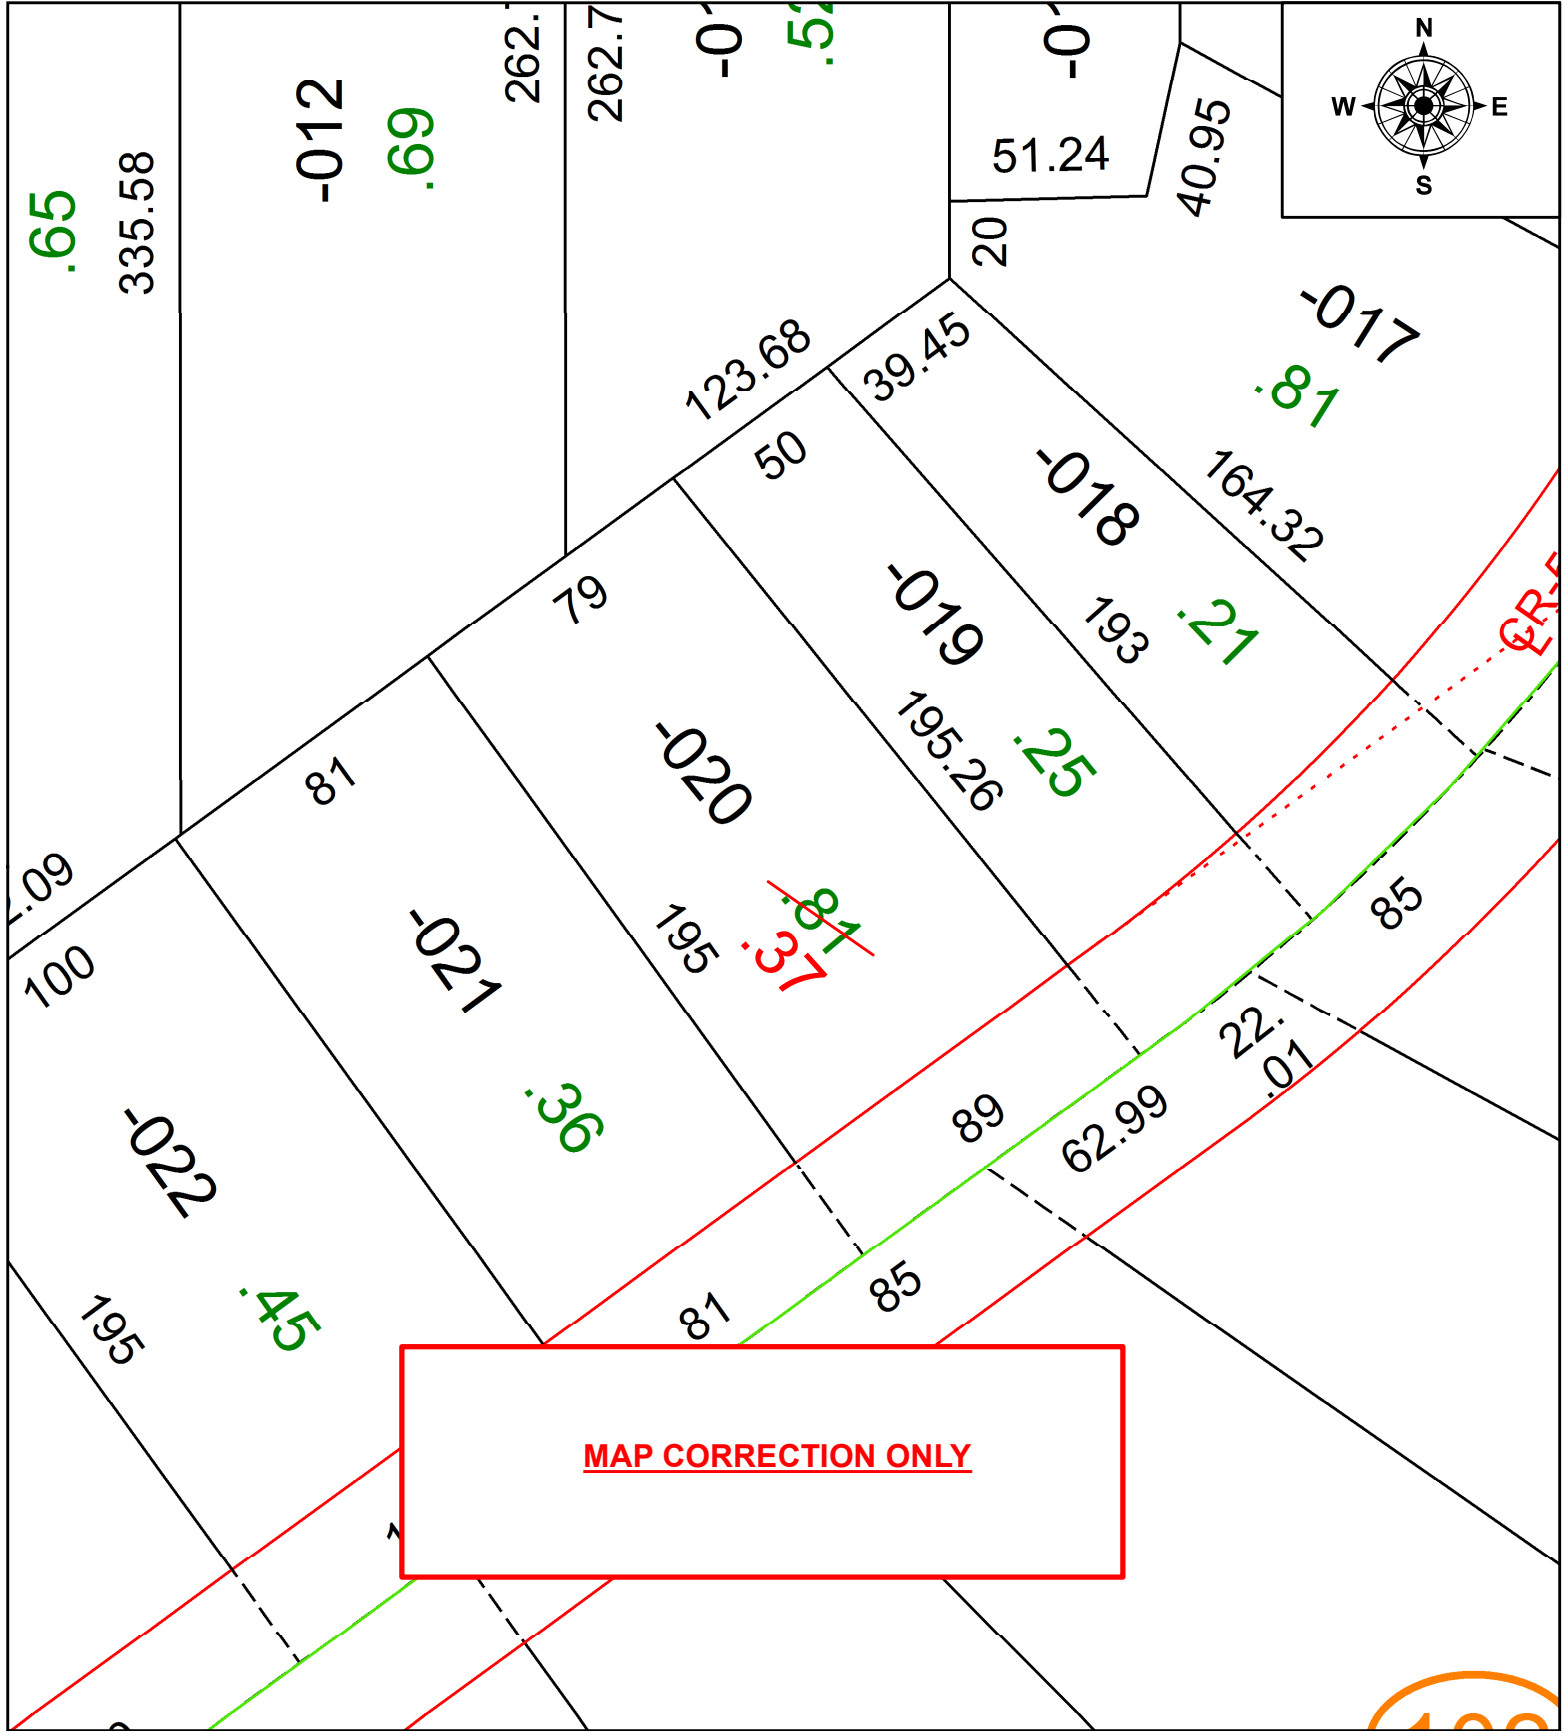

MAP CORRECTION ONLY

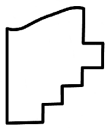

SPLITS/DEEDS PROCESSED
LORAIN COUNTY TAX MAP DEPARTMENT
226 MIDDLE AVE. ELYRIA, OH

SURVEYED BY:	N/A
CLOSURE:	1:147,706
MAP PAGE(S):	12-00-040
APPROVED BY:	RRM DATE: 11-23-20
SCALE:	1" = 50
PRIOR INSTRUMENT:	20040023489