
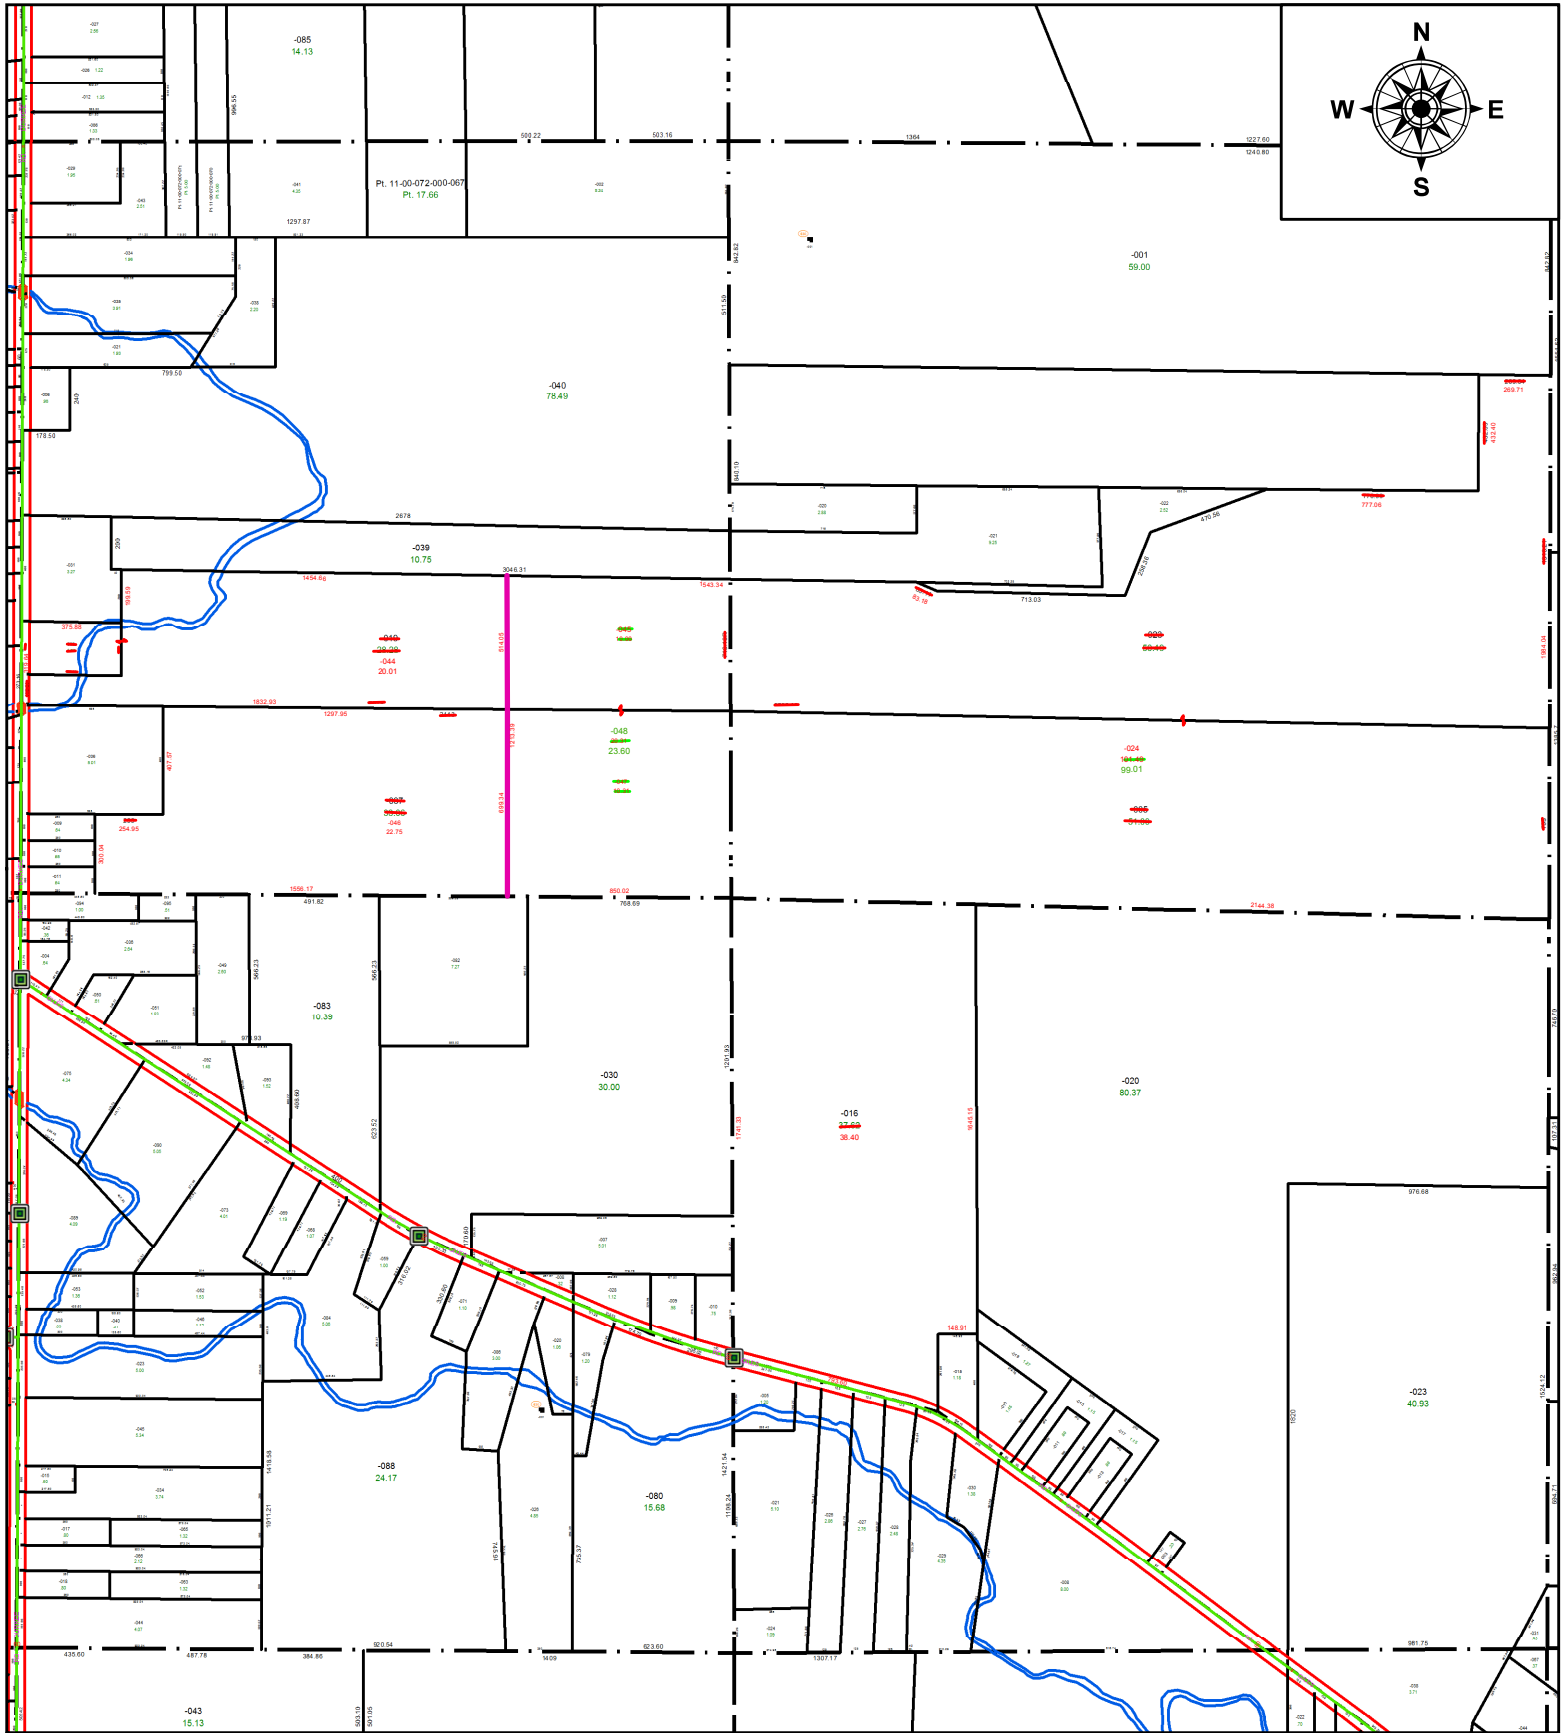


PARENT PARCEL: 11-00-067-000-016, 11-00-068-000-005, -023. 11-00-073-000-019, -032, -037

CHILD PARCEL: 11-00-067-000-016, 11-00-068-000-024. 11-00-073-000-044 THRU -048

22-04445

STARTING POINT: **AC CORR PER SURV BY STEVEN J. METCALF**

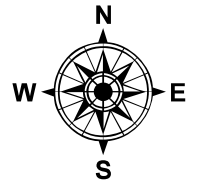

SPLITS/DEEDS PROCESSED
LORAIN COUNTY TAX MAP DEPARTMENT
226 MIDDLE AVE. ELYRIA, OH

SURVEYED BY: STEVEN J. METCALF

CLOSURE: 1: 100789

MAP PAGE(S): 11-00-073-B

APPROVED BY: AC DATE: 2/28/2022

SCALE: 1" = 725 PRIOR INSTRUMENT: 2011- 0370277