
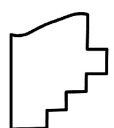


PARENT PARCEL: 04-00-012-103-006, -135

CHILD PARCEL: 04-00-012-103-400

STARTING POINT: C/L OF STONEY RIDGE RD & SOUTHWESTERLY CORNER OF LAND TO LAWRENCE LEONARD JR. DV 85/402

22-04446

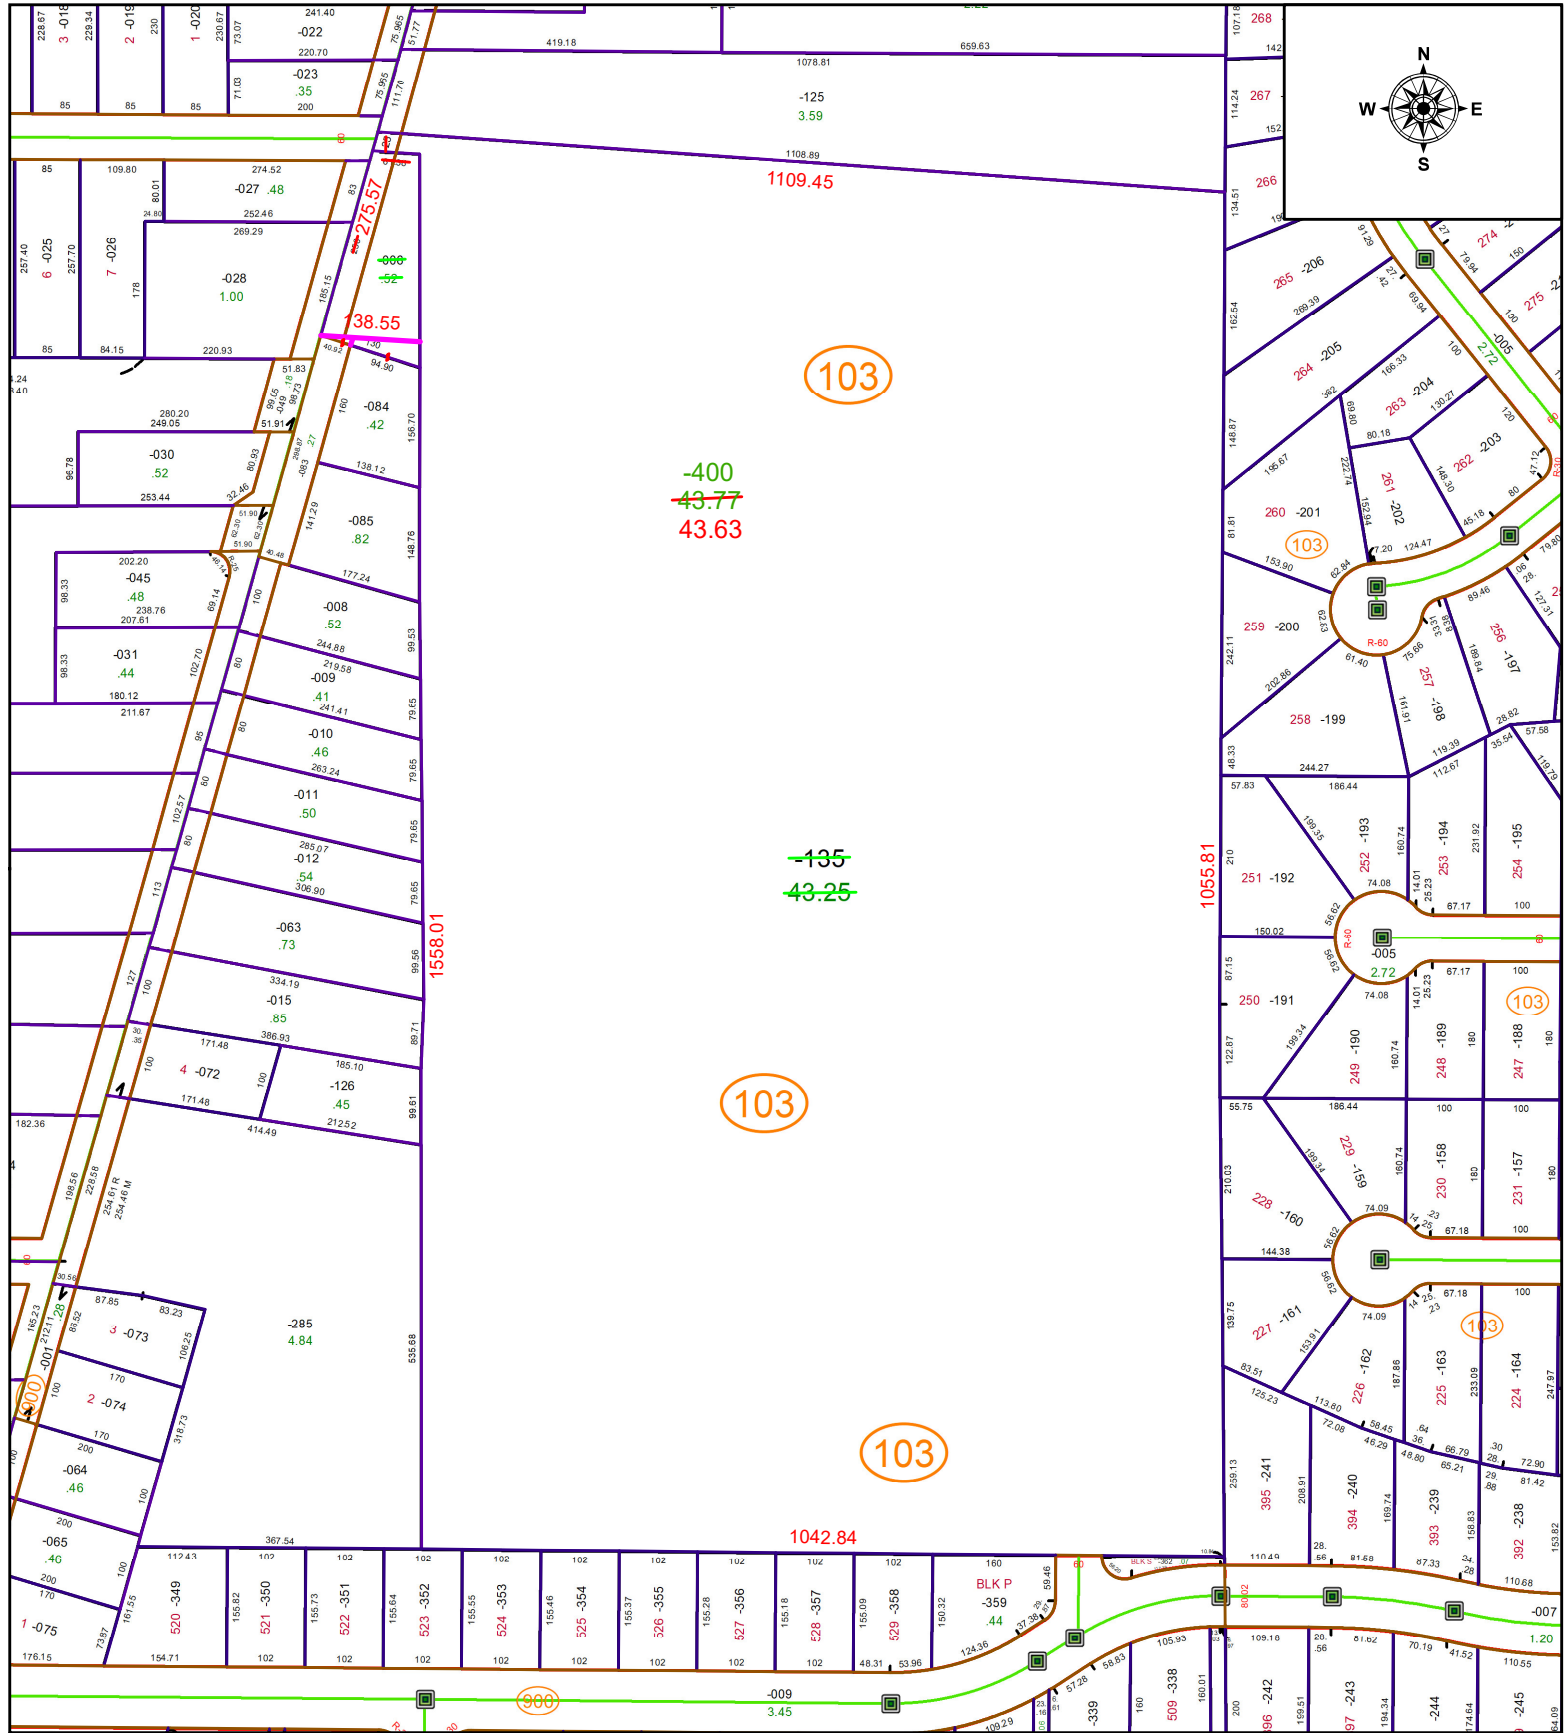

SPLITS/DEEDS PROCESSED
 LORAIN COUNTY TAX MAP DEPARTMENT
 226 MIDDLE AVE. ELYRIA, OH

SURVEYED BY: CHRISTOPHER J. DEMPSEY
CLOSURE: 1: 550327
MAP PAGE(S): 04-00-012
APPROVED BY: WRZ **DATE:** 2/22/2022
SCALE: 1" = 250 **PRIOR INSTRUMENT:** 2012-0433950