
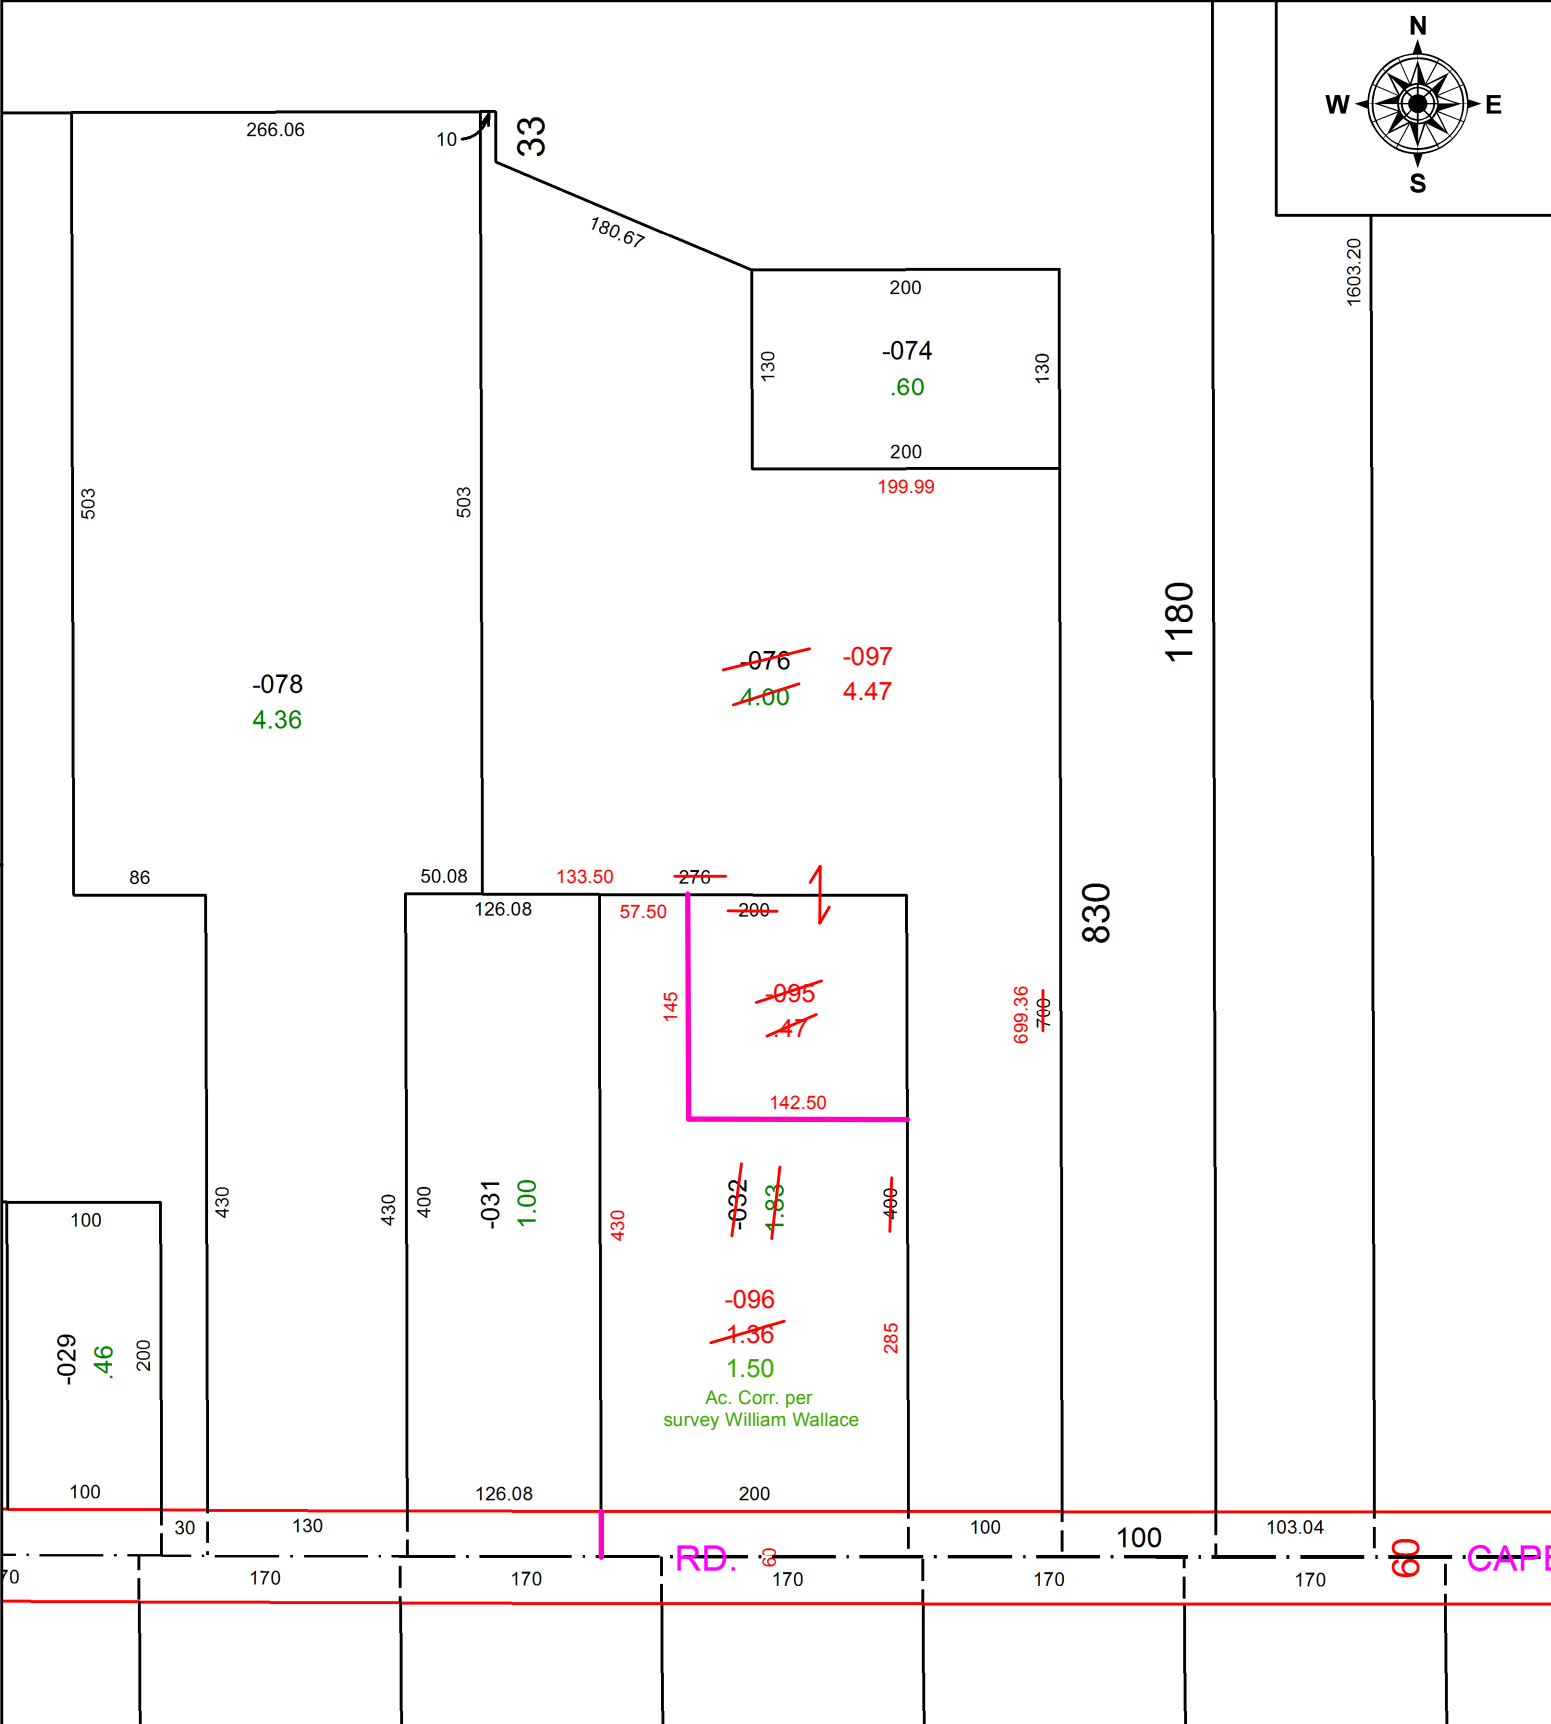
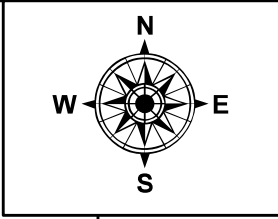


PARENT PARCEL: 11-00-077-000-032 & -076
 CHILD PARCEL: 11-00-077-000-095 THRU -097
 STARTING POINT: CL OF CAPEL RD. & DURKEE RD.

22-04447

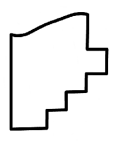

 **SPLITS/DEEDS PROCESSED**
 LORAIN COUNTY TAX MAP DEPARTMENT
 226 MIDDLE AVE. ELYRIA, OH

SURVEYED BY: WILLIAM WALLACE
CLOSURE: 1: 2147483648
MAP PAGE(S): 11-00-077
APPROVED BY: DMA **DATE:** 3/9/2022
SCALE: 1" = 125' **PRIOR INSTRUMENT:** D.V. 1133 PG. 613