
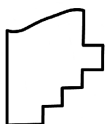
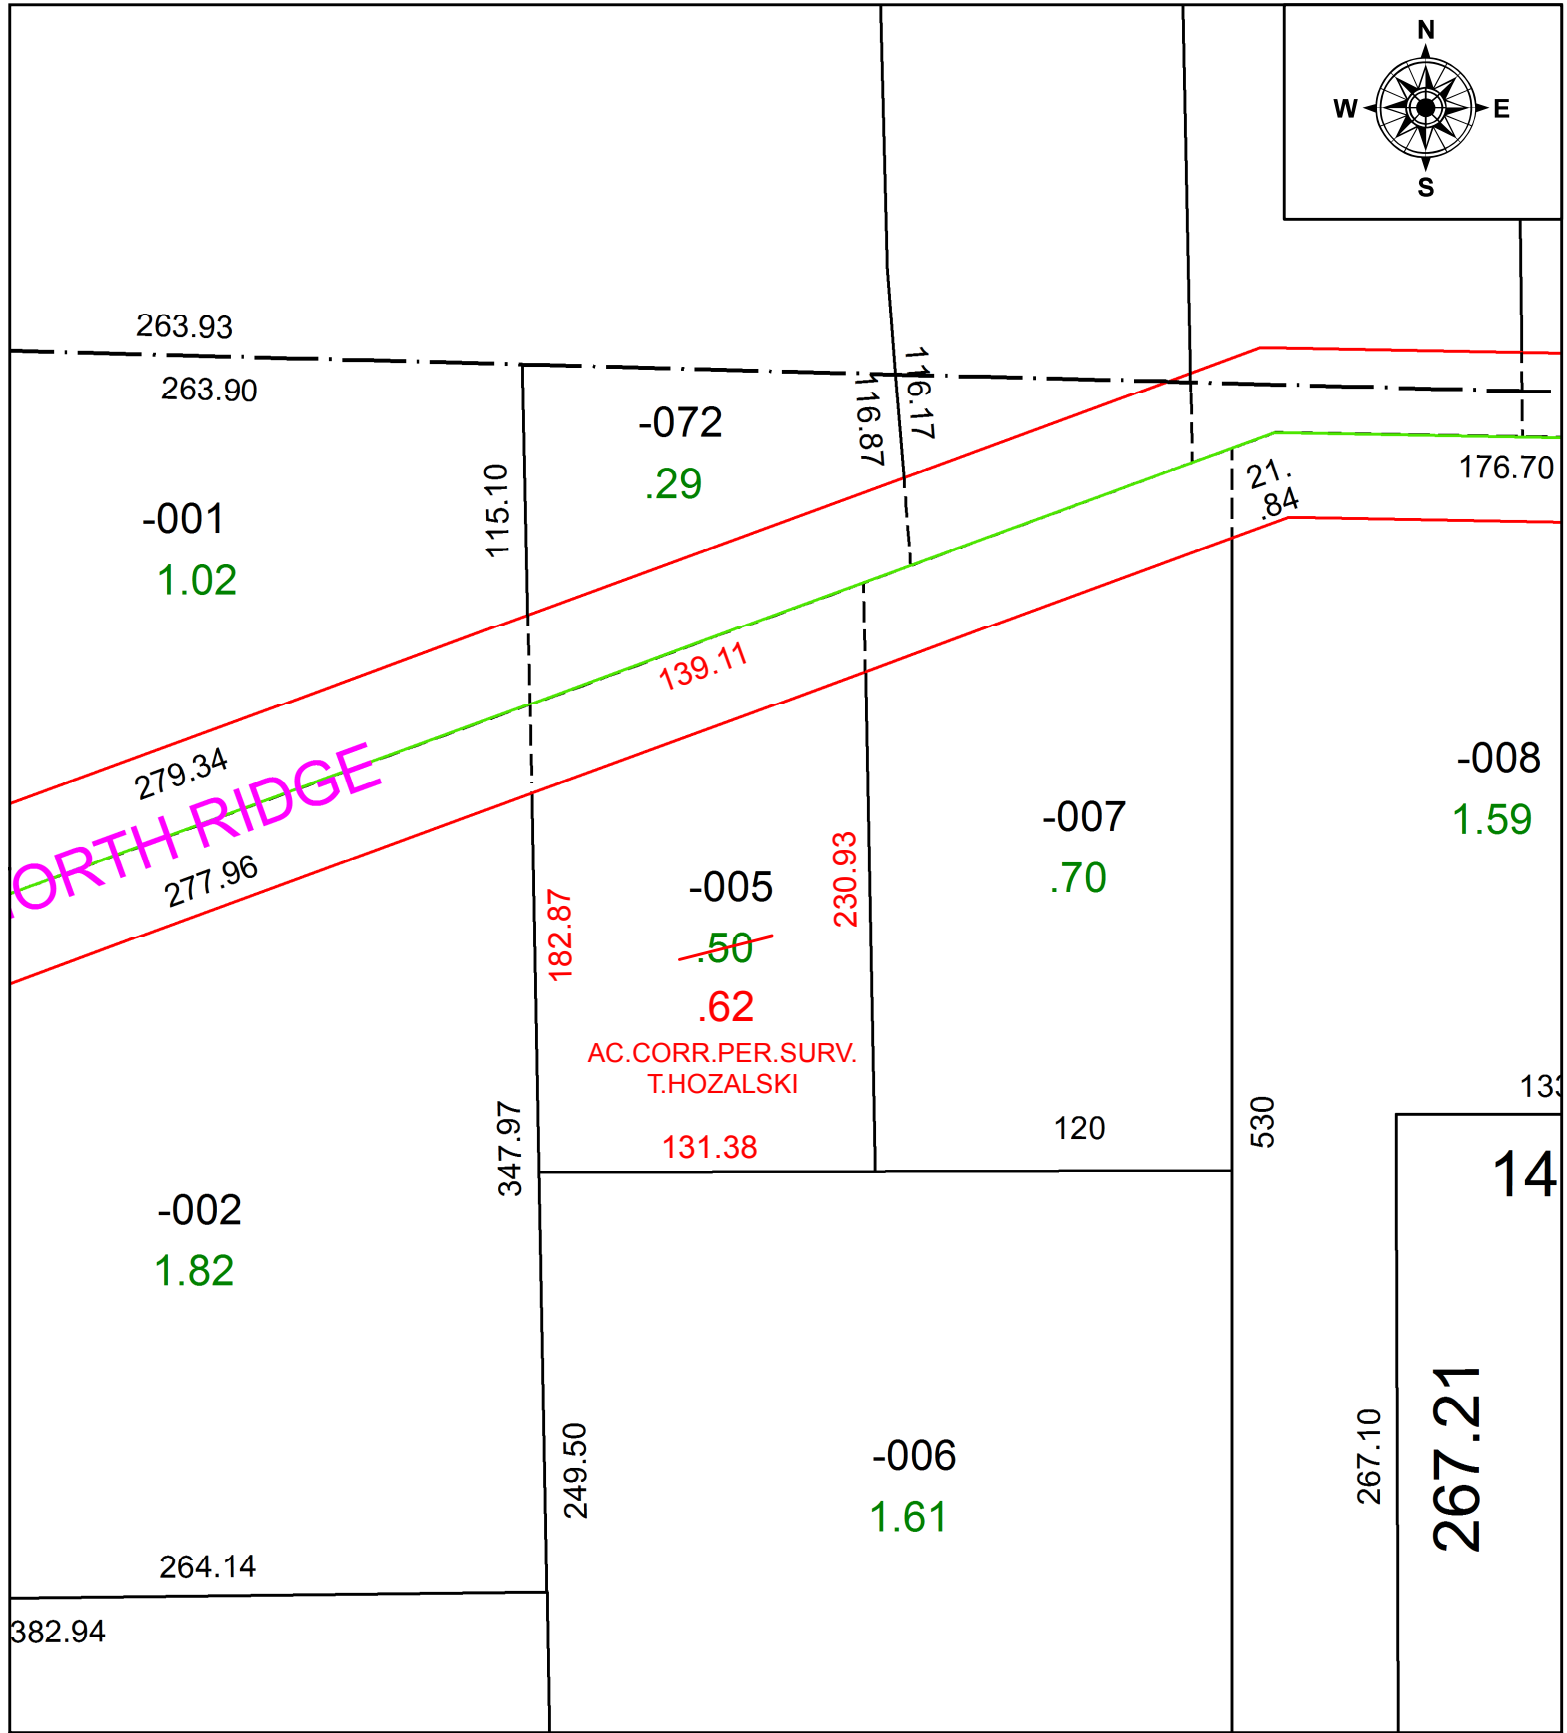


PARENT PARCEL: 01-00-043-000-005

CHILD PARCEL:

STARTING POINT: INTERSECTION OF C/L OF NORTH RIDGE RD, AND C/L OF CLAUD RD.

20-04448-A

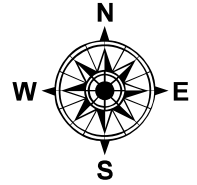

SPLITS/DEEDS PROCESSED
 LORAIN COUNTY TAX MAP DEPARTMENT
 226 MIDDLE AVE. ELYRIA, OH

SURVEYED BY: TIMOTHY D. HOZALSKI

CLOSURE: 1:124,124

MAP PAGE(S): 1-00-043

APPROVED BY: RRM DATE: 12-7-20

SCALE: 1" = 75' PRIOR INSTRUMENT: DV 38/463