
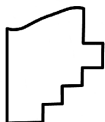


PARENT PARCEL: 11-00-016-000-030, 11-00-016-000-041

CHILD PARCEL: 11-00-016-000-091

22-04449

STARTING POINT: AC CORR PER SURV BY DANIEL P. ENGLE

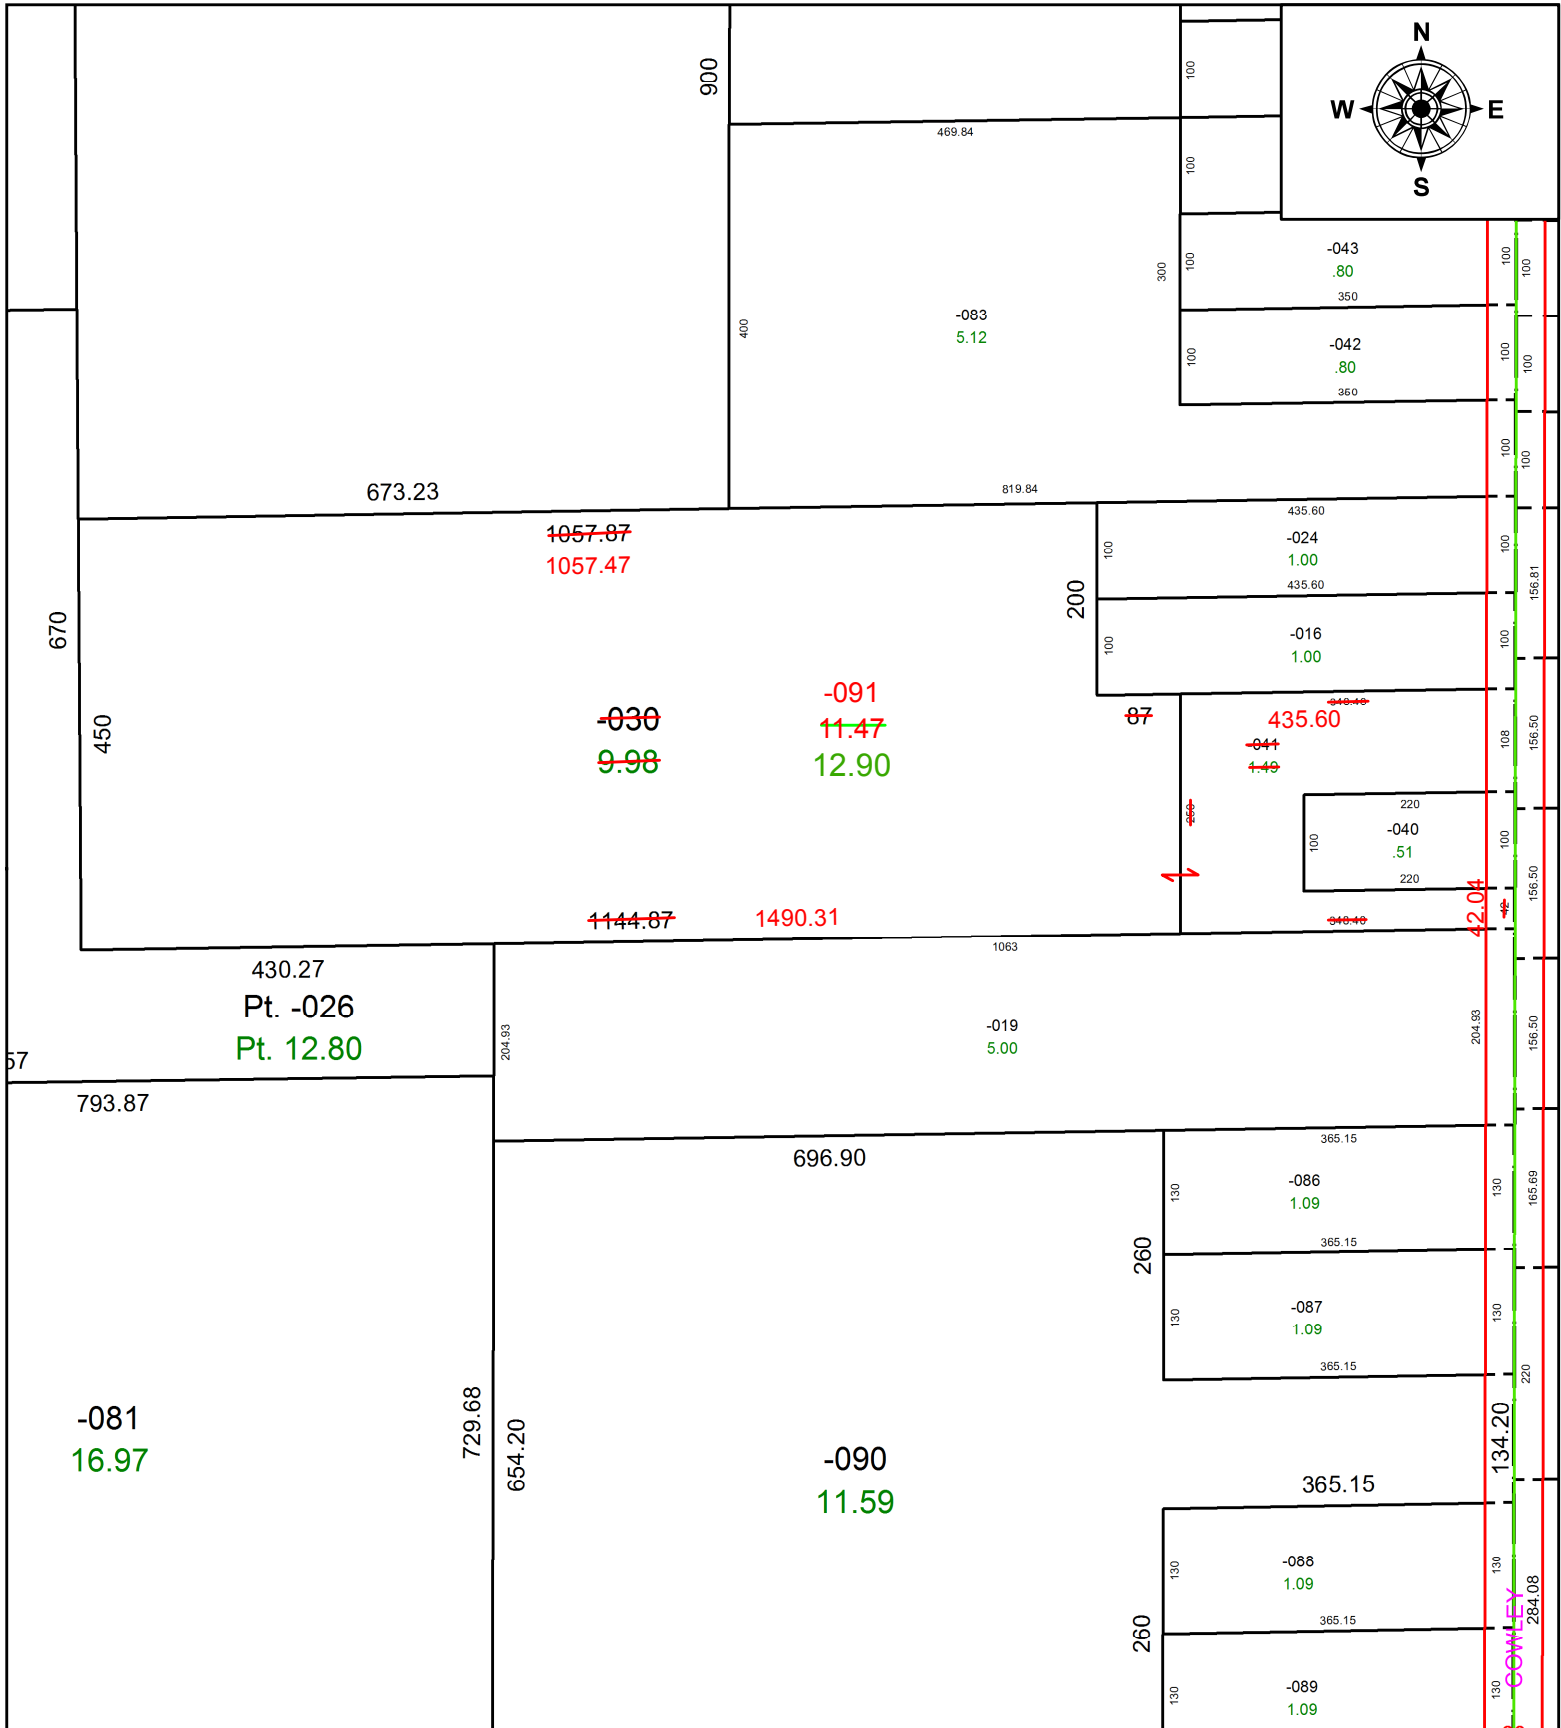

SPLITS/DEEDS PROCESSED
LORAIN COUNTY TAX MAP DEPARTMENT
226 MIDDLE AVE. ELYRIA, OH

SURVEYED BY: DANIEL P. ENGLE
 CLOSURE: 1: 689276
 MAP PAGE(S): 11-00-016
 APPROVED BY: AC DATE: 3/3/2022
 SCALE: 1" = 200 PRIOR INSTRUMENT: 2021- 0847843