


PARENT PARCEL: 06-25-015-109-019, -020

CHILD PARCEL: 06-25-015-109-044

STARTING POINT: SOUTHWEST CORNER OF S/L 51 IN AVONDALE PARK ALLOT.


20-04452-C

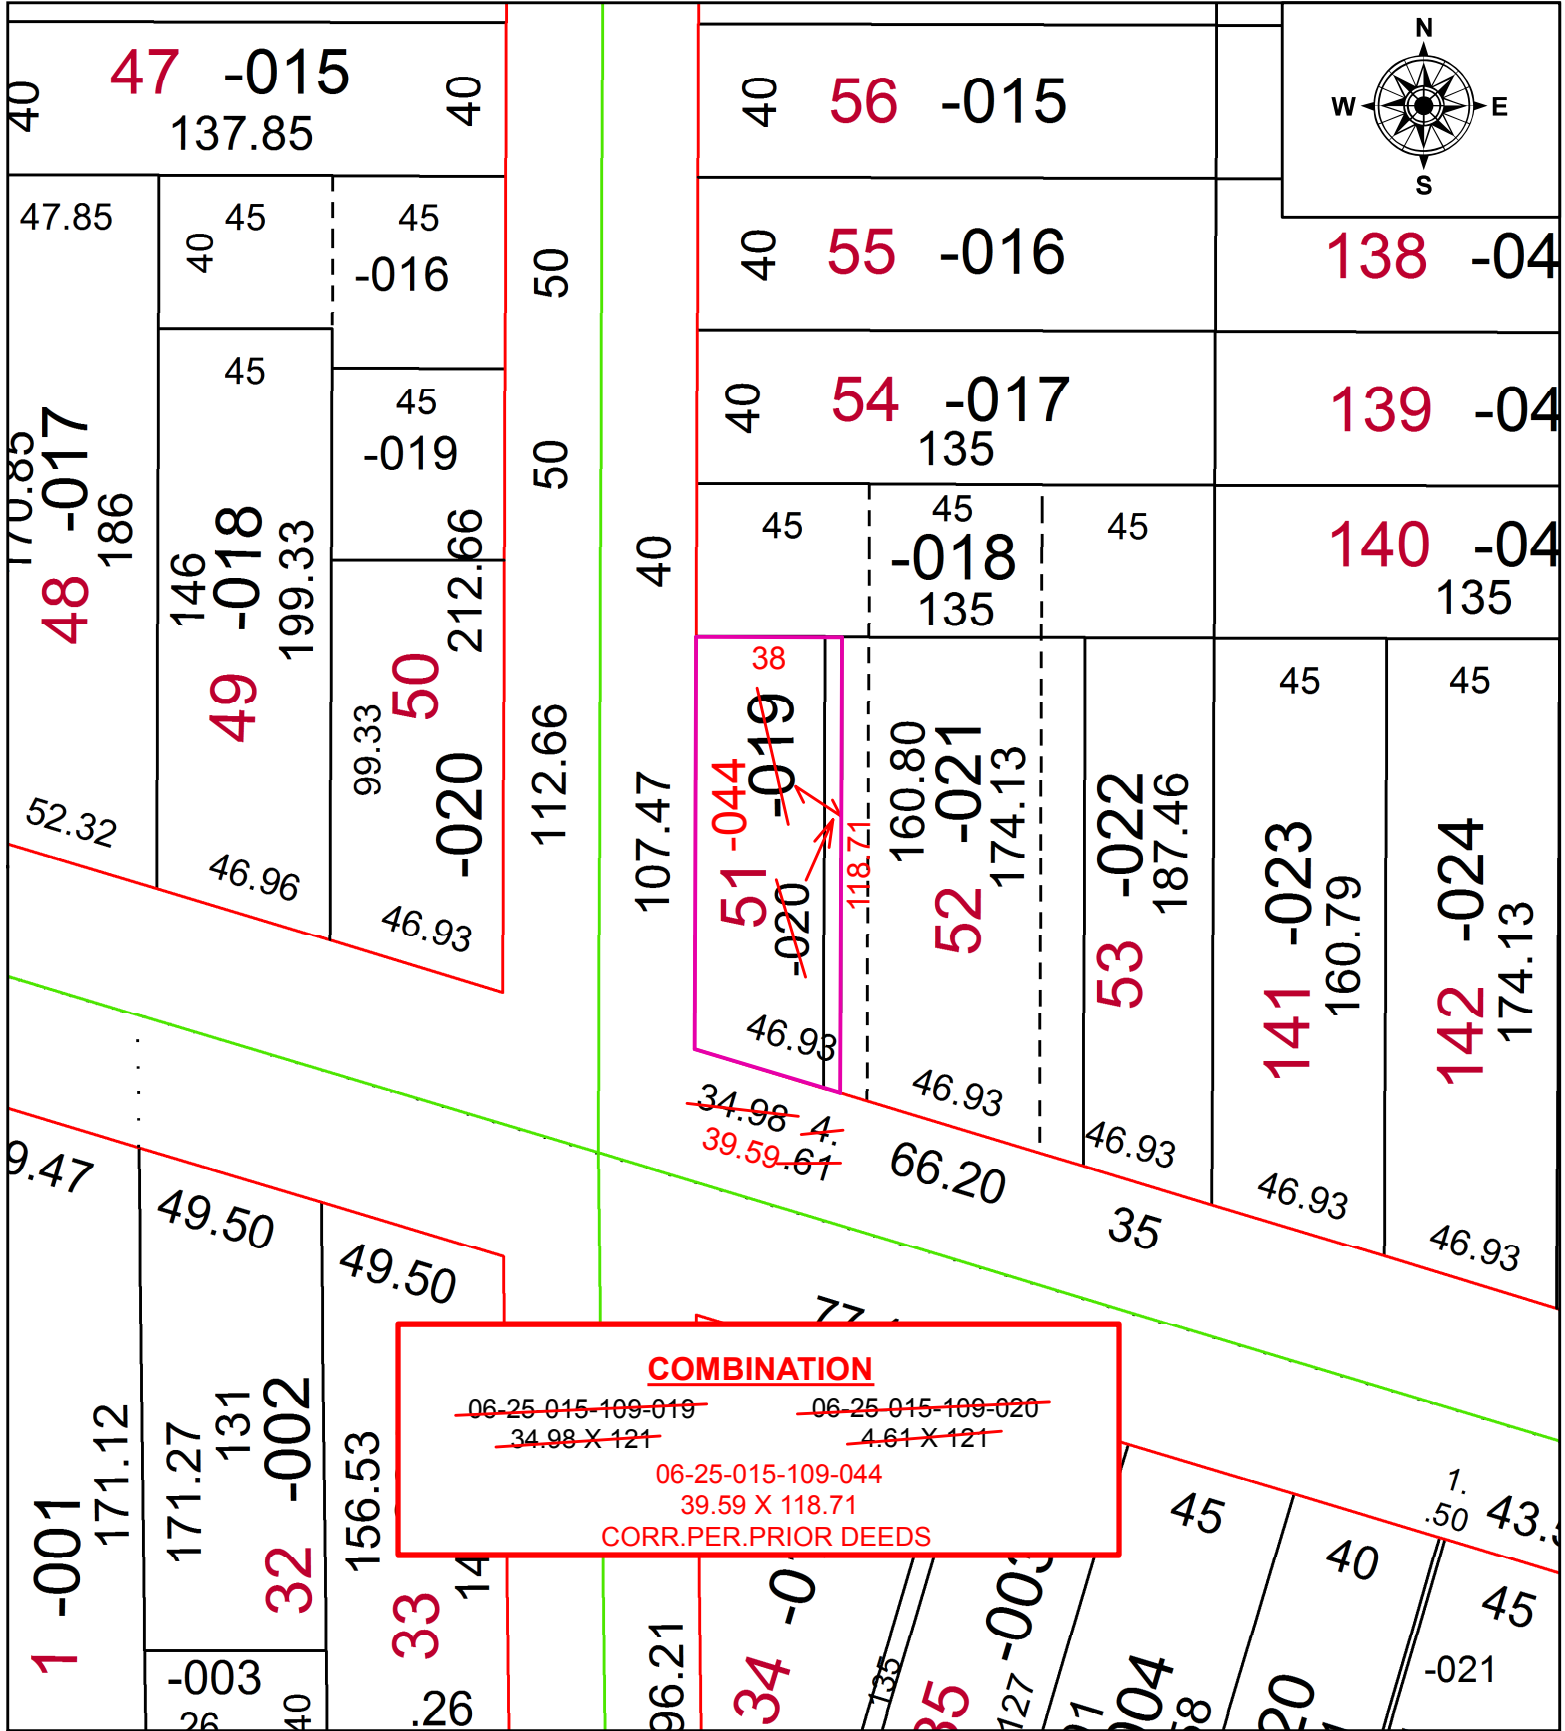

**COMBINATION**

~~06-25-015-109-019~~      ~~06-25-015-109-020~~  
~~34.98 X 121~~              ~~4.61 X 121~~

06-25-015-109-044  
39.59 X 118.71  
CORR.PER.PRIOR DEEDS

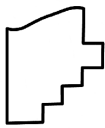

**SPLITS/DEEDS PROCESSED**  
LORAIN COUNTY TAX MAP DEPARTMENT  
226 MIDDLE AVE. ELYRIA, OH

SURVEYED BY: \_\_\_\_\_ N/A  
CLOSURE: \_\_\_\_\_ N/A  
MAP PAGE(S): \_\_\_\_\_ 6-25-015  
APPROVED BY: \_\_\_\_\_ RRM      DATE: \_\_\_\_\_ 12-11-20  
SCALE: \_\_\_\_\_ 1" = 50      PRIOR INSTRUMENT: \_\_\_\_\_ 20170636865