
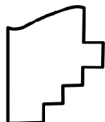


PARENT PARCEL: 19-05-038-000-011 & 19-05-007-000-012

CHILD PARCEL: 19-05-006-000-030, 19-05-007-000-013, & 19-05-038-000-035 & 036

STARTING POINT: CL OF INDIAN HOLLOW & NORTH LINE OF O.L. 6, ALSO CL OF FOSTER RD. & NORTH LINE OF O.L. 38

22-04452

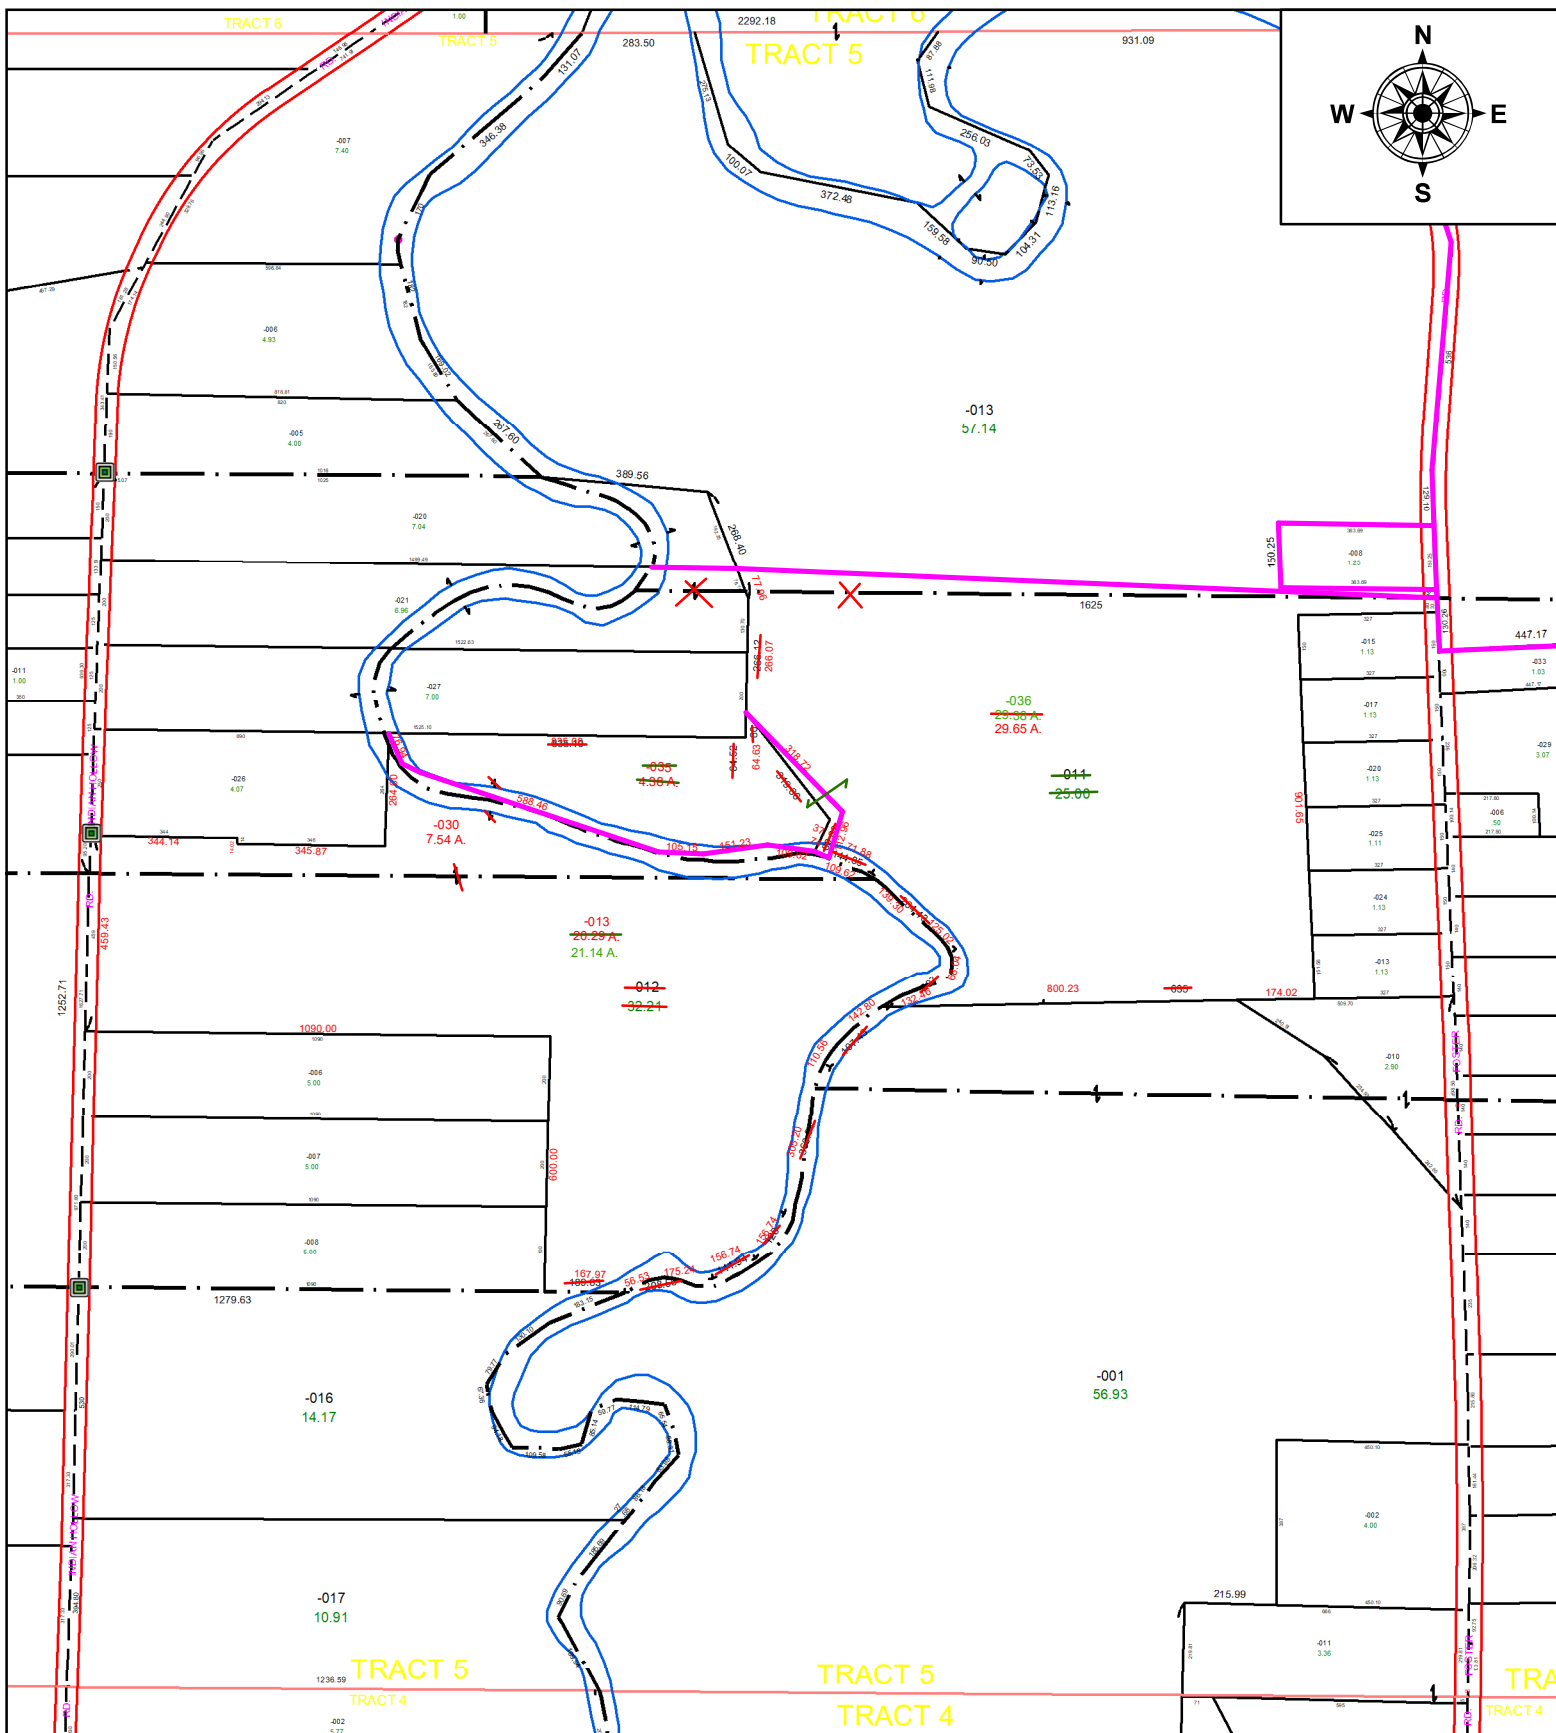

SPLITS/DEEDS PROCESSED
 LORAIN COUNTY TAX MAP DEPARTMENT
 226 MIDDLE AVE. ELYRIA, OH

SURVEYED BY: MIKE STRAUB
 CLOSURE: 1: 250,000
 MAP PAGE(S): 19-05-038, -007, & -006
 APPROVED BY: TJS DATE: 4/4/2022
 SCALE: 1" = 450' PRIOR INSTRUMENT: 2021-0841227