
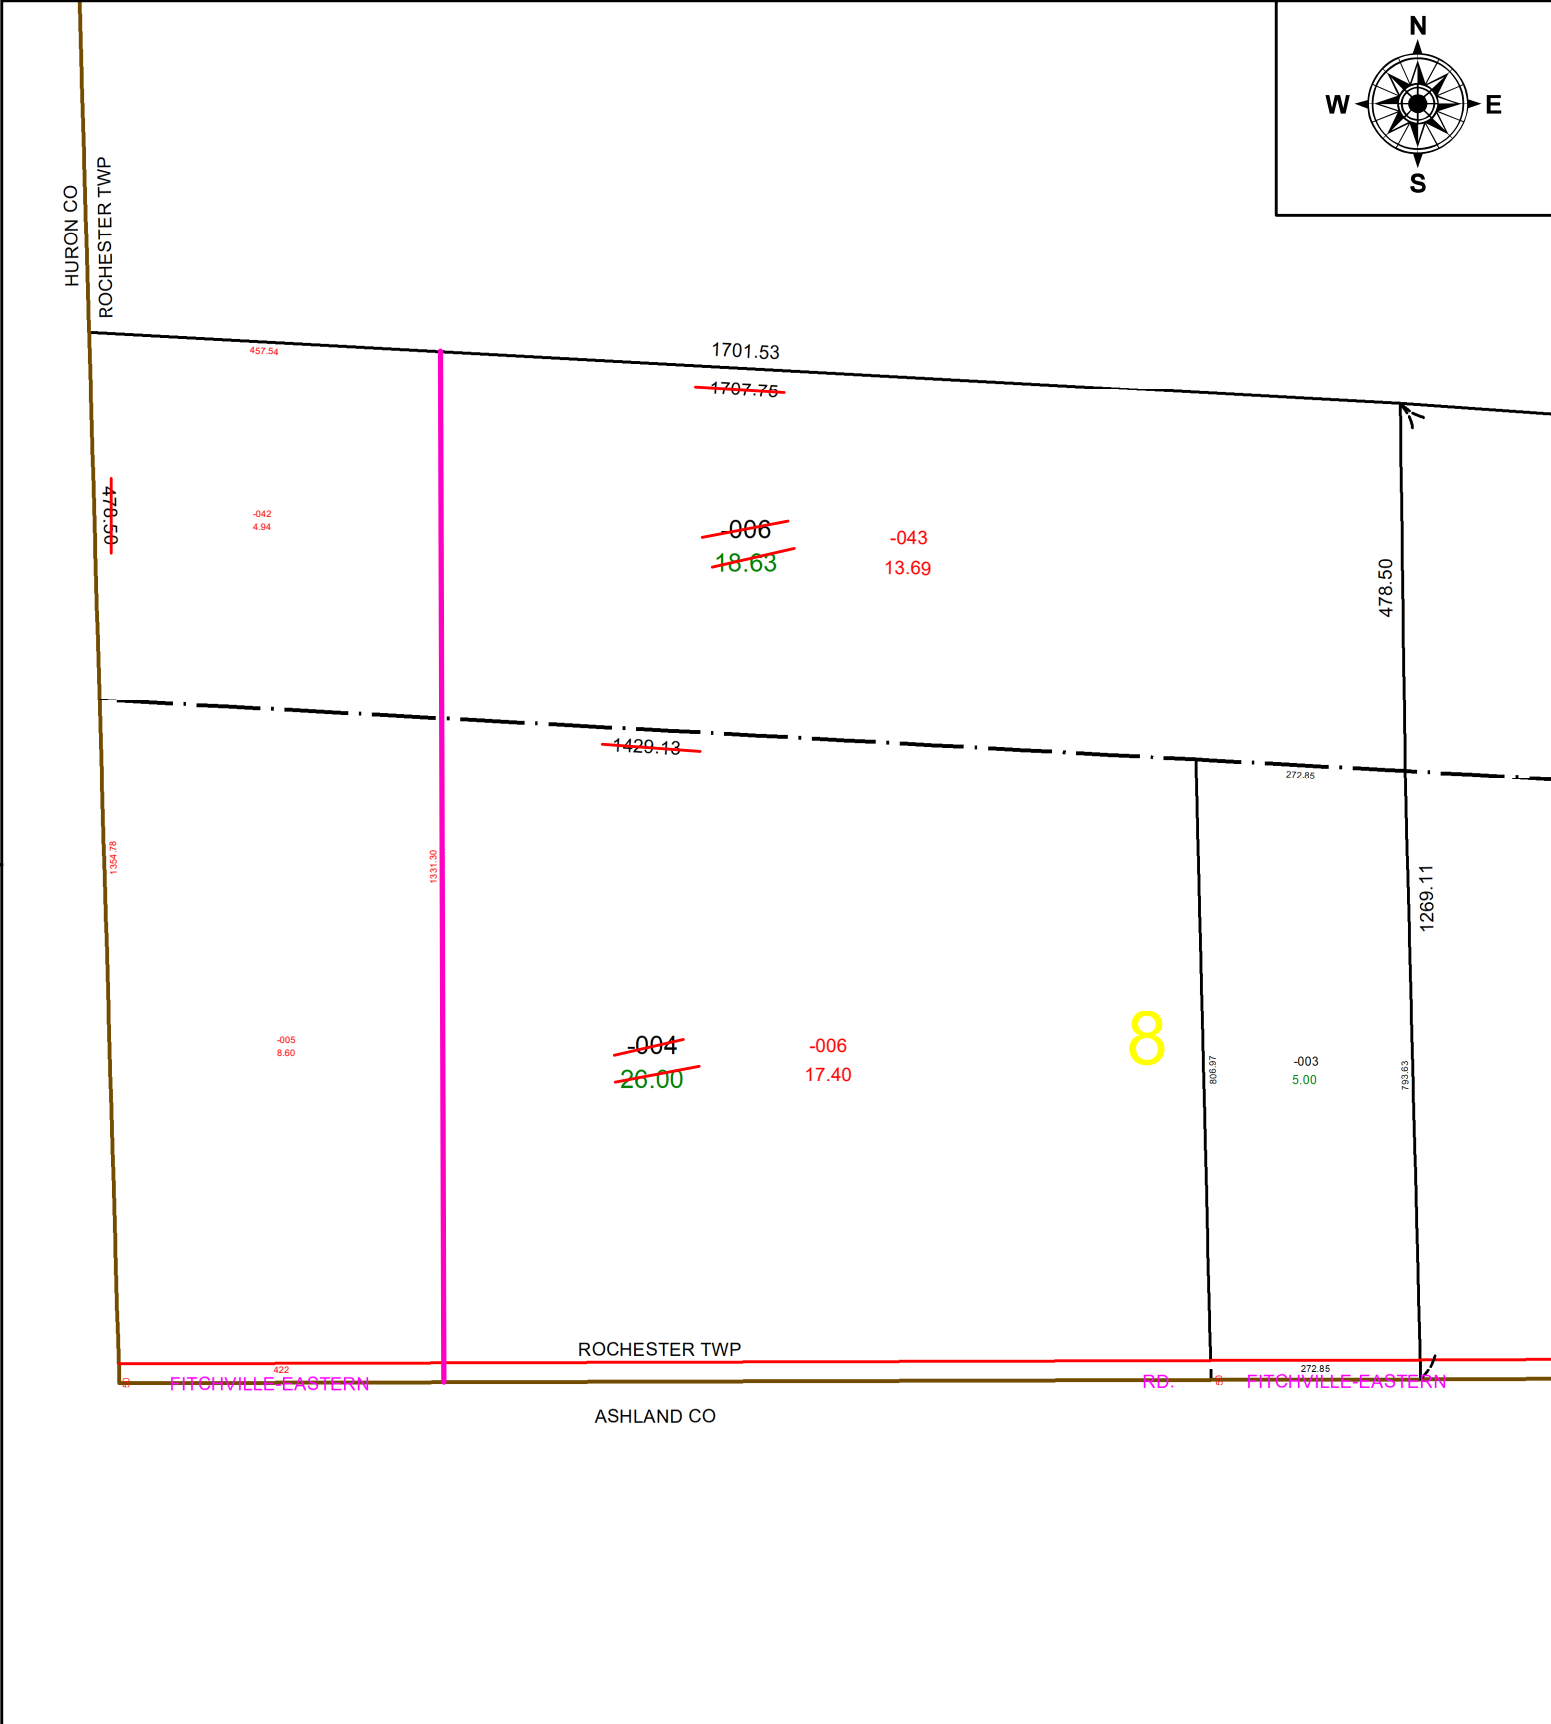
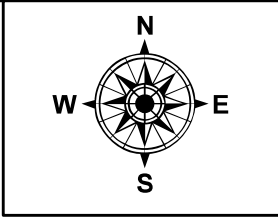


PARENT PARCEL: 20-20-008-000-004 & 20-20-009-000-006
 CHILD PARCEL: 20-20-008-000-005 & -006 AND 20-20-009-000-042 & -043
 STARTING POINT: S.W. CORNER OF O.L. 8

22-04453

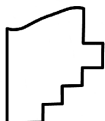

 **SPLITS/DEEDS PROCESSED**
 LORAIN COUNTY TAX MAP DEPARTMENT
 226 MIDDLE AVE. ELYRIA, OH

SURVEYED BY: GARY WEIGLER
 CLOSURE: 1: 574,087
 MAP PAGE(S): 20-20-008 & -009
 APPROVED BY: DMA DATE: 3/28/2022
 SCALE: 1" = 250' PRIOR INSTRUMENT: 2010-0355220