
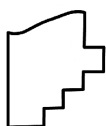


PARENT PARCEL: 05-00-001-000-053, -071

CHILD PARCEL: 05-00-001-000-301

STARTING POINT: INTERSECTION OF C/L OF OAK POINT RD. AND NORTH LINE OF O.L.1

20-04454-C

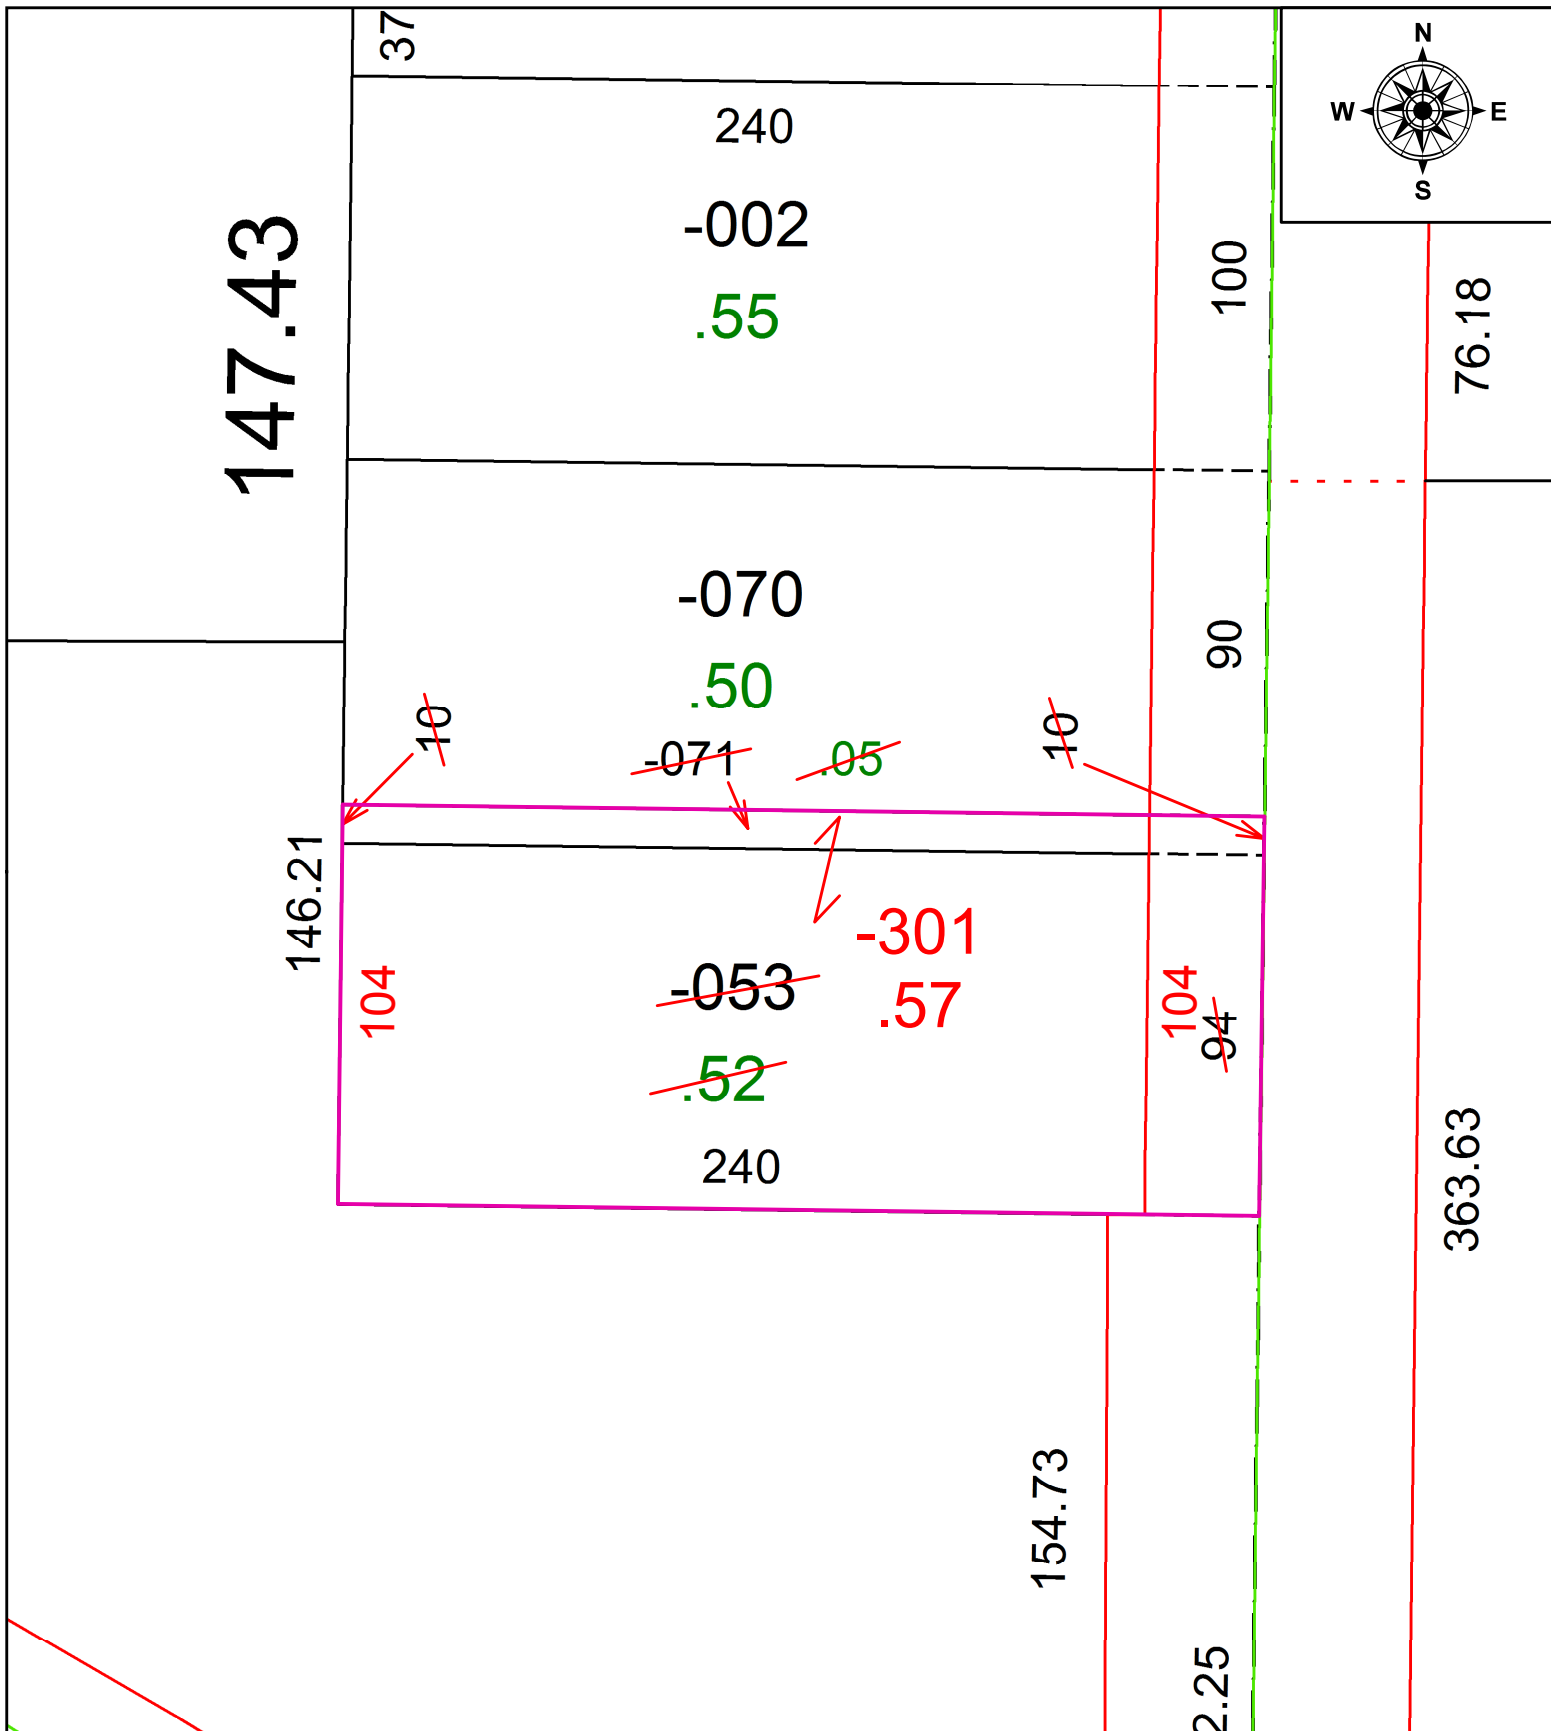

SPLITS/DEEDS PROCESSED
 LORAIN COUNTY TAX MAP DEPARTMENT
 226 MIDDLE AVE. ELYRIA, OH

SURVEYED BY: _____ N/A
 CLOSURE: 1:2147483648
 MAP PAGE(S): 5-00-001
 APPROVED BY: RRM DATE: 12-15-20
 SCALE: 1" = 50 PRIOR INSTRUMENT: 20110362517