


PARENT PARCEL: 04-00-007-640-003 (WITHIN PPN 04-00-007-104-016)

CHILD PARCEL: **ADD TO DUP. SUBMERGED LAND LEASE**

STARTING POINT: CL OF LAKE RD. 7 S.W. CORNER OF BARTHOLOMEW

22-04454

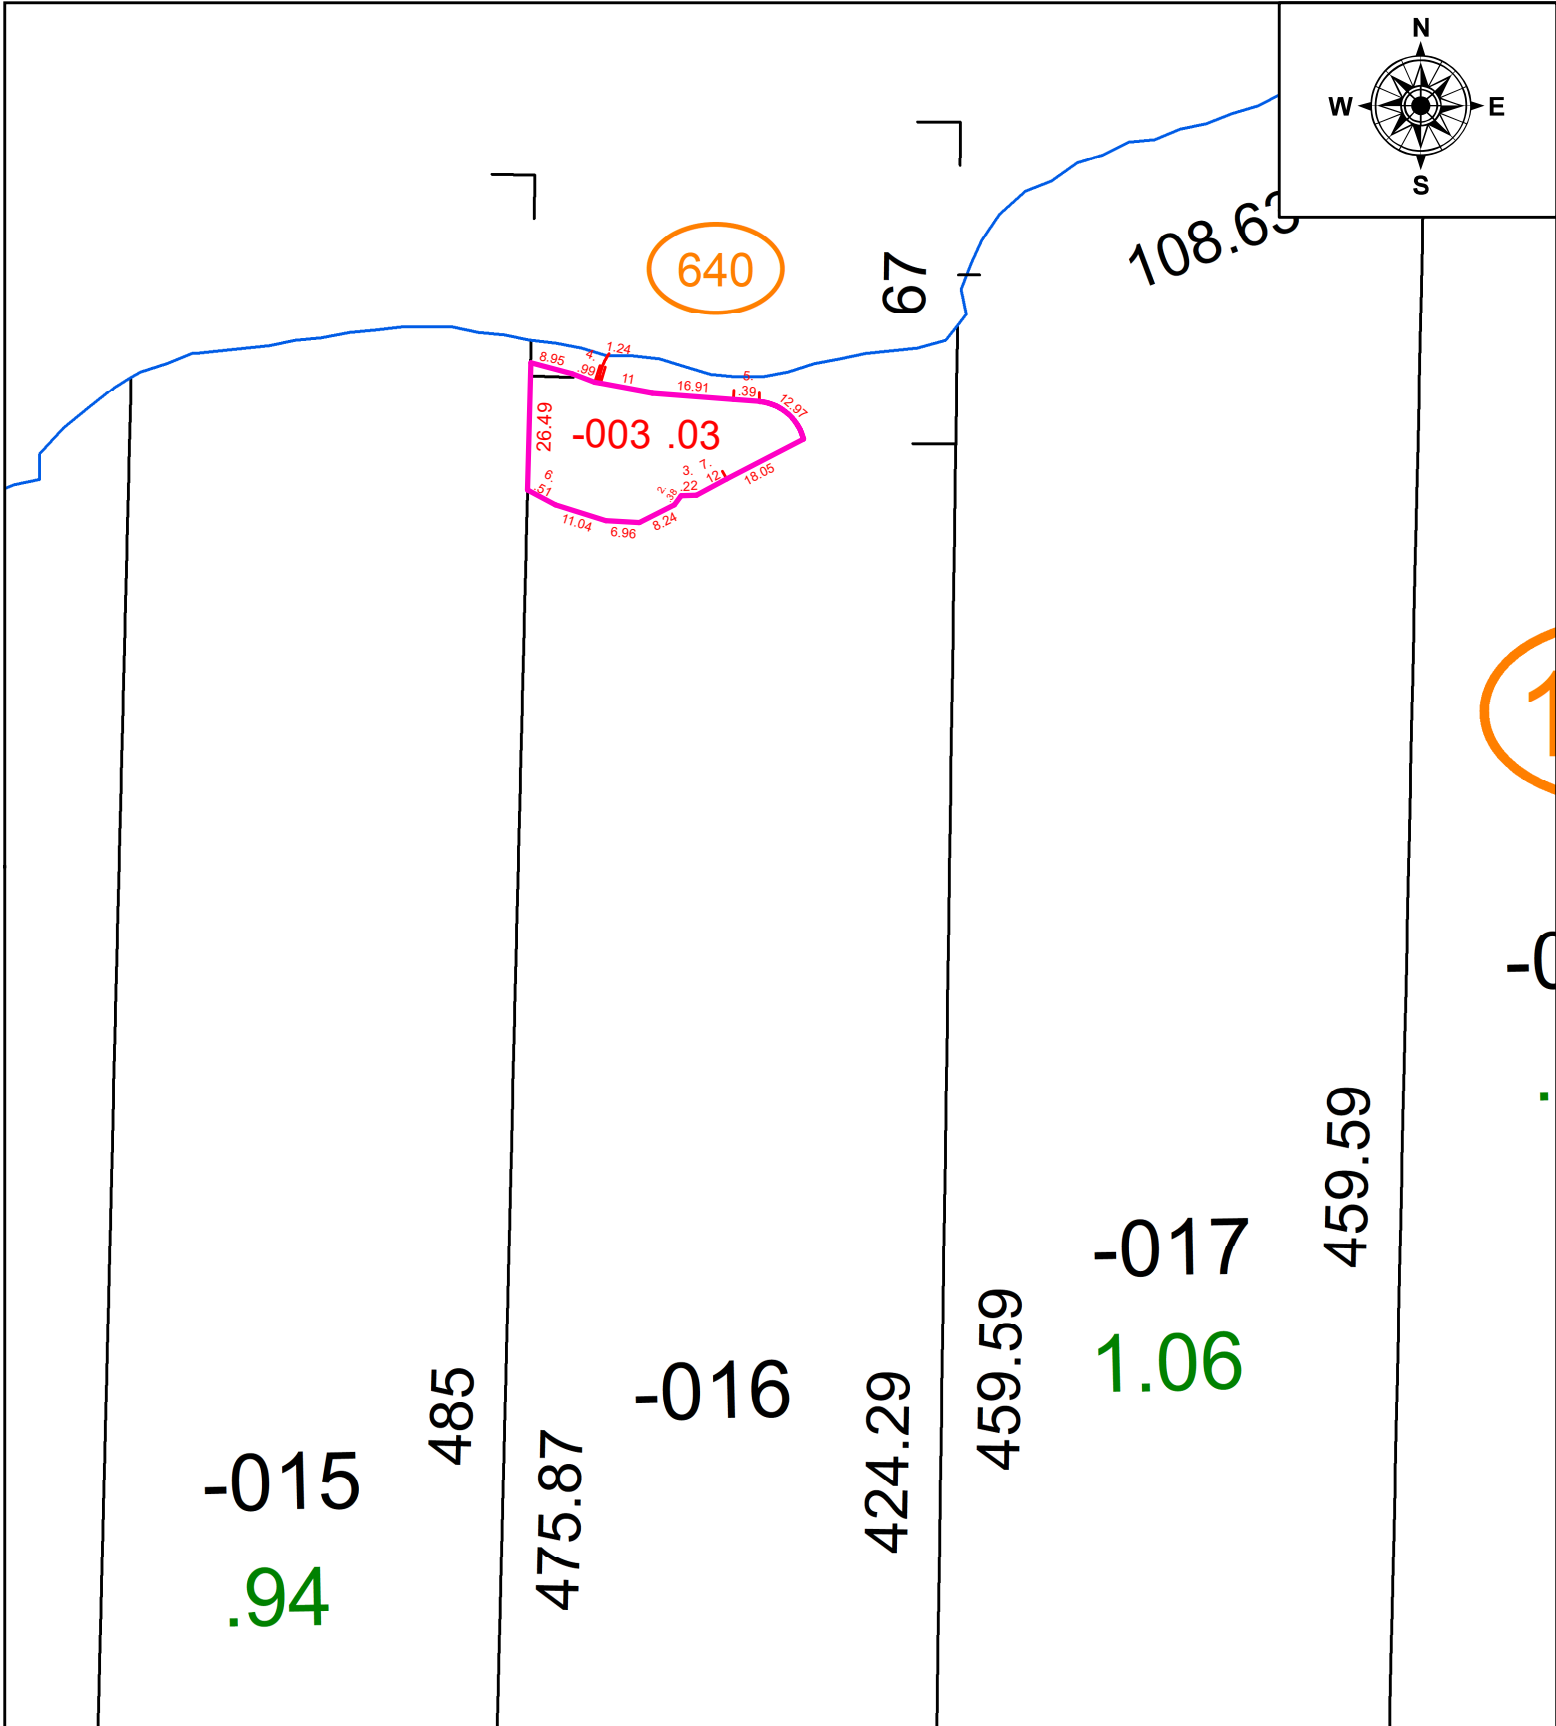

SPLITS/DEEDS PROCESSED
LORAIN COUNTY TAX MAP DEPARTMENT
226 MIDDLE AVE. ELYRIA, OH

SURVEYED BY:	THOMAS SNEZEK
CLOSURE:	1: 10719
MAP PAGE(S):	04-00-007
APPROVED BY:	DMA DATE: 4/4/2022
SCALE:	1" = 40'
PRIOR INSTRUMENT:	N/A