


PARENT PARCEL: 09-00-100-000-052, -053

CHILD PARCEL: _____

STARTING POINT: _____

20-04456-C

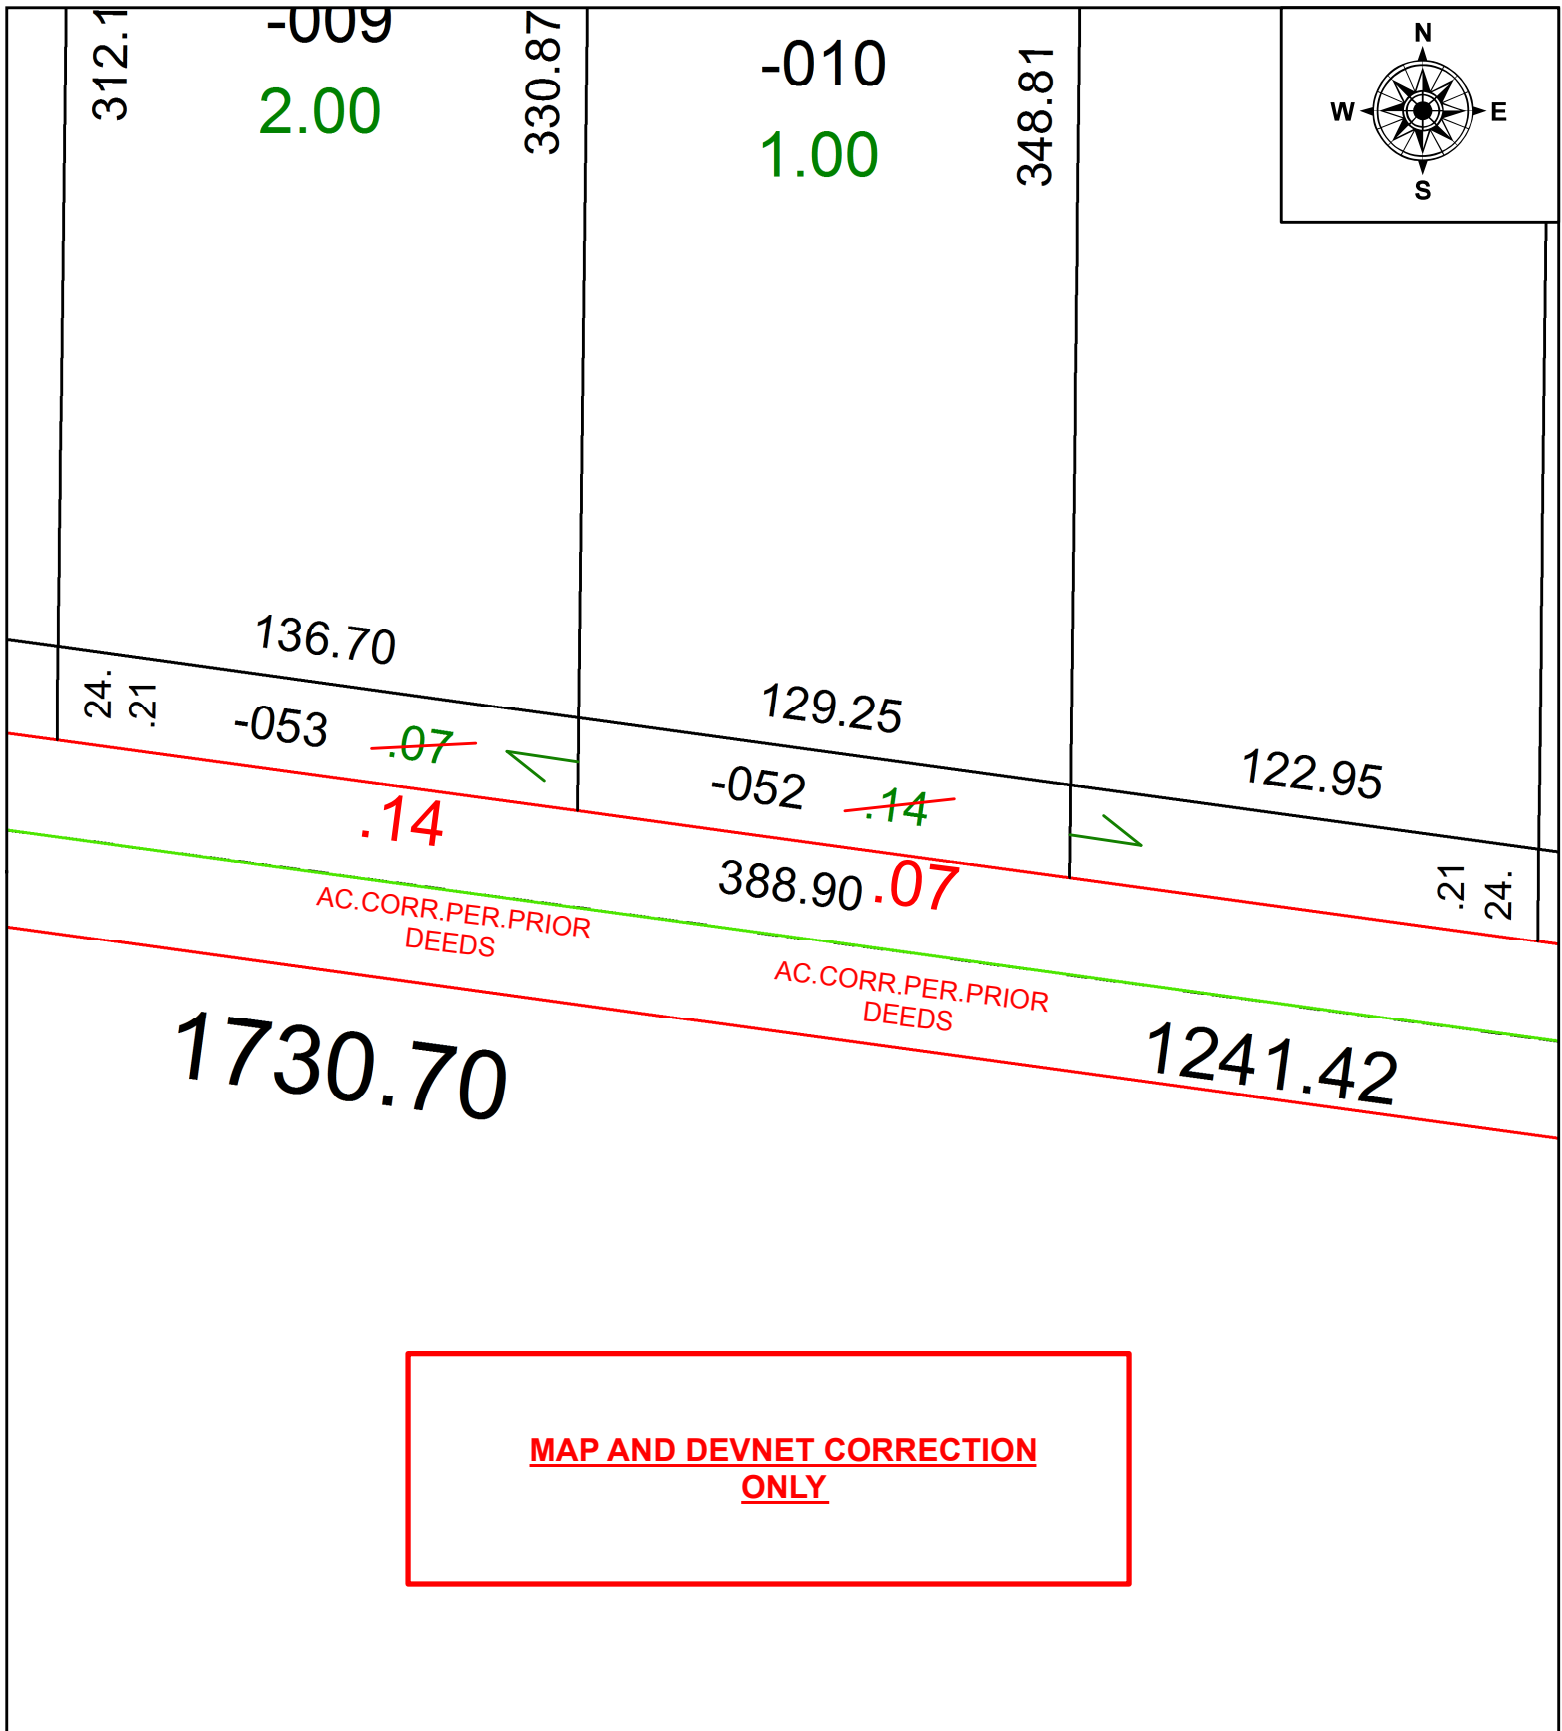

MAP AND DEVNET CORRECTION ONLY



SPLITS/DEEDS PROCESSED
LORAIN COUNTY TAX MAP DEPARTMENT
226 MIDDLE AVE. ELYRIA, OH

SURVEYED BY:	N/A		
CLOSURE:	N/A		
MAP PAGE(S):	9-00-100		
APPROVED BY:	RRM	DATE:	12-15-20
SCALE:	1" = 50'	PRIOR INSTRUMENT:	OR 742/847