



PARENT PARCEL: 03-00-066-103-078 & -079


CHILD PARCEL: 03-00-066-103-081 (COMBINATION)

STARTING POINT: CL OF LINDA LN & SHEFFIELD FRENCH CREEK RD.

22-04456

66

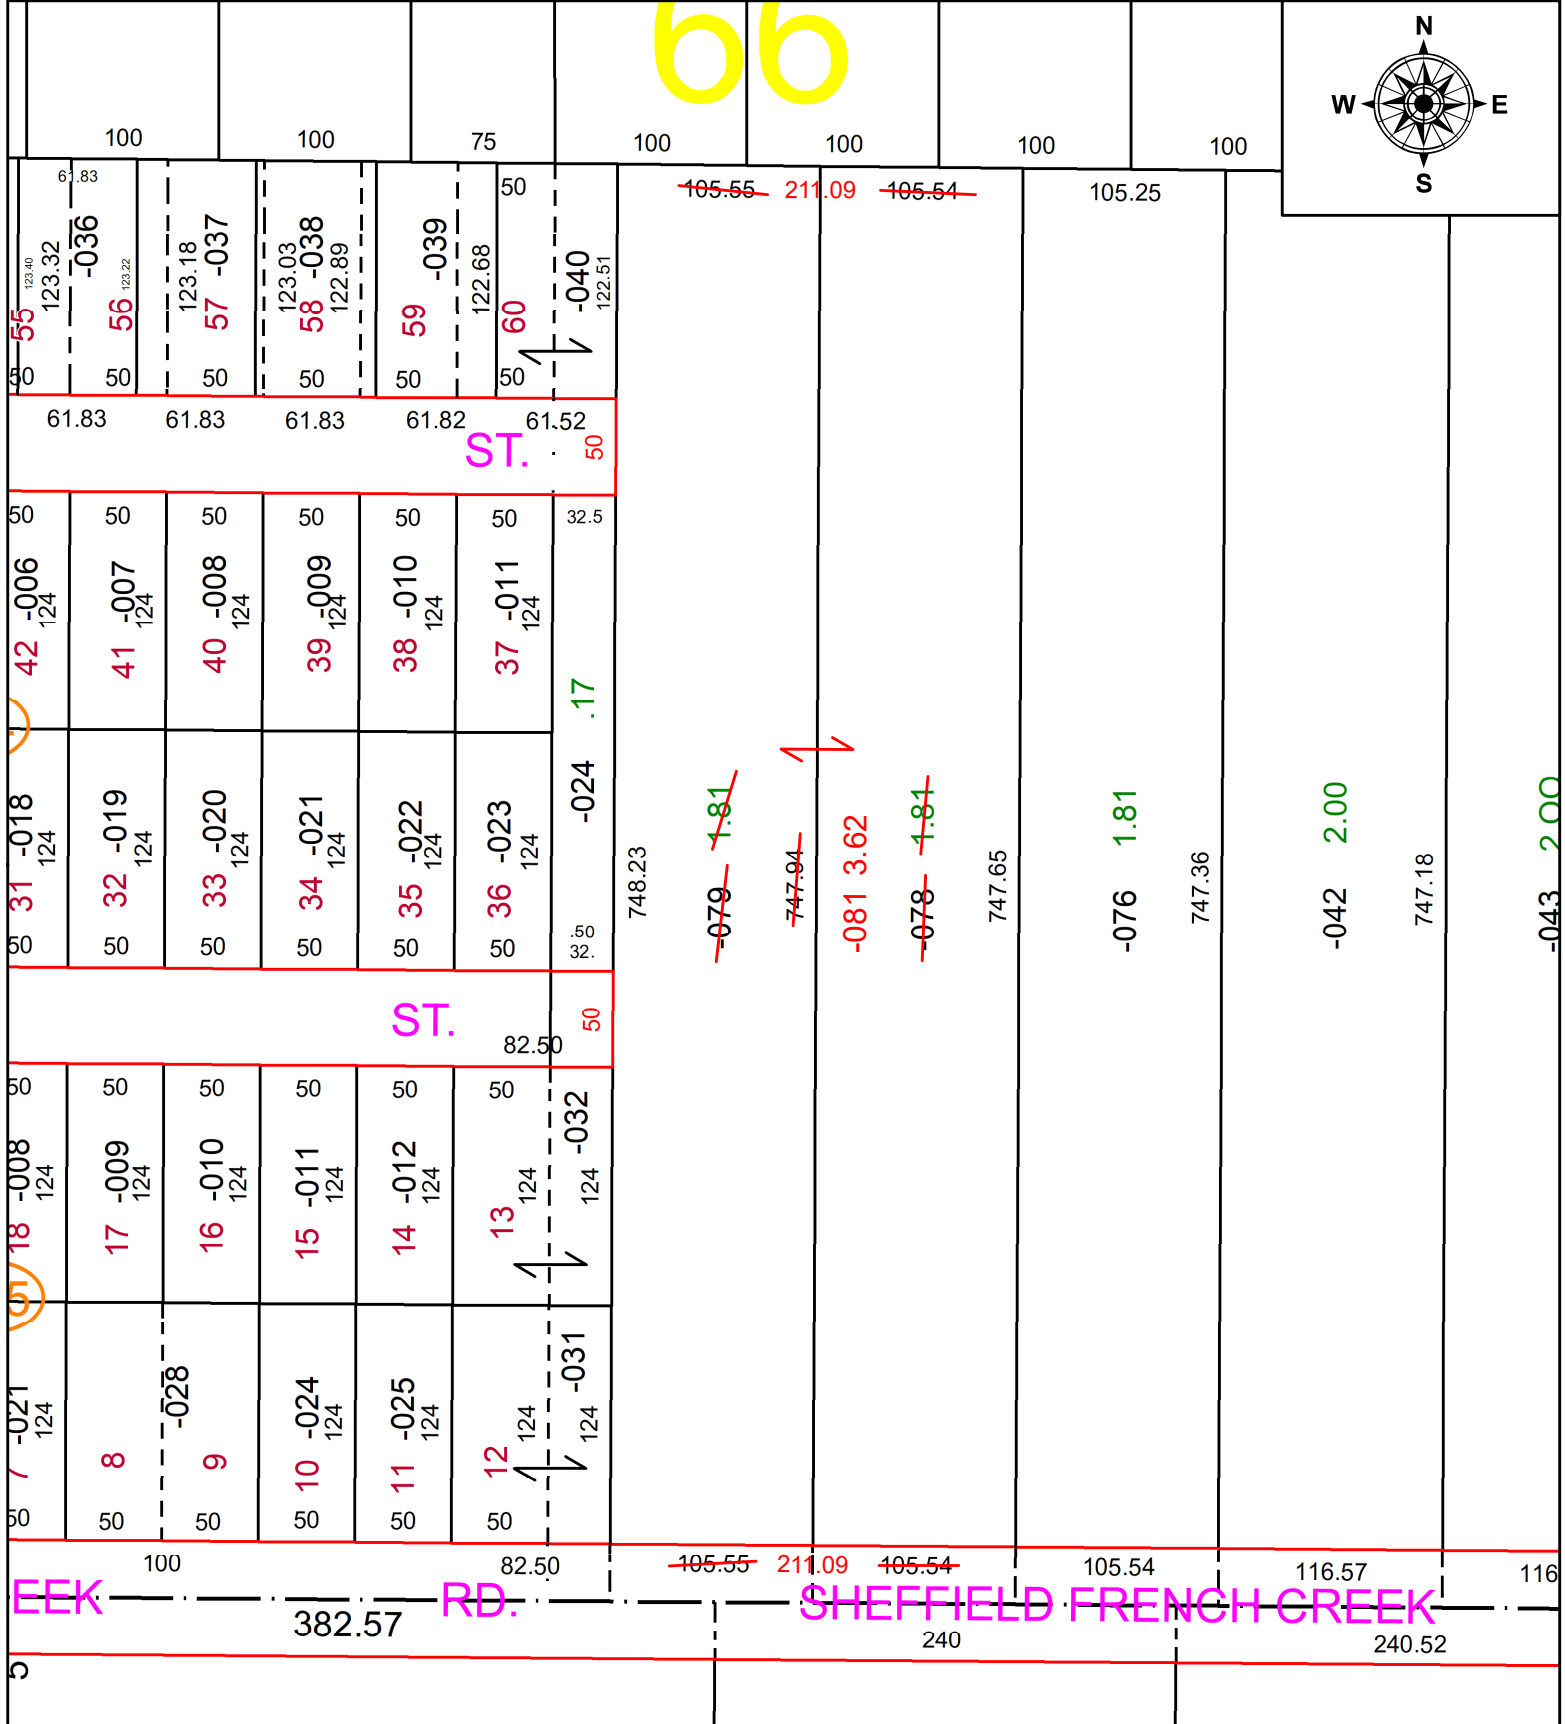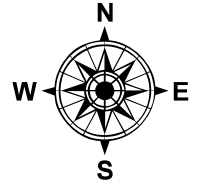

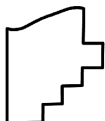 **SPLITS/DEEDS PROCESSED**
 LORAIN COUNTY TAX MAP DEPARTMENT
 226 MIDDLE AVE. ELYRIA, OH

SURVEYED BY: THOMAS SIMON
CLOSURE: 1: 483,909
MAP PAGE(S): 03-00-066
APPROVED BY: DMA **DATE:** 4/5/2022
SCALE: 1" = 100' **PRIOR INSTRUMENT:** 2021-0848109