
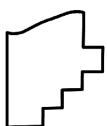


PARENT PARCEL: 10-00-016-000-016

20-04459-A

CHILD PARCEL:

STARTING POINT: INTERSECTION OF C/L OF SLIFE RD. AND C/L OF INDIAN HOLLOW RD.

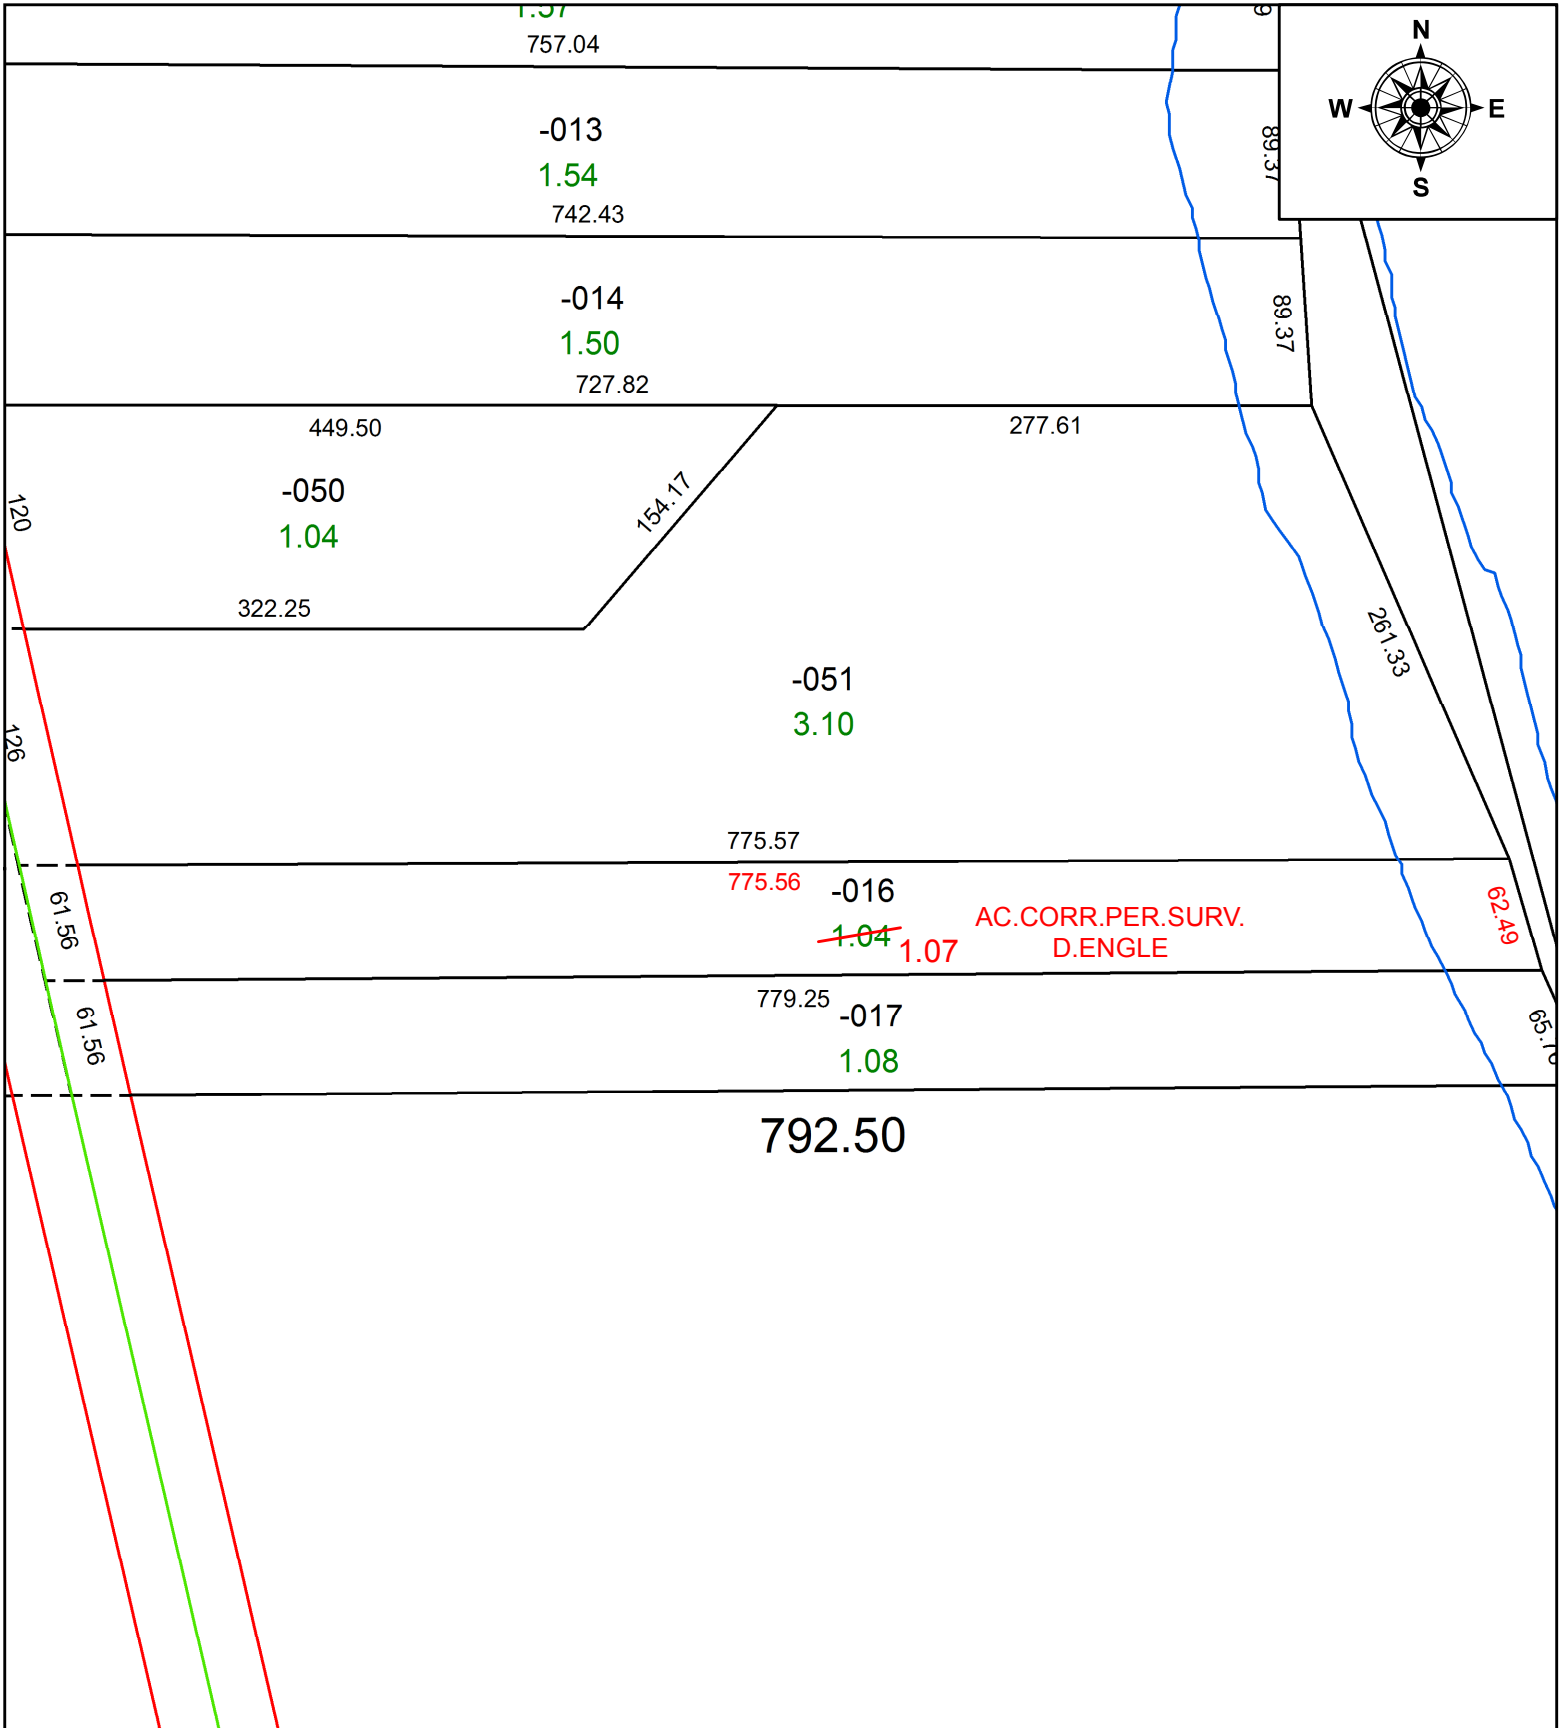

SPLITS/DEEDS PROCESSED
 LORAIN COUNTY TAX MAP DEPARTMENT
 226 MIDDLE AVE. ELYRIA, OH

SURVEYED BY: DANIEL P. ENGLE

CLOSURE: 1: 719,585

MAP PAGE(S): 10-00-016

APPROVED BY: RRM **DATE:** 12-17-20

SCALE: 1" = 100 **PRIOR INSTRUMENT:** 20100352361