
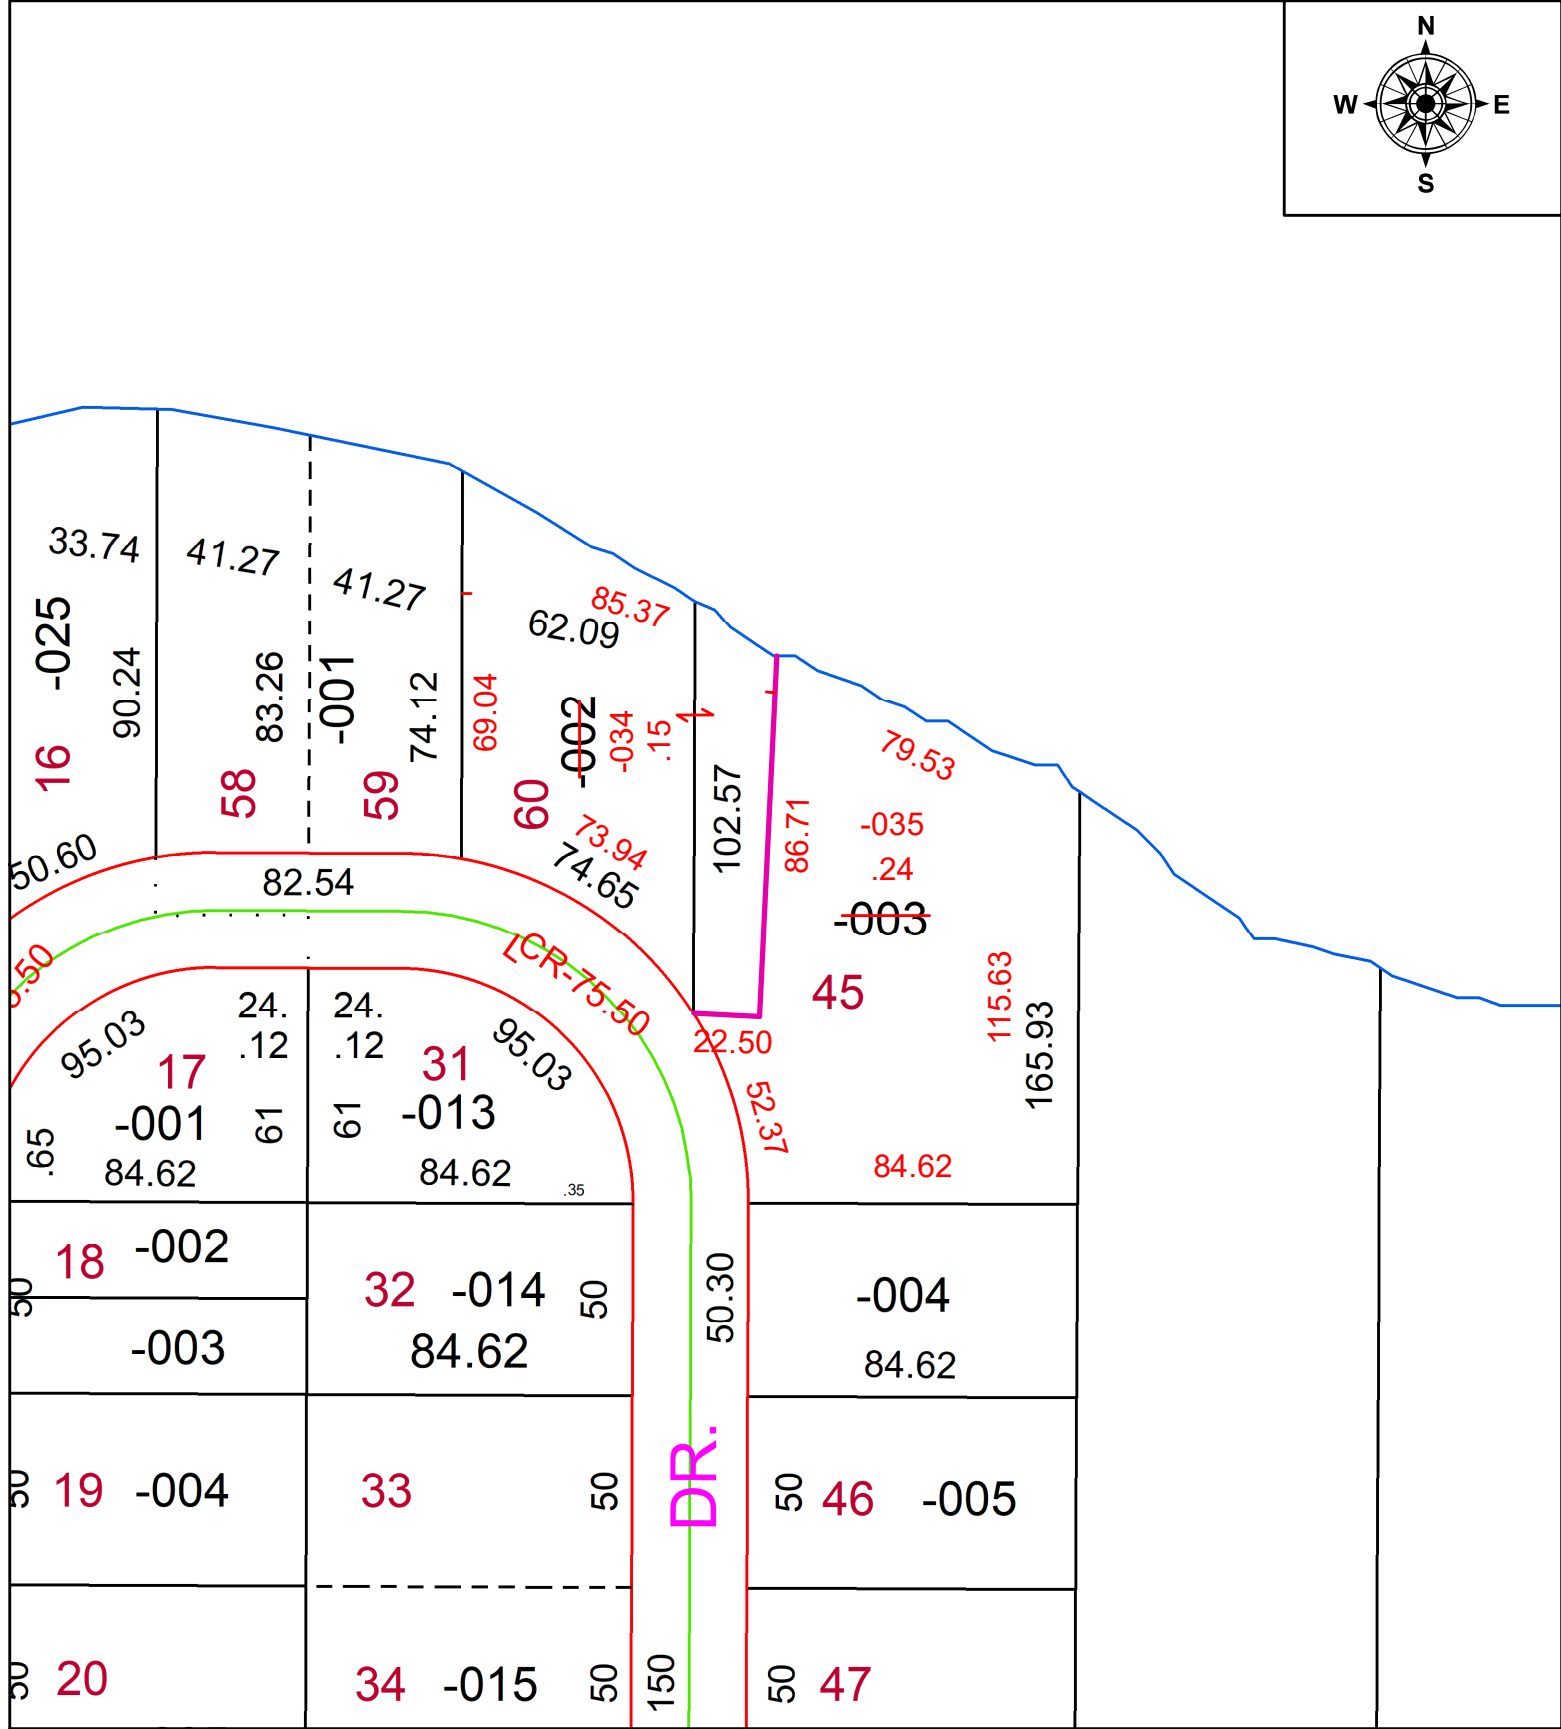



PARENT PARCEL: 04-00-018-132-002, -003

CHILD PARCEL: 04-00-018-132-034, -035

STARTING POINT: **FRONTAGE & DEPTH TO AC CORR PER SURV BY JAMES RESAR**

22-04460

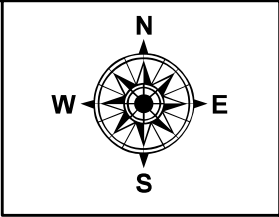

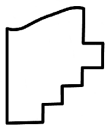 **SPLITS/DEEDS PROCESSED**  
 LORAIN COUNTY TAX MAP DEPARTMENT  
 226 MIDDLE AVE. ELYRIA, OH

**SURVEYED BY:** JAMES RESAR  
**CLOSURE:** 1: 117642  
**MAP PAGE(S):** 04-00-018-D  
**APPROVED BY:** AC **DATE:** 4/13/2022  
**SCALE:** 1" = 50 **PRIOR INSTRUMENT:** 2020- 0789553