


PARENT PARCEL: 04-00-027-101-195

CHILD PARCEL: 04-00-027-101-199 THRU -202



AC CORR. PER AMY KELLY

22-04466

STARTING POINT: INTERSECTION OF C/LS OF NAGEL RD & AVON RD AT A MONUMENT BOX

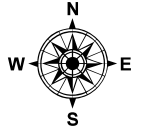

442.76

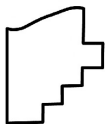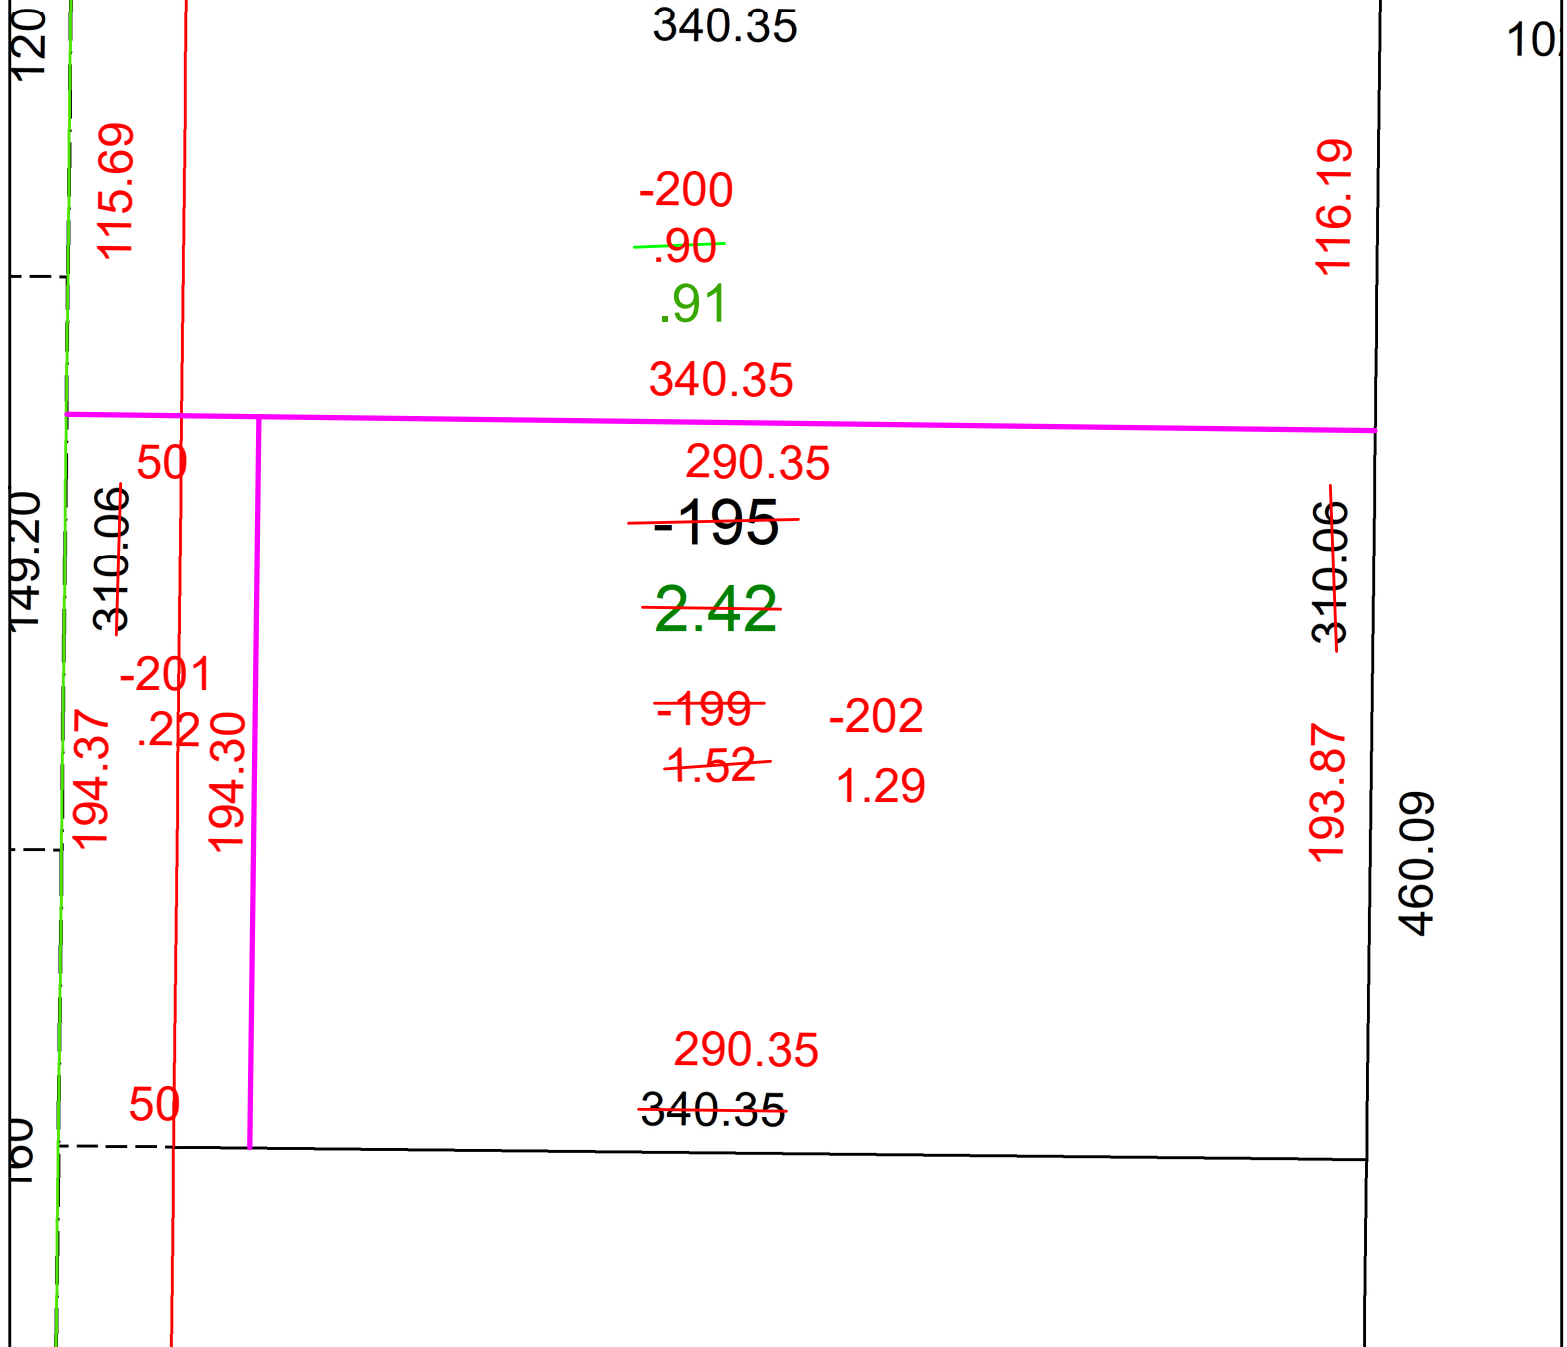

SPLITS/DEEDS PROCESSED
 LORAIN COUNTY TAX MAP DEPARTMENT
 226 MIDDLE AVE. ELYRIA, OH

SURVEYED BY: AMY KELLY
 CLOSURE: 1: 319393
 MAP PAGE(S): 04-00-027
 APPROVED BY: WRZ DATE: 4/21/2022
 SCALE: 1" = 50 PRIOR INSTRUMENT: 2017-0638390