


PARENT PARCEL: 16-00-094-000-018, -020

CHILD PARCEL: 16-00-094-000-022, -023

STARTING POINT: SW CORNER OF LOT 94 AND C/L OF DUNHAM RD

22-04468

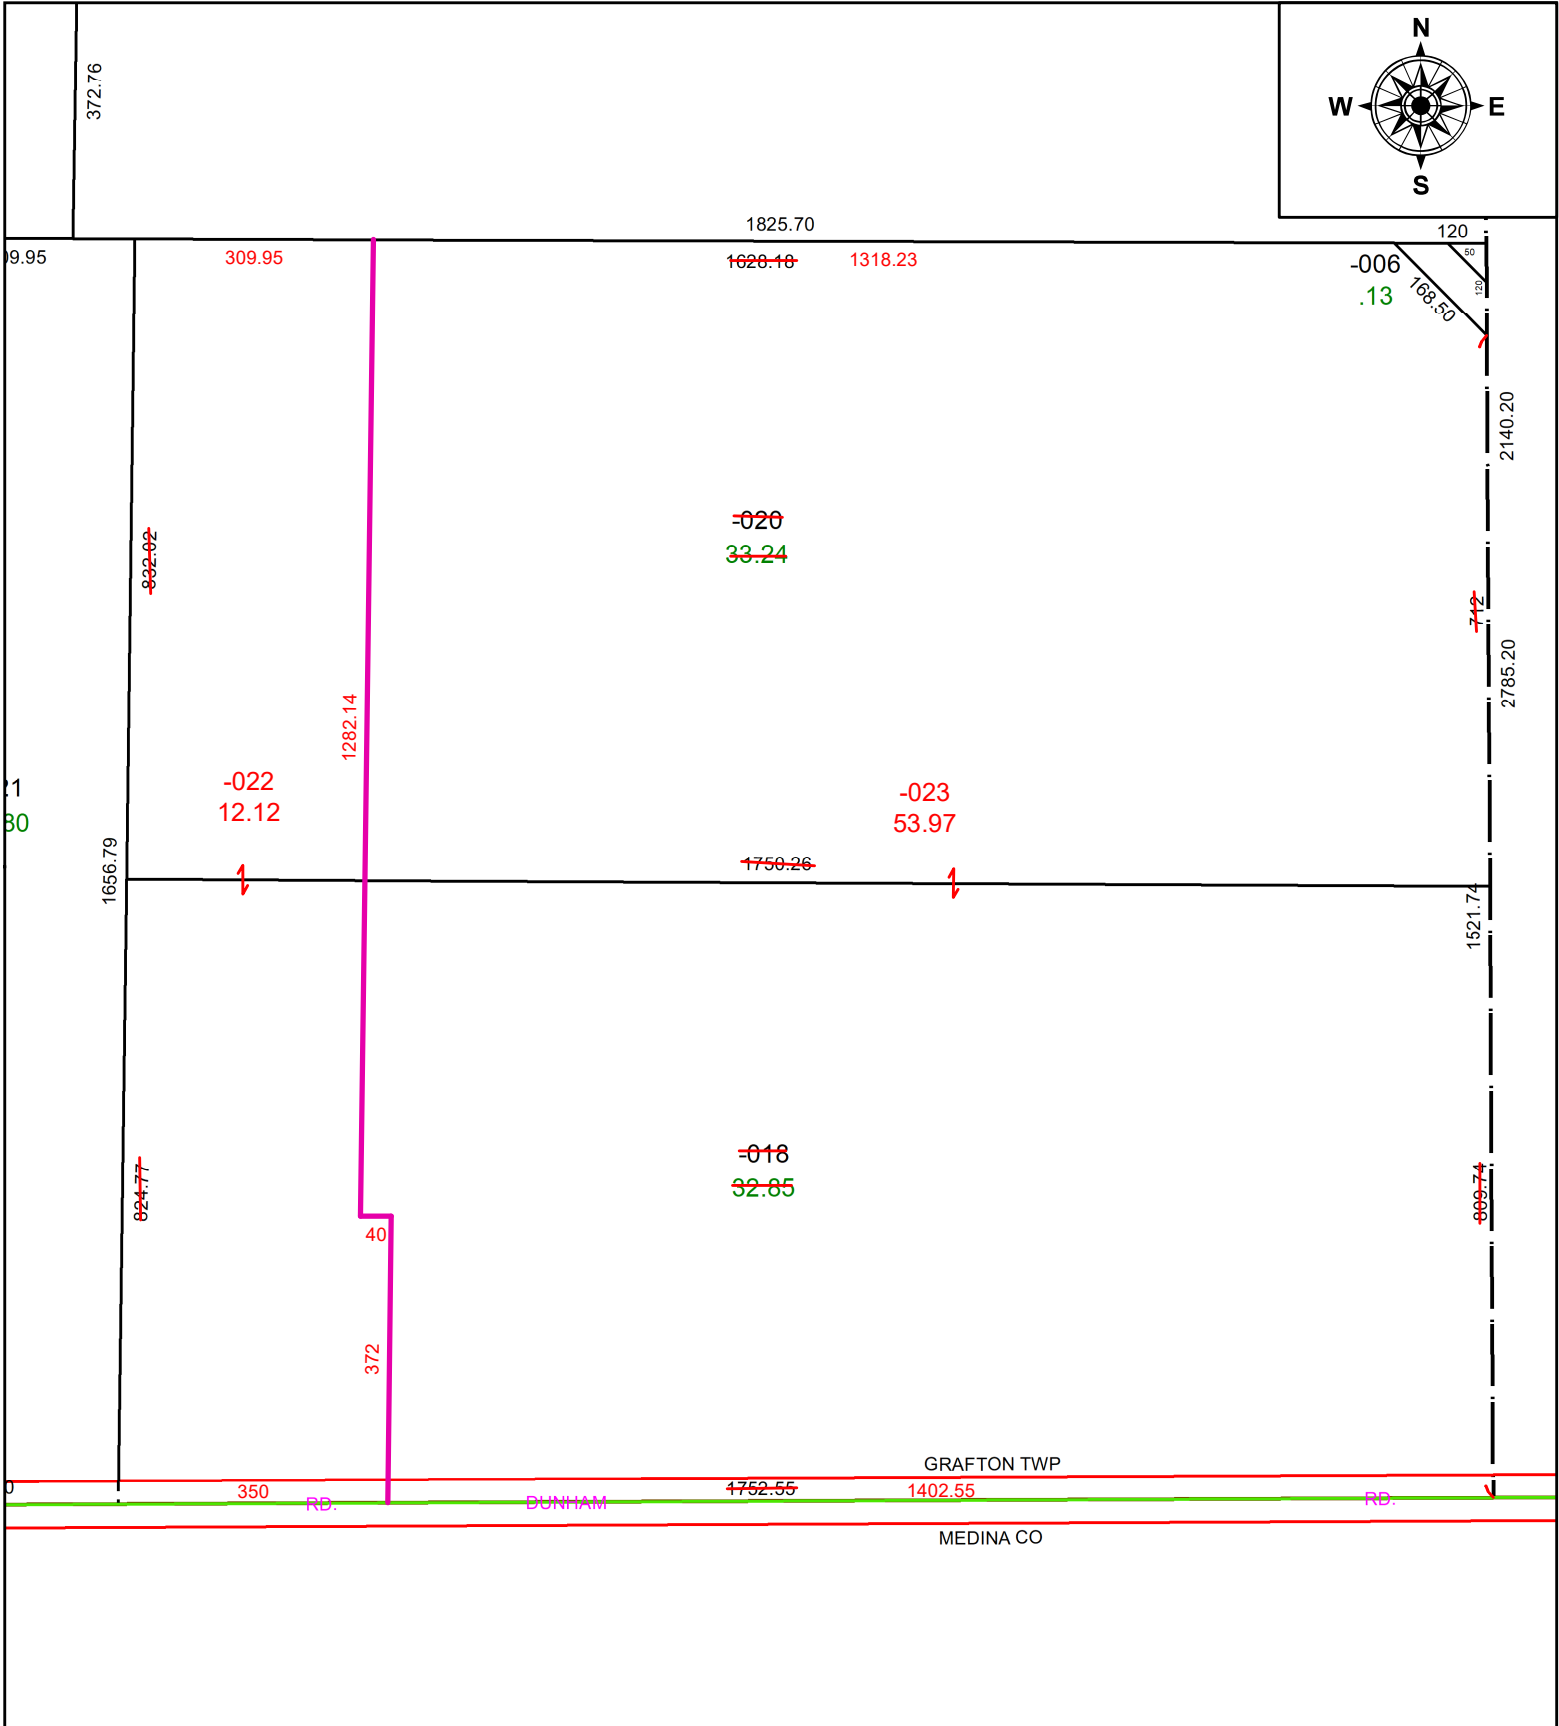

SPLITS/DEEDS PROCESSED
 LORAIN COUNTY TAX MAP DEPARTMENT
 226 MIDDLE AVE. ELYRIA, OH

SURVEYED BY: DOUGLAS S. JEWEL
 CLOSURE: 702017
 MAP PAGE(S): 16-00-094
 APPROVED BY: AC DATE: 4/22/2022
 SCALE: 1" = 250 PRIOR INSTRUMENT: 2011- 0364852