



PARENT PARCEL: 06-26-014-102-014

CHILD PARCEL:

STARTING POINT: NORTHEAST CORNER OF S/L 4 IN A.D. HOWE'S ADDITION

21-04469-C

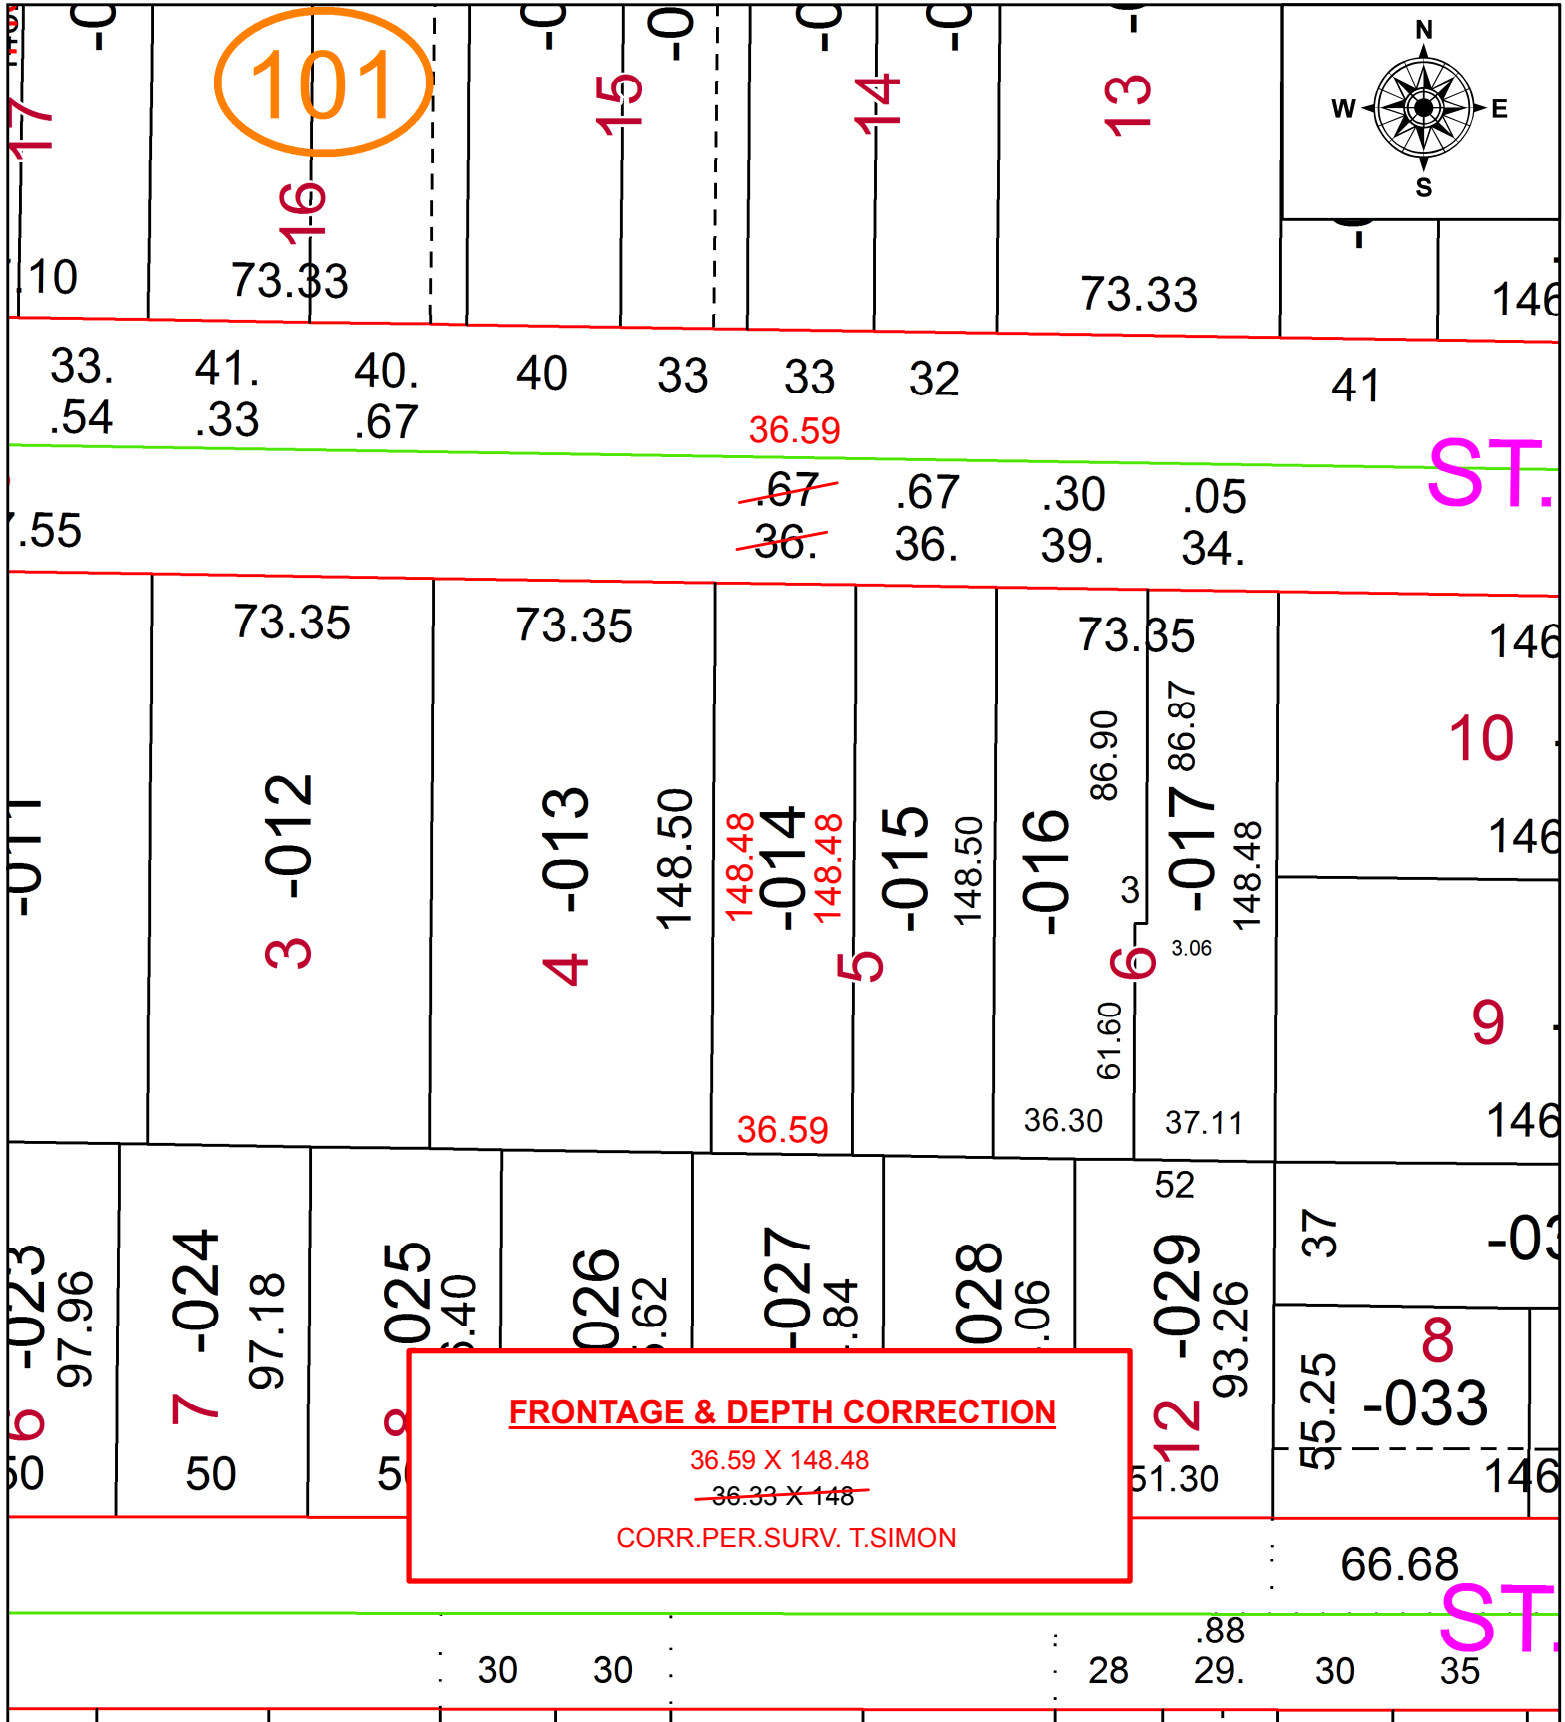

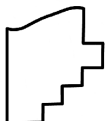 **SPLITS/DEEDS PROCESSED**
 LORAIN COUNTY TAX MAP DEPARTMENT
 226 MIDDLE AVE. ELYRIA, OH

SURVEYED BY: THOMAS A. SIMON
CLOSURE: 1: 2147483648
MAP PAGE(S): 6-26-014
APPROVED BY: RRM **DATE:** 1-13-21
SCALE: 1" = 50 **PRIOR INSTRUMENT:** 20160611207