
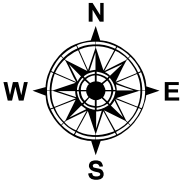


PARENT PARCEL: 06-21-003-101-038, 06-21-004-102-031

CHILD PARCEL: 06-21-003-101-040, -041, 06-21-004-102-031

STARTING POINT: C/L OF N RIDGE RD AND LAKE AVE

22-04469

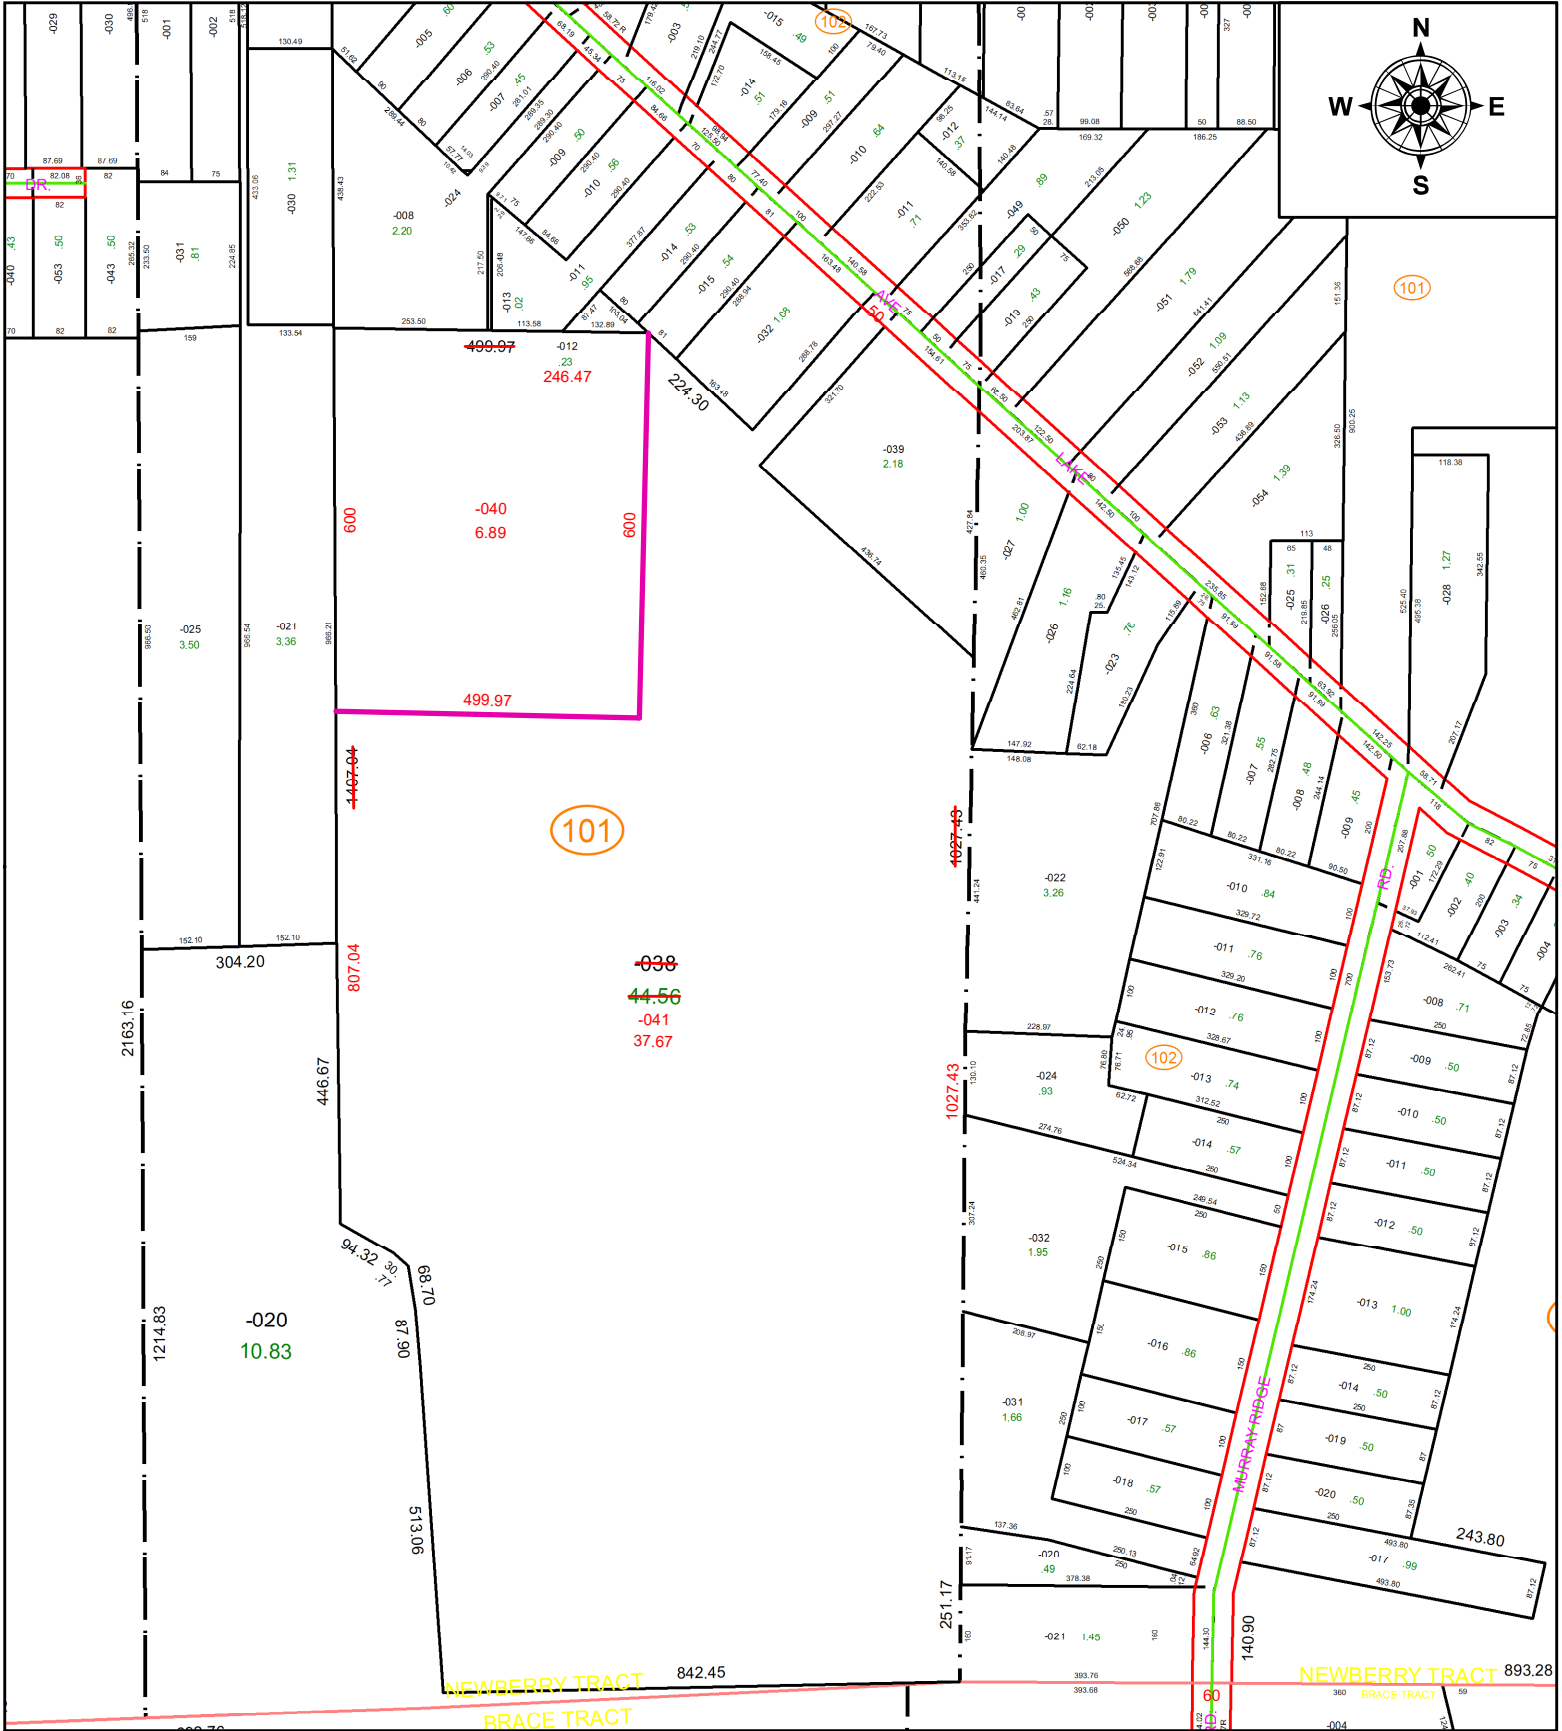

101

102

SPLITS/DEEDS PROCESSED
 LORAIN COUNTY TAX MAP DEPARTMENT
 226 MIDDLE AVE. ELYRIA, OH

SURVEYED BY: THOMAS A. SIMON
CLOSURE: 1: 2147483648
MAP PAGE(S): 06-3
APPROVED BY: AC **DATE:** 4/27/2022
SCALE: 1" = 300 **PRIOR INSTRUMENT:** 2021- 0856512