
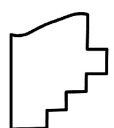


PARENT PARCEL: 07-00-003-102-101

CHILD PARCEL: 07-00-003-102-105 THRU -107

22-04470

STARTING POINT: INTERSECTION OF C/L'S OF VICTORY LN & BUTTERNUT RIDGE RD AT A MONUMENT BOX

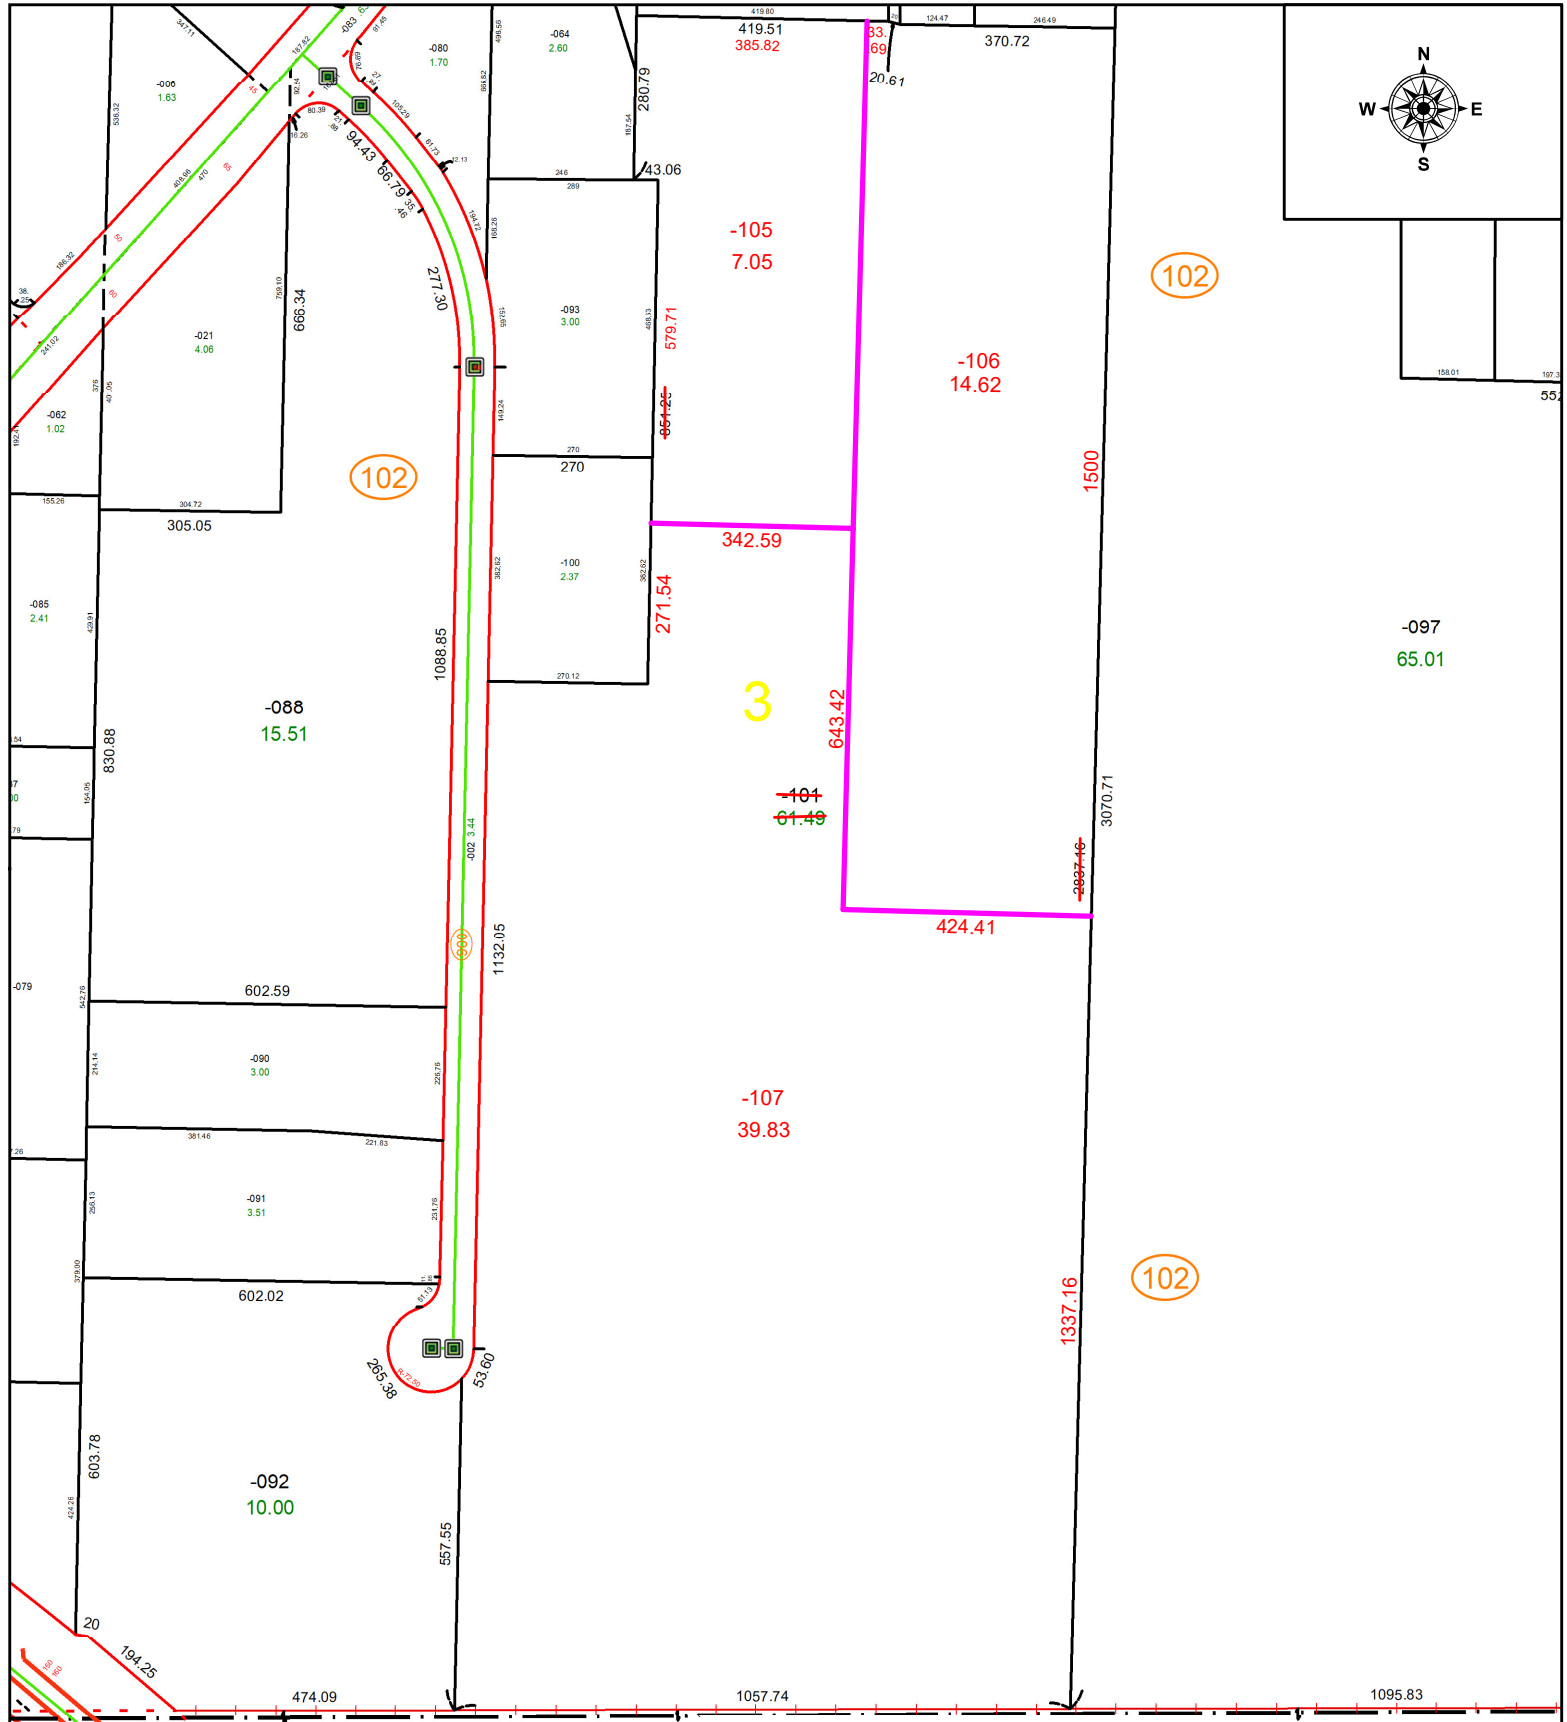

SPLITS/DEEDS PROCESSED
 LORAIN COUNTY TAX MAP DEPARTMENT
 226 MIDDLE AVE. ELYRIA, OH

SURVEYED BY: MATTHEW HILDEBRANDT
CLOSURE: 1: 1163954
MAP PAGE(S): 07-00-003
APPROVED BY: WRZ **DATE:** 4/28/2022
SCALE: 1" = 325 **PRIOR INSTRUMENT:** 2020-0751380