


PARENT PARCEL: 10-00-004-108-034, -038, & -039

CHILD PARCEL: 10-00-004-108-044

STARTING POINT: N/A


22-04472

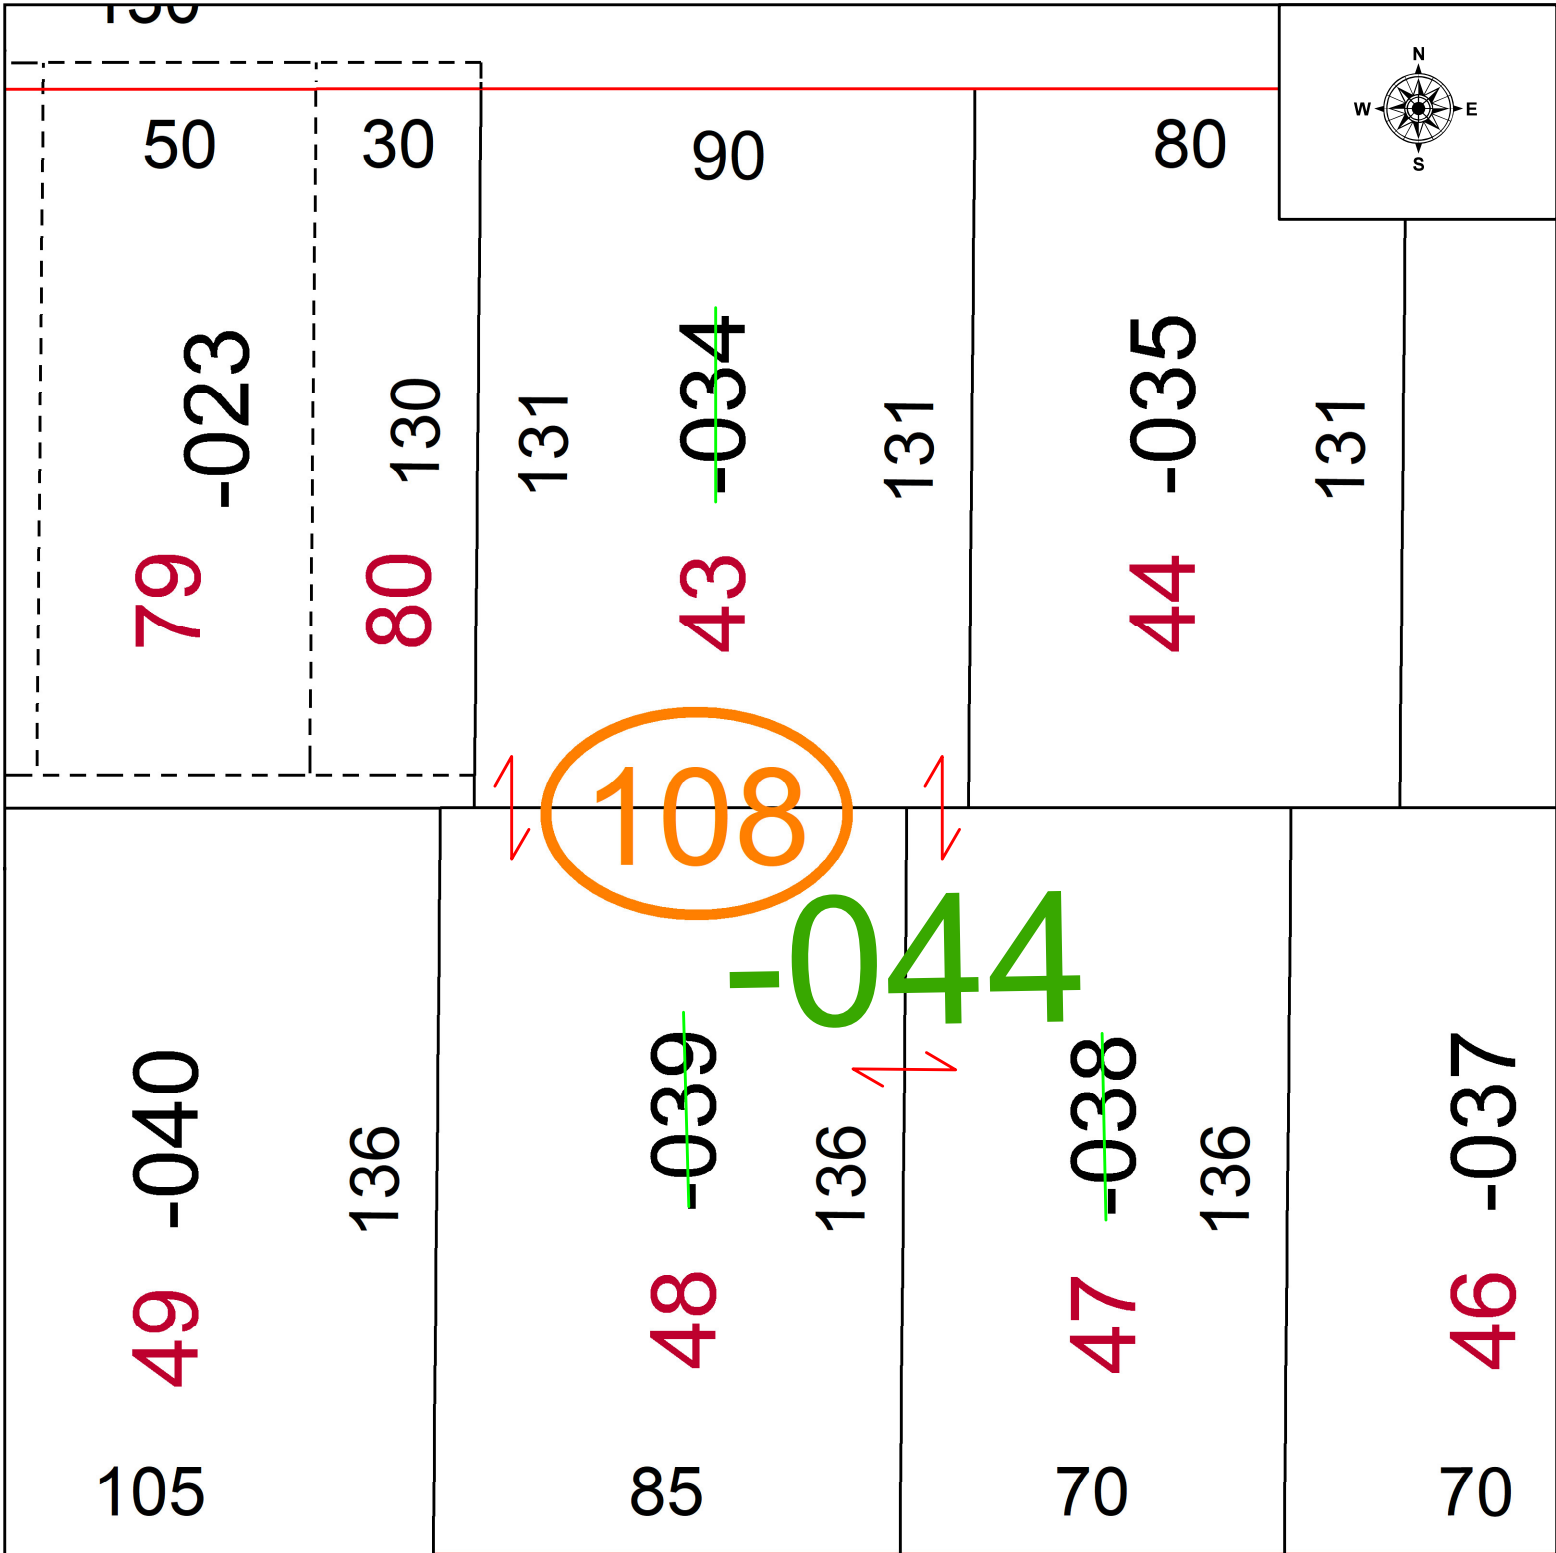

108

-044

155

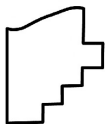

SPLITS/DEEDS PROCESSED
LORAIN COUNTY TAX MAP DEPARTMENT
226 MIDDLE AVE. ELYRIA, OH

SURVEYED BY:	N/A
CLOSURE:	N/A
MAP PAGE(S):	10-00-004
APPROVED BY:	WRZ DATE: 5/10/2022
SCALE:	1" = 35' PRIOR INSTRUMENT: 2019-0706379