
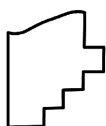
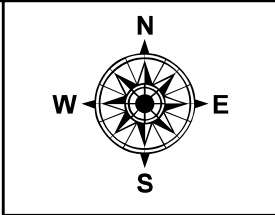


PARENT PARCEL: 03-00-039-119-037, -038, -039

CHILD PARCEL: 03-00-039-119-069

STARTING POINT: COMBINATION PER DEED

22-04473

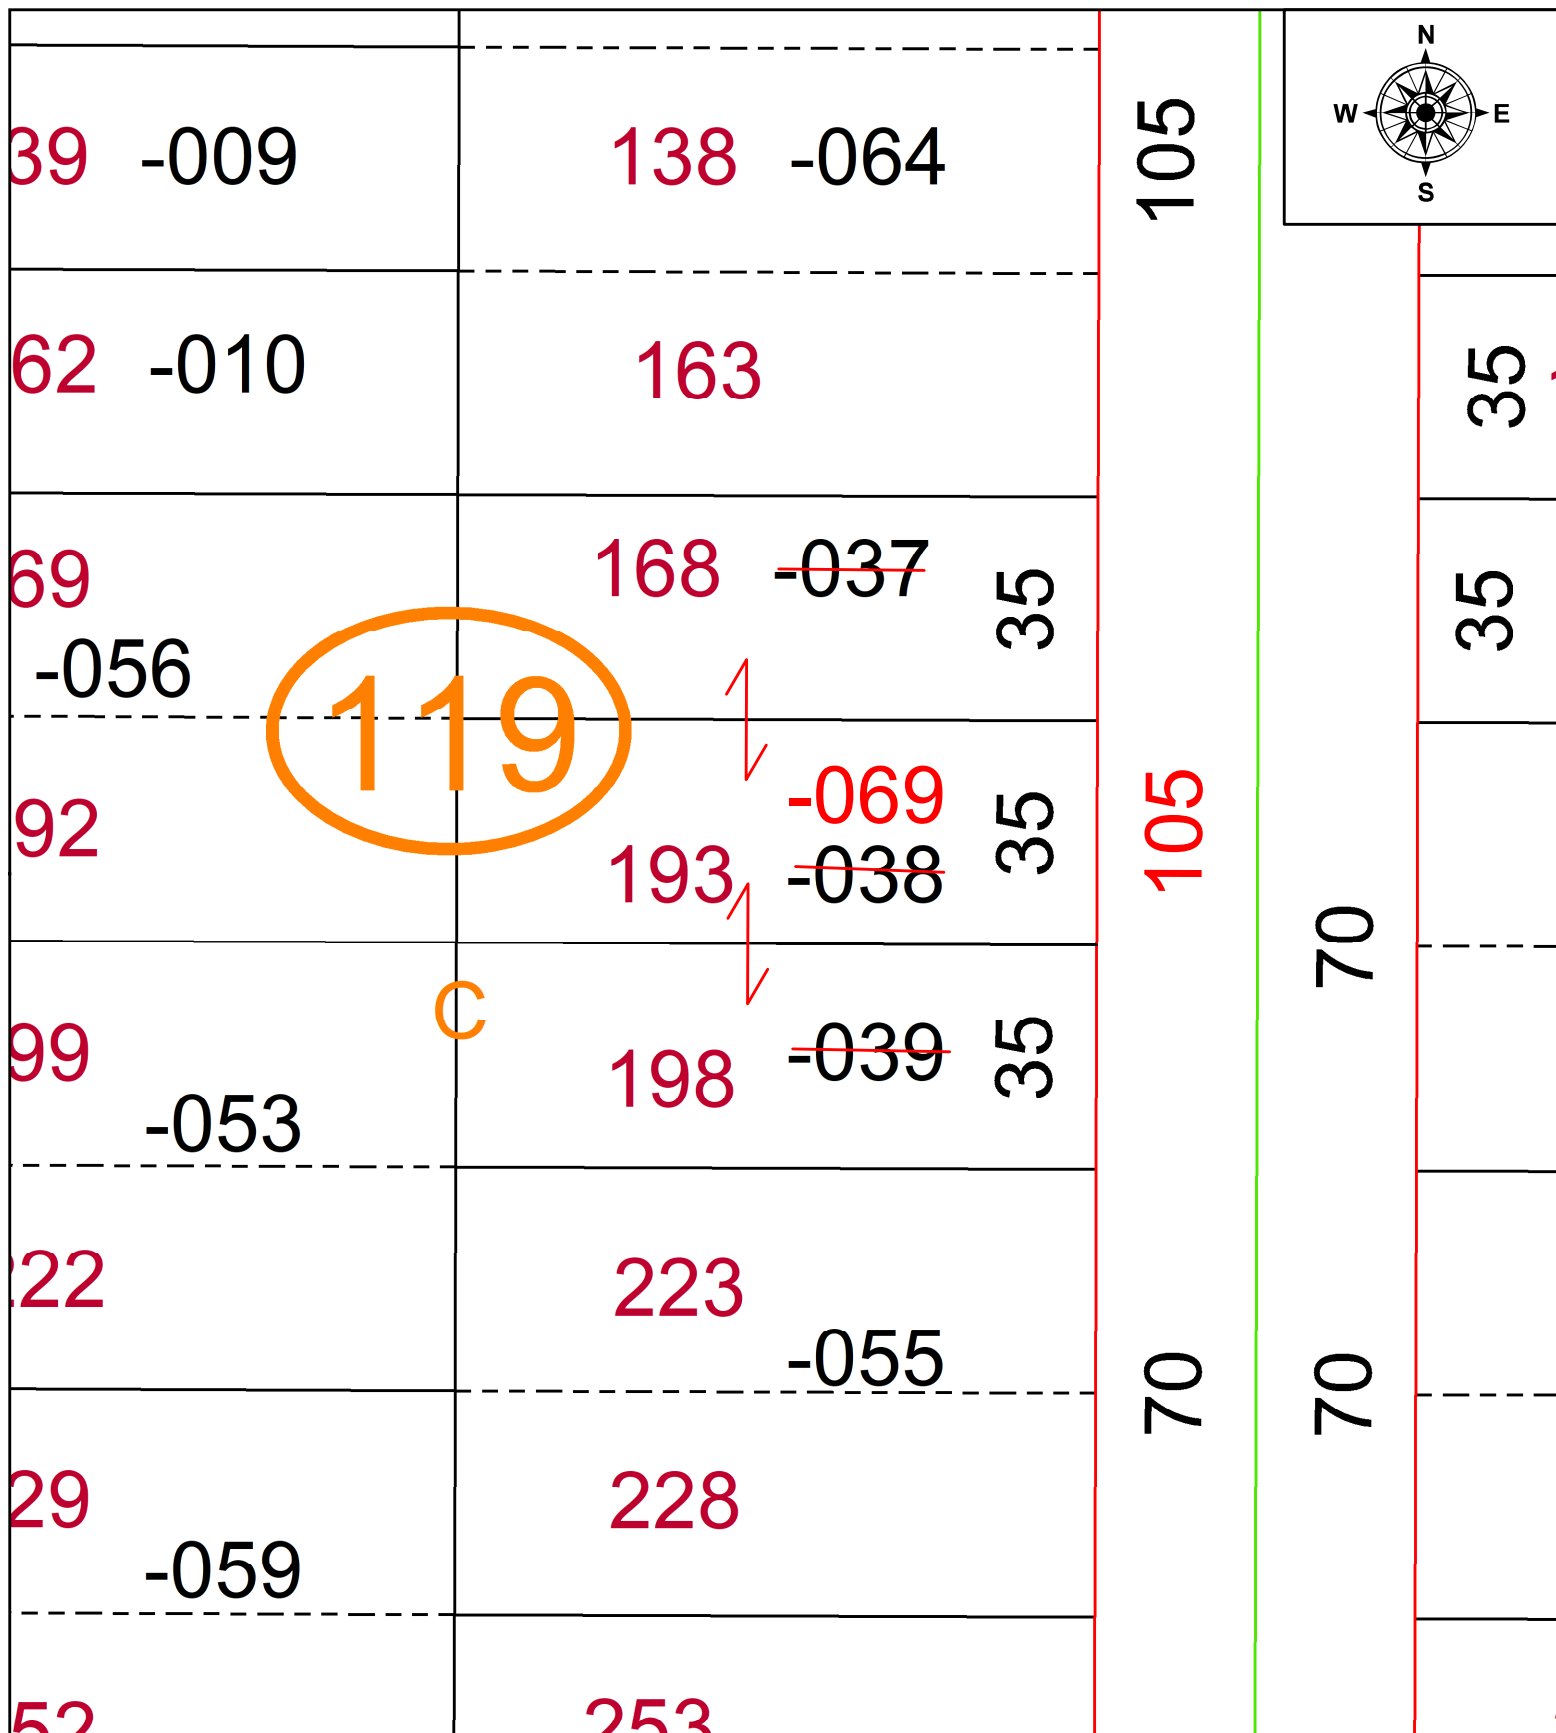

**SPLITS/DEEDS PROCESSED**  
 LORAIN COUNTY TAX MAP DEPARTMENT  
 226 MIDDLE AVE. ELYRIA, OH

SURVEYED BY: \_\_\_\_\_ N/A  
 CLOSURE: \_\_\_\_\_ N/A  
 MAP PAGE(S): 03-00-039-B  
 APPROVED BY: AC DATE: 5/11/2022  
 SCALE: 1" = 30' PRIOR INSTRUMENT: 2019- 0734547