
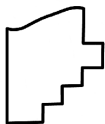
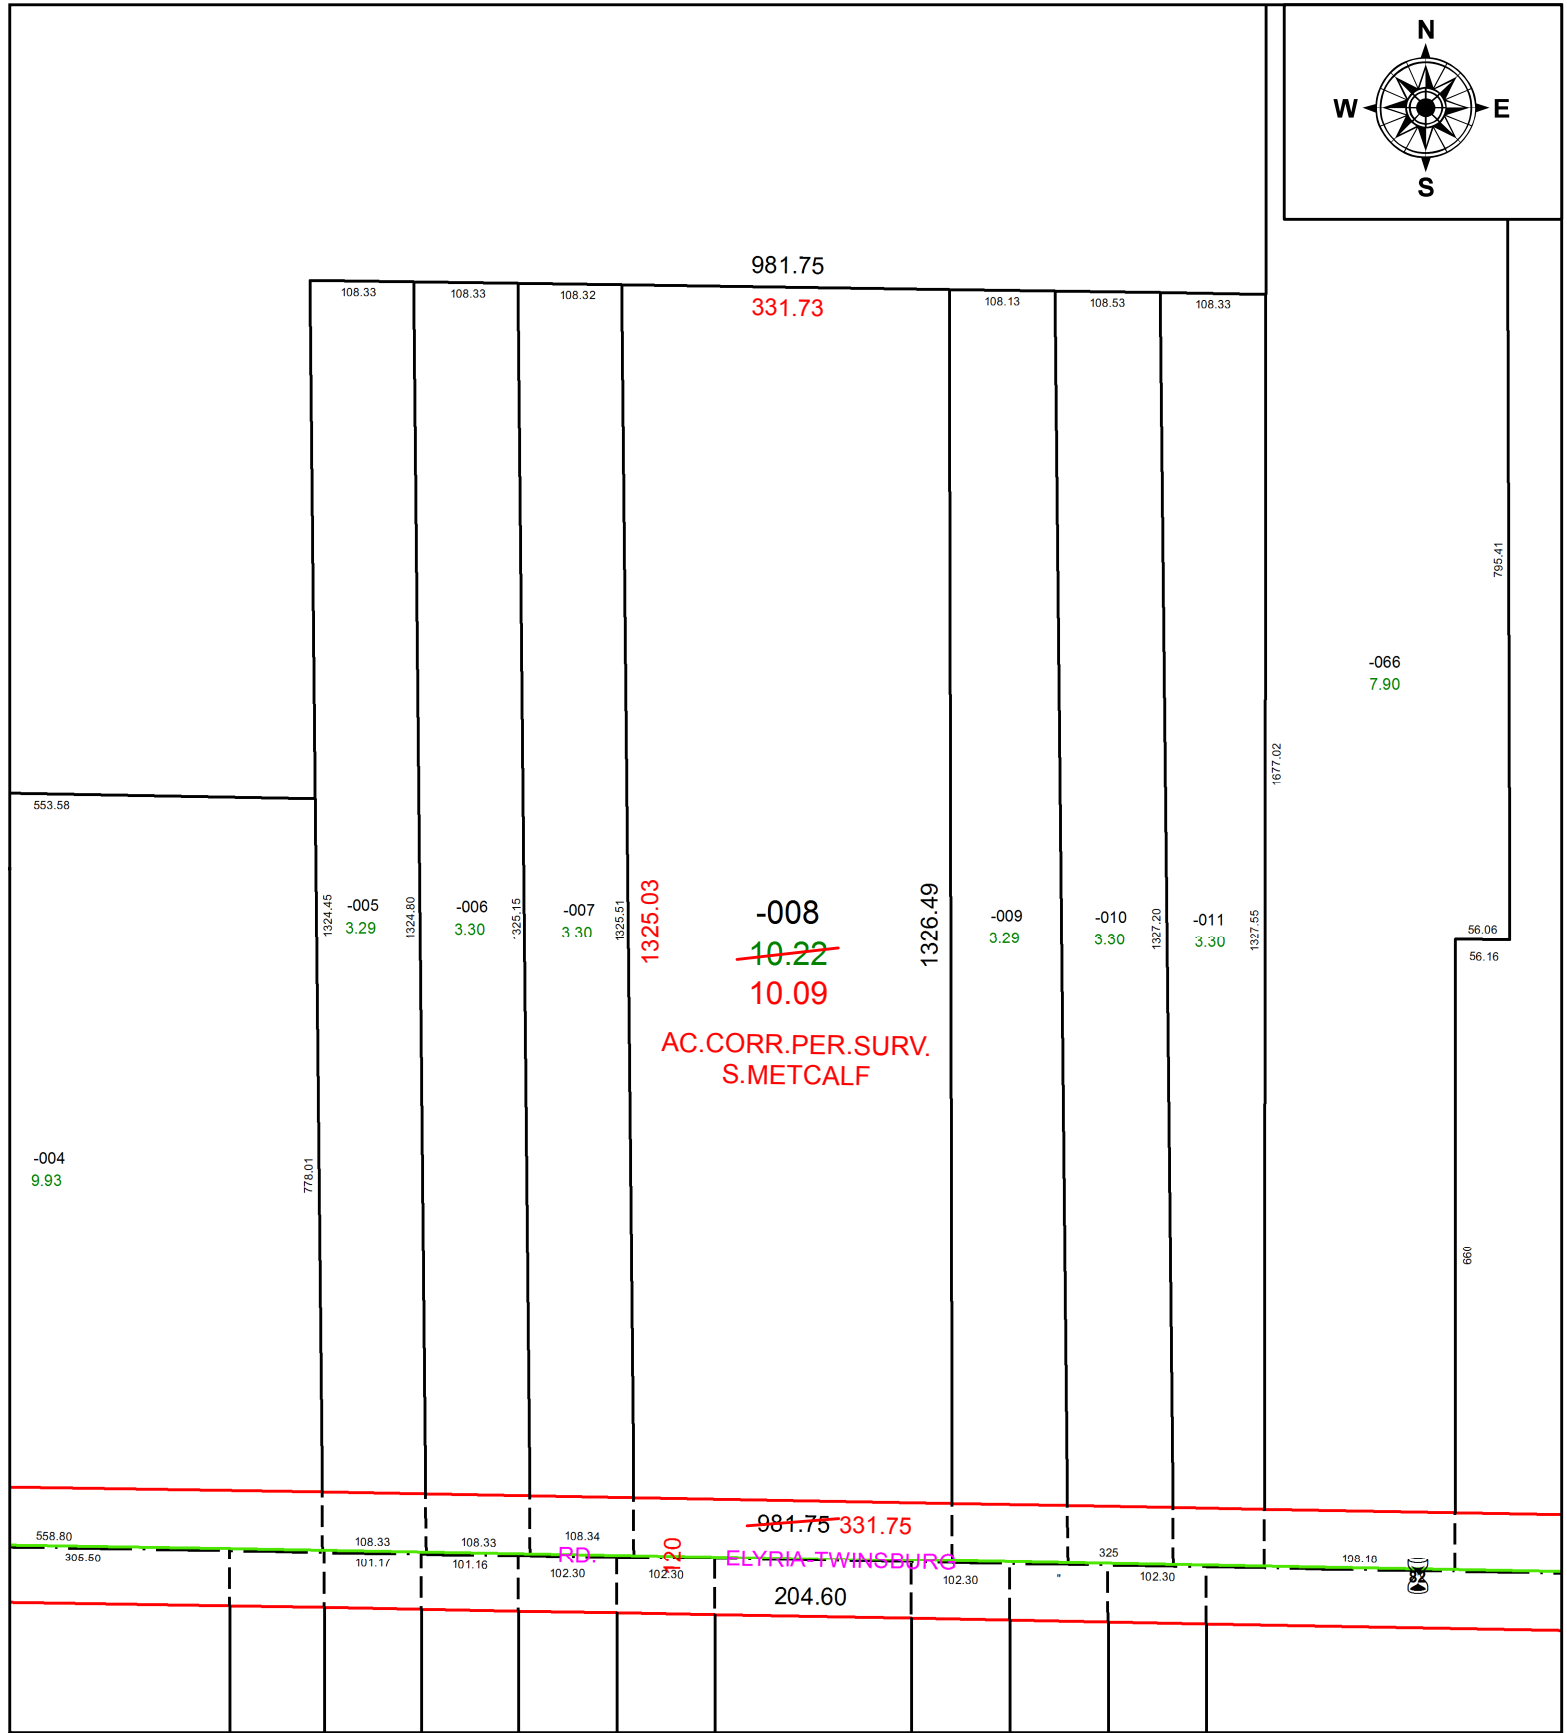


PARENT PARCEL: 11-00-066-000-008  
 CHILD PARCEL:  
 STARTING POINT: SOUTHEAST CORNER OF O.L.66

21-04475-A

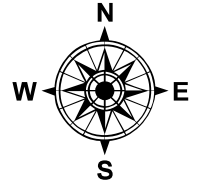

**SPLITS/DEEDS PROCESSED**  
 LORAIN COUNTY TAX MAP DEPARTMENT  
 226 MIDDLE AVE. ELYRIA, OH

SURVEYED BY: STEVEN J. METCALF  
 CLOSURE: 1: 975,383  
 MAP PAGE(S): 11-00-066  
 APPROVED BY: RRM DATE: 1-20-21  
 SCALE: 1" = 200 PRIOR INSTRUMENT: OR 376/450