
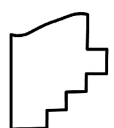


PARENT PARCEL: 04-00-023-101-004

CHILD PARCEL: 04-00-023-101-068 & -069

STARTING POINT: CL OF EMORY DR. & JAYCOX RD.

22-04479

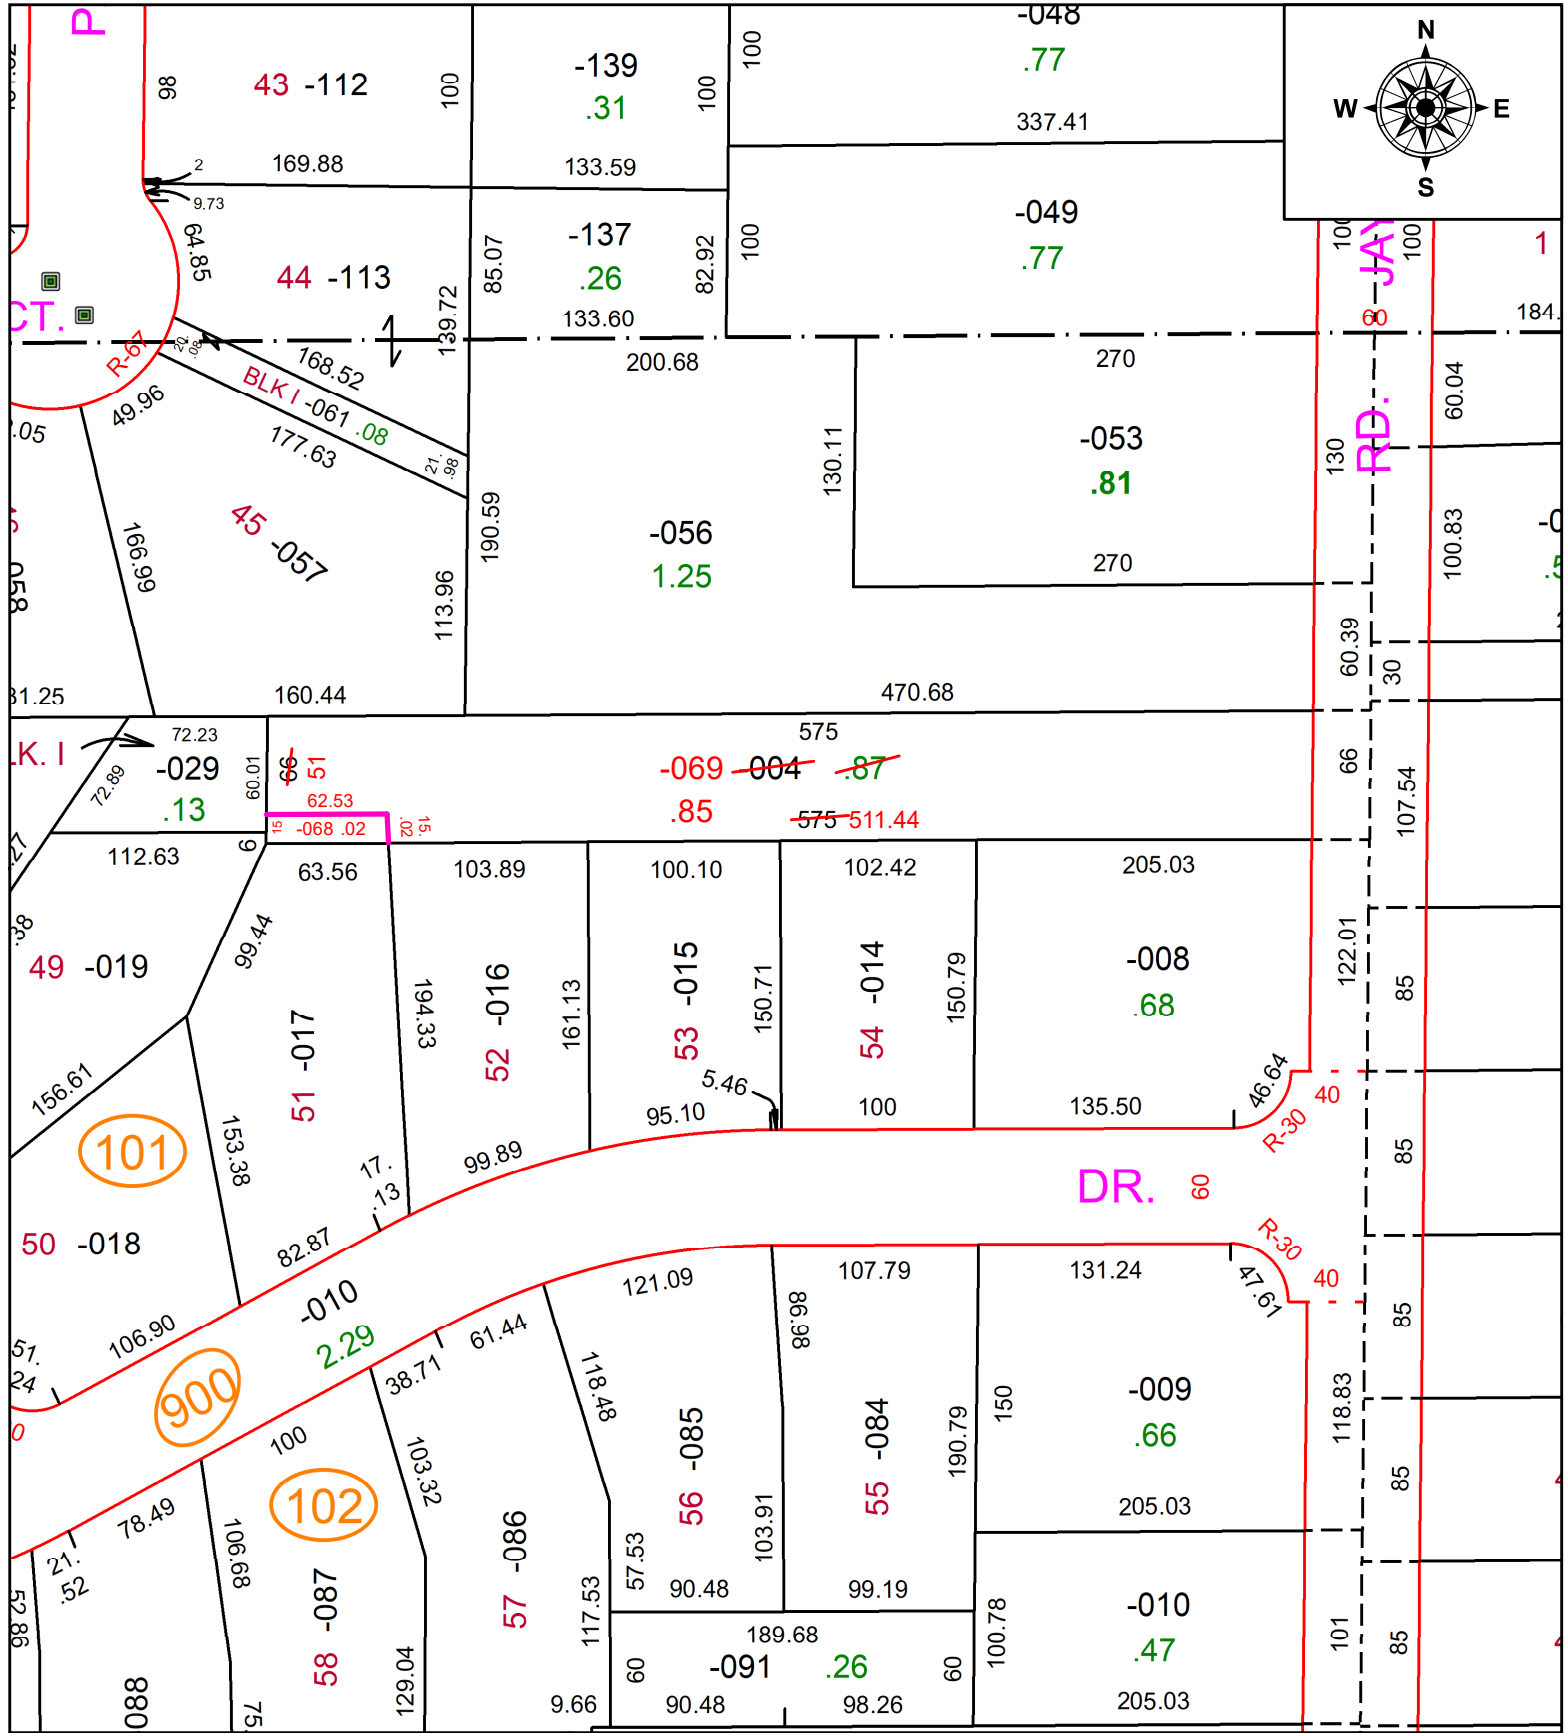

SPLITS/DEEDS PROCESSED
 LORAIN COUNTY TAX MAP DEPARTMENT
 226 MIDDLE AVE. ELYRIA, OH

SURVEYED BY: RICHARD THOMPON JR.
CLOSURE: 1: 34469
MAP PAGE(S): 04-00-023
APPROVED BY: DMA **DATE:** 5/17/2022
SCALE: 1" = 100' **PRIOR INSTRUMENT:** 2022-0858645