


PARENT PARCEL: 04-00-007-150-006

CHILD PARCEL: 04-00-007-150-301 & -302

STARTING POINT: **AC CORR PER SURV BY AMY M. KELLY**

22-04482

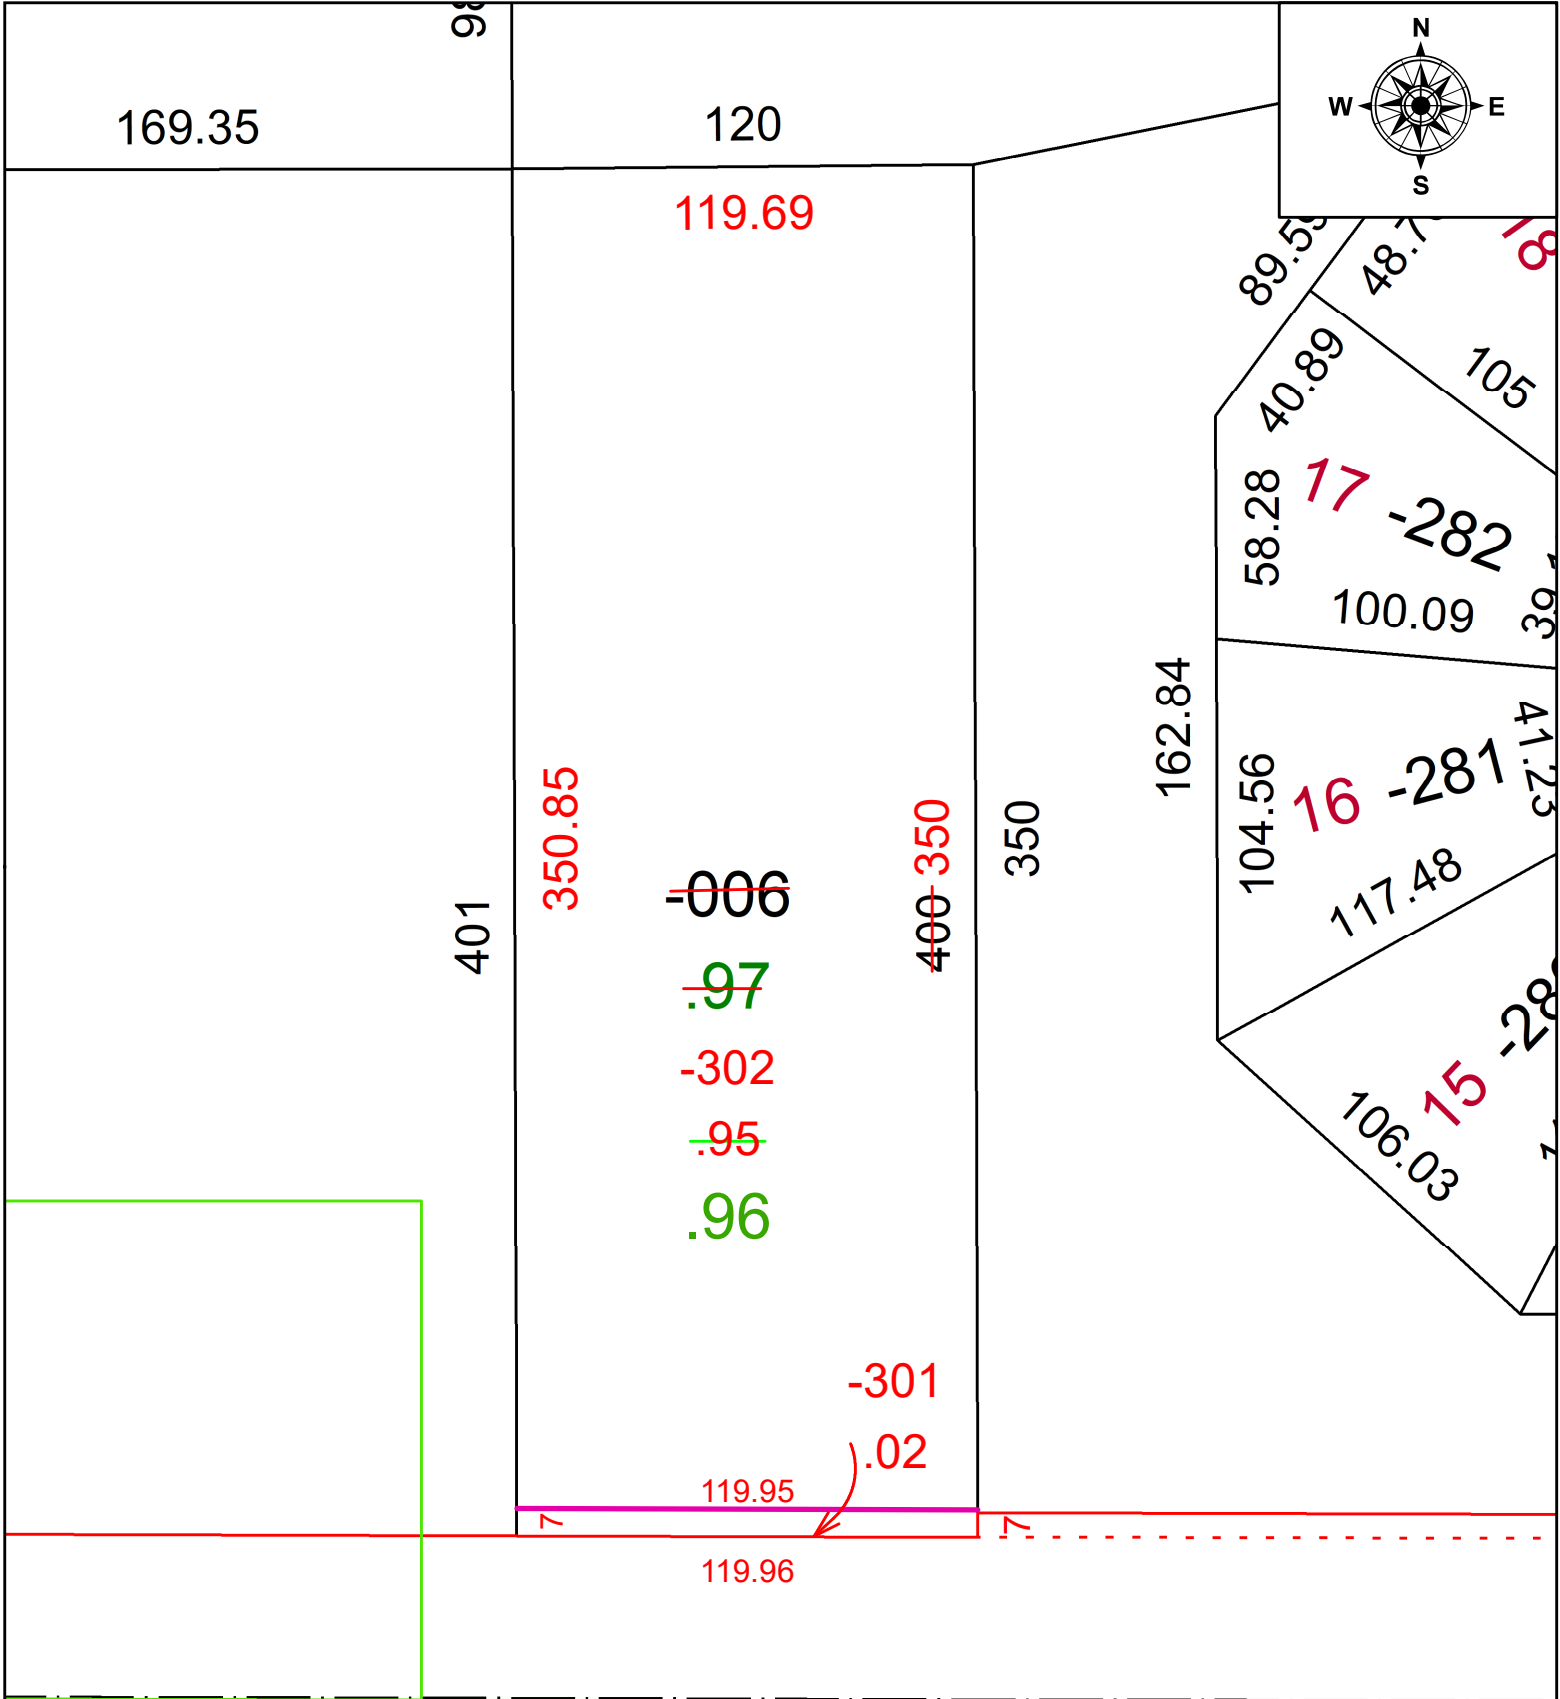

**SPLITS/DEEDS PROCESSED**  
 LORAIN COUNTY TAX MAP DEPARTMENT  
 226 MIDDLE AVE. ELYRIA, OH

SURVEYED BY: AMY M. KELLY  
 CLOSURE: 1: 54344  
 MAP PAGE(S): 04-00-007-E  
 APPROVED BY: AC DATE: 5/18/2022  
 SCALE: 1" = 50 PRIOR INSTRUMENT: 2002- 0847194