


PARENT PARCEL: 09-00-074-102-013

CHILD PARCEL: 09-00-074-102-036 & -037

STARTING POINT: CL OF PYLE SOUTH ANHERST RD. & WEST LORAIN ST.

22-04490

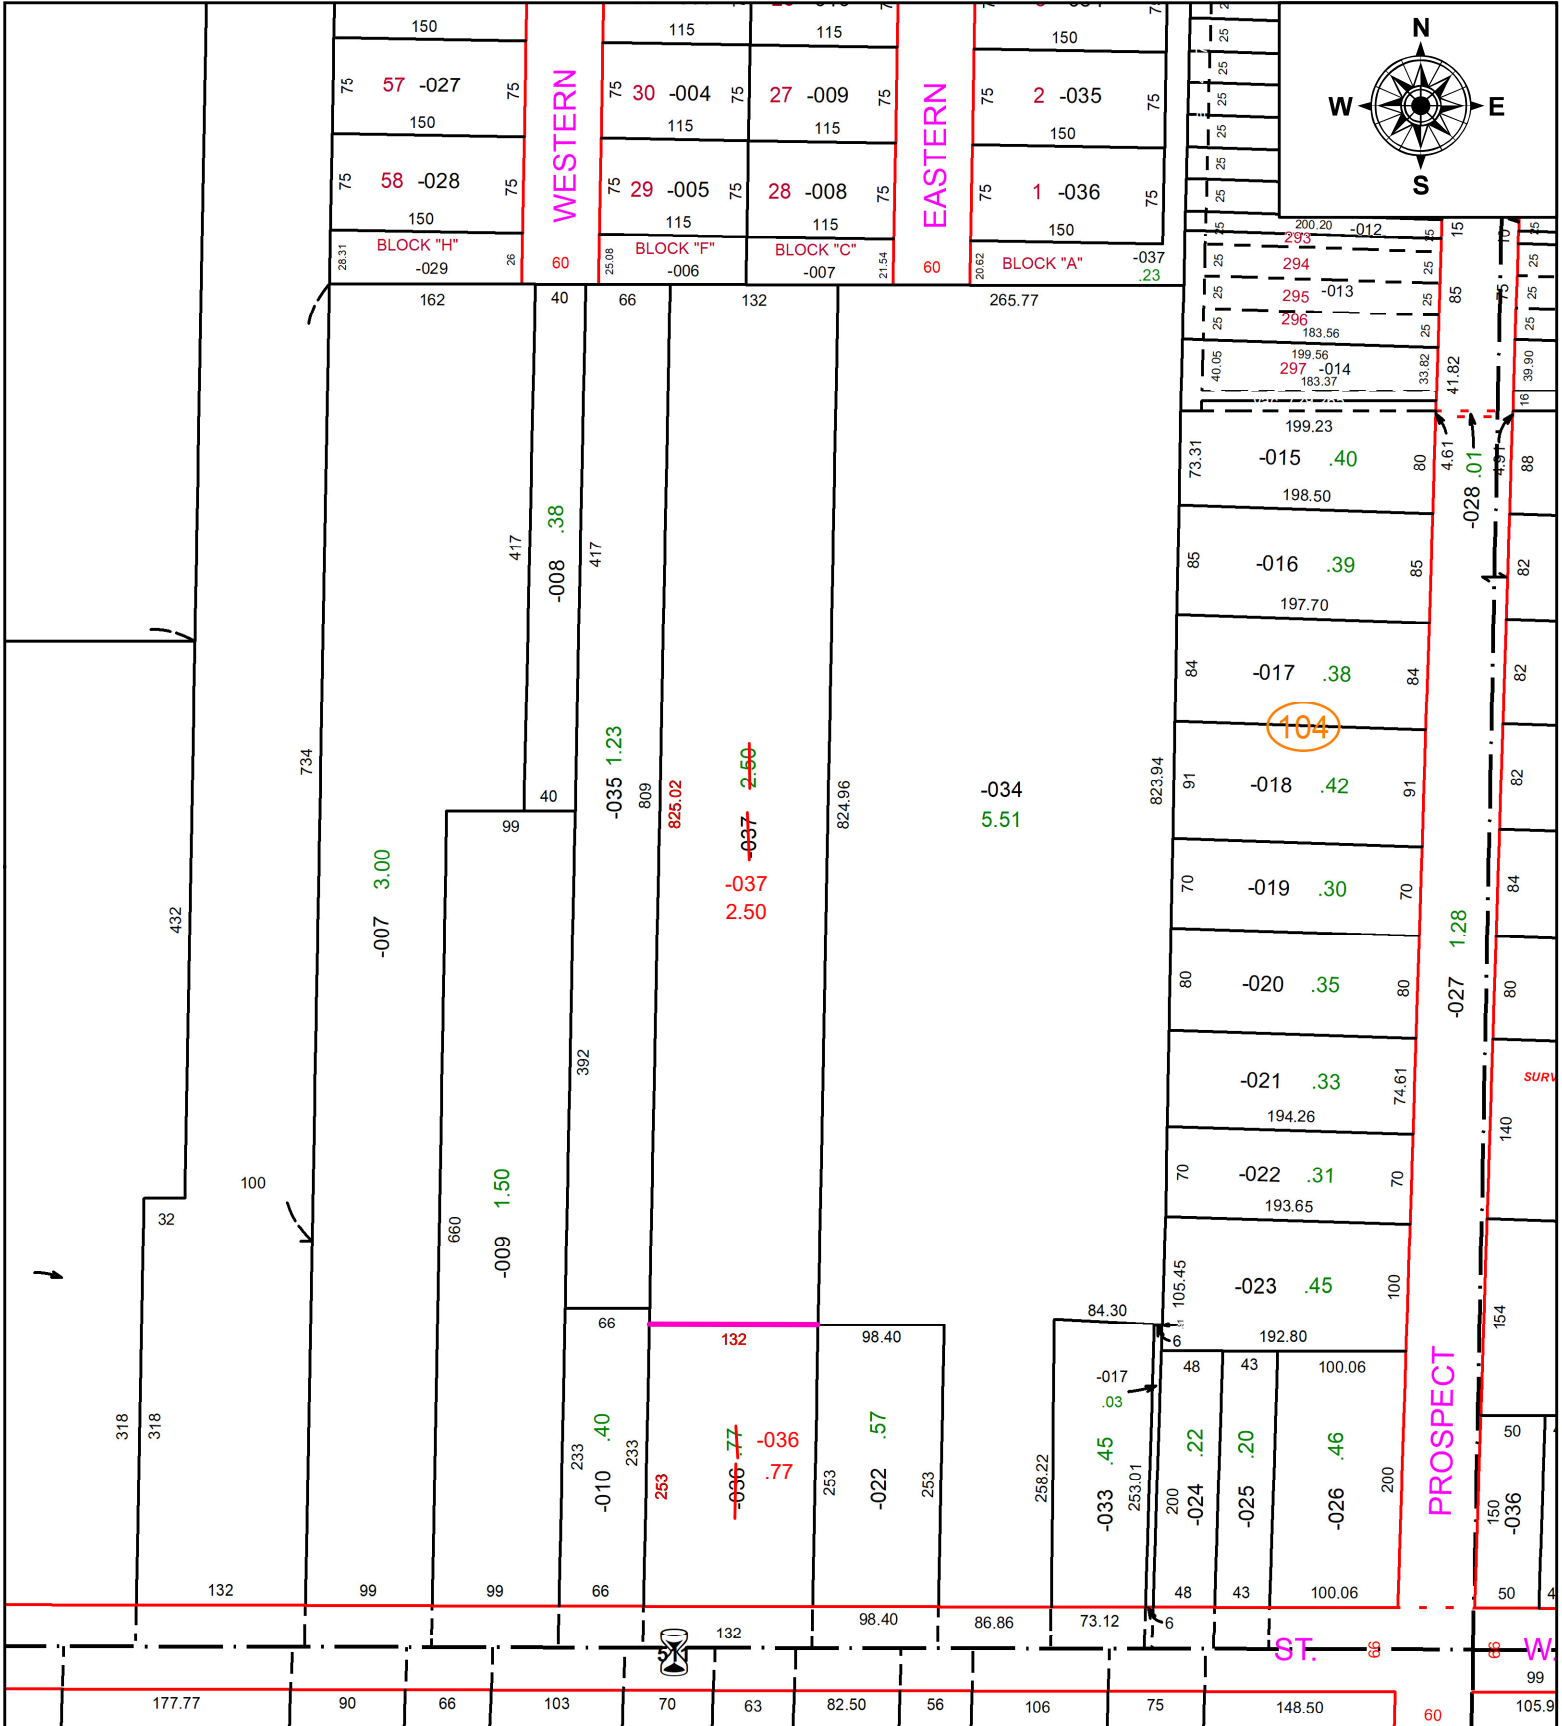

SPLITS/DEEDS PROCESSED
 LORAIN COUNTY TAX MAP DEPARTMENT
 226 MIDDLE AVE. ELYRIA, OH

SURVEYED BY: BRENT ANDERSON

CLOSURE: 1: 2147483648

MAP PAGE(S): 09-00-074

APPROVED BY: DMA DATE: 6/7/2022

SCALE: 1" = 150' PRIOR INSTRUMENT: 2005-0056603