


PARENT PARCEL: 09-00-074-101-023, -024, -026, -031, 09-00-074-102-001

CHILD PARCEL: 09-00-074-101-059, -060

STARTING POINT: NORTHWEST CORNER OF O.L.74

21-04492-C

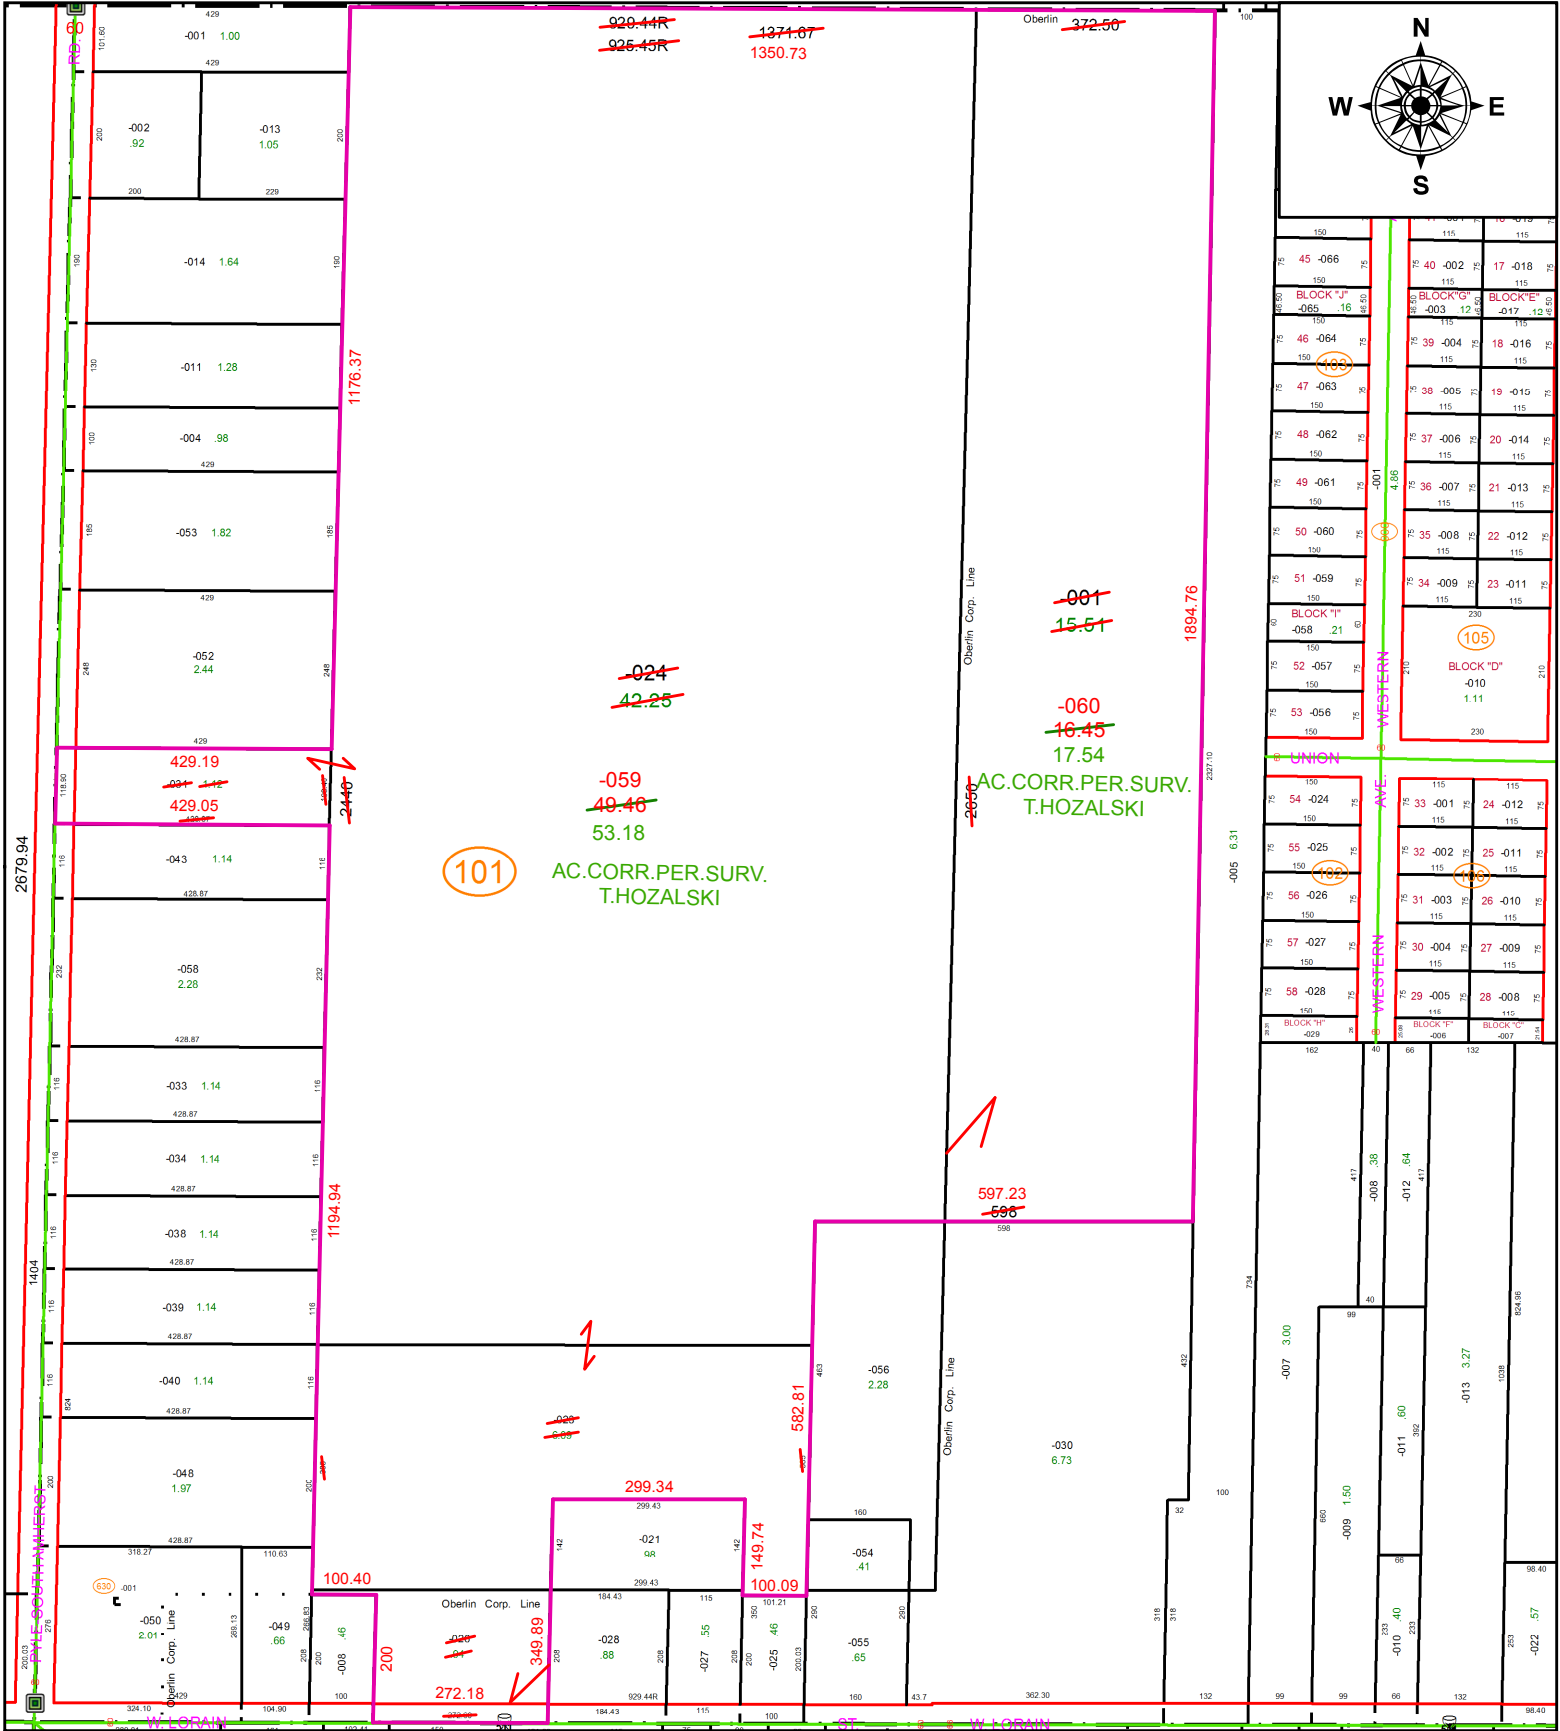

101

AC.CORR.PER.SURV.
T.HOZALSKI

AC.CORR.PER.SURV.
T.HOZALSKI

SPLITS/DEEDS PROCESSED
 LORAIN COUNTY TAX MAP DEPARTMENT
 226 MIDDLE AVE. ELYRIA, OH

SURVEYED BY: TIMOTHY D. HOZALSKI

CLOSURE: 1:1,098,167

MAP PAGE(S): 9-00-074

APPROVED BY: RRM DATE: 2-18-21

SCALE: 1" = 300 PRIOR INSTRUMENT: 20160572192