


PARENT PARCEL: 01-00-051-000-058, 01-00-062-000-064

CHILD PARCEL: 01-00-051-000-066, -067, 01-00-062-000-065 THRU -067

STARTING POINT: **AC CORR PER SURV BY TIMOTHY D. HOZALSKI**

22-04493

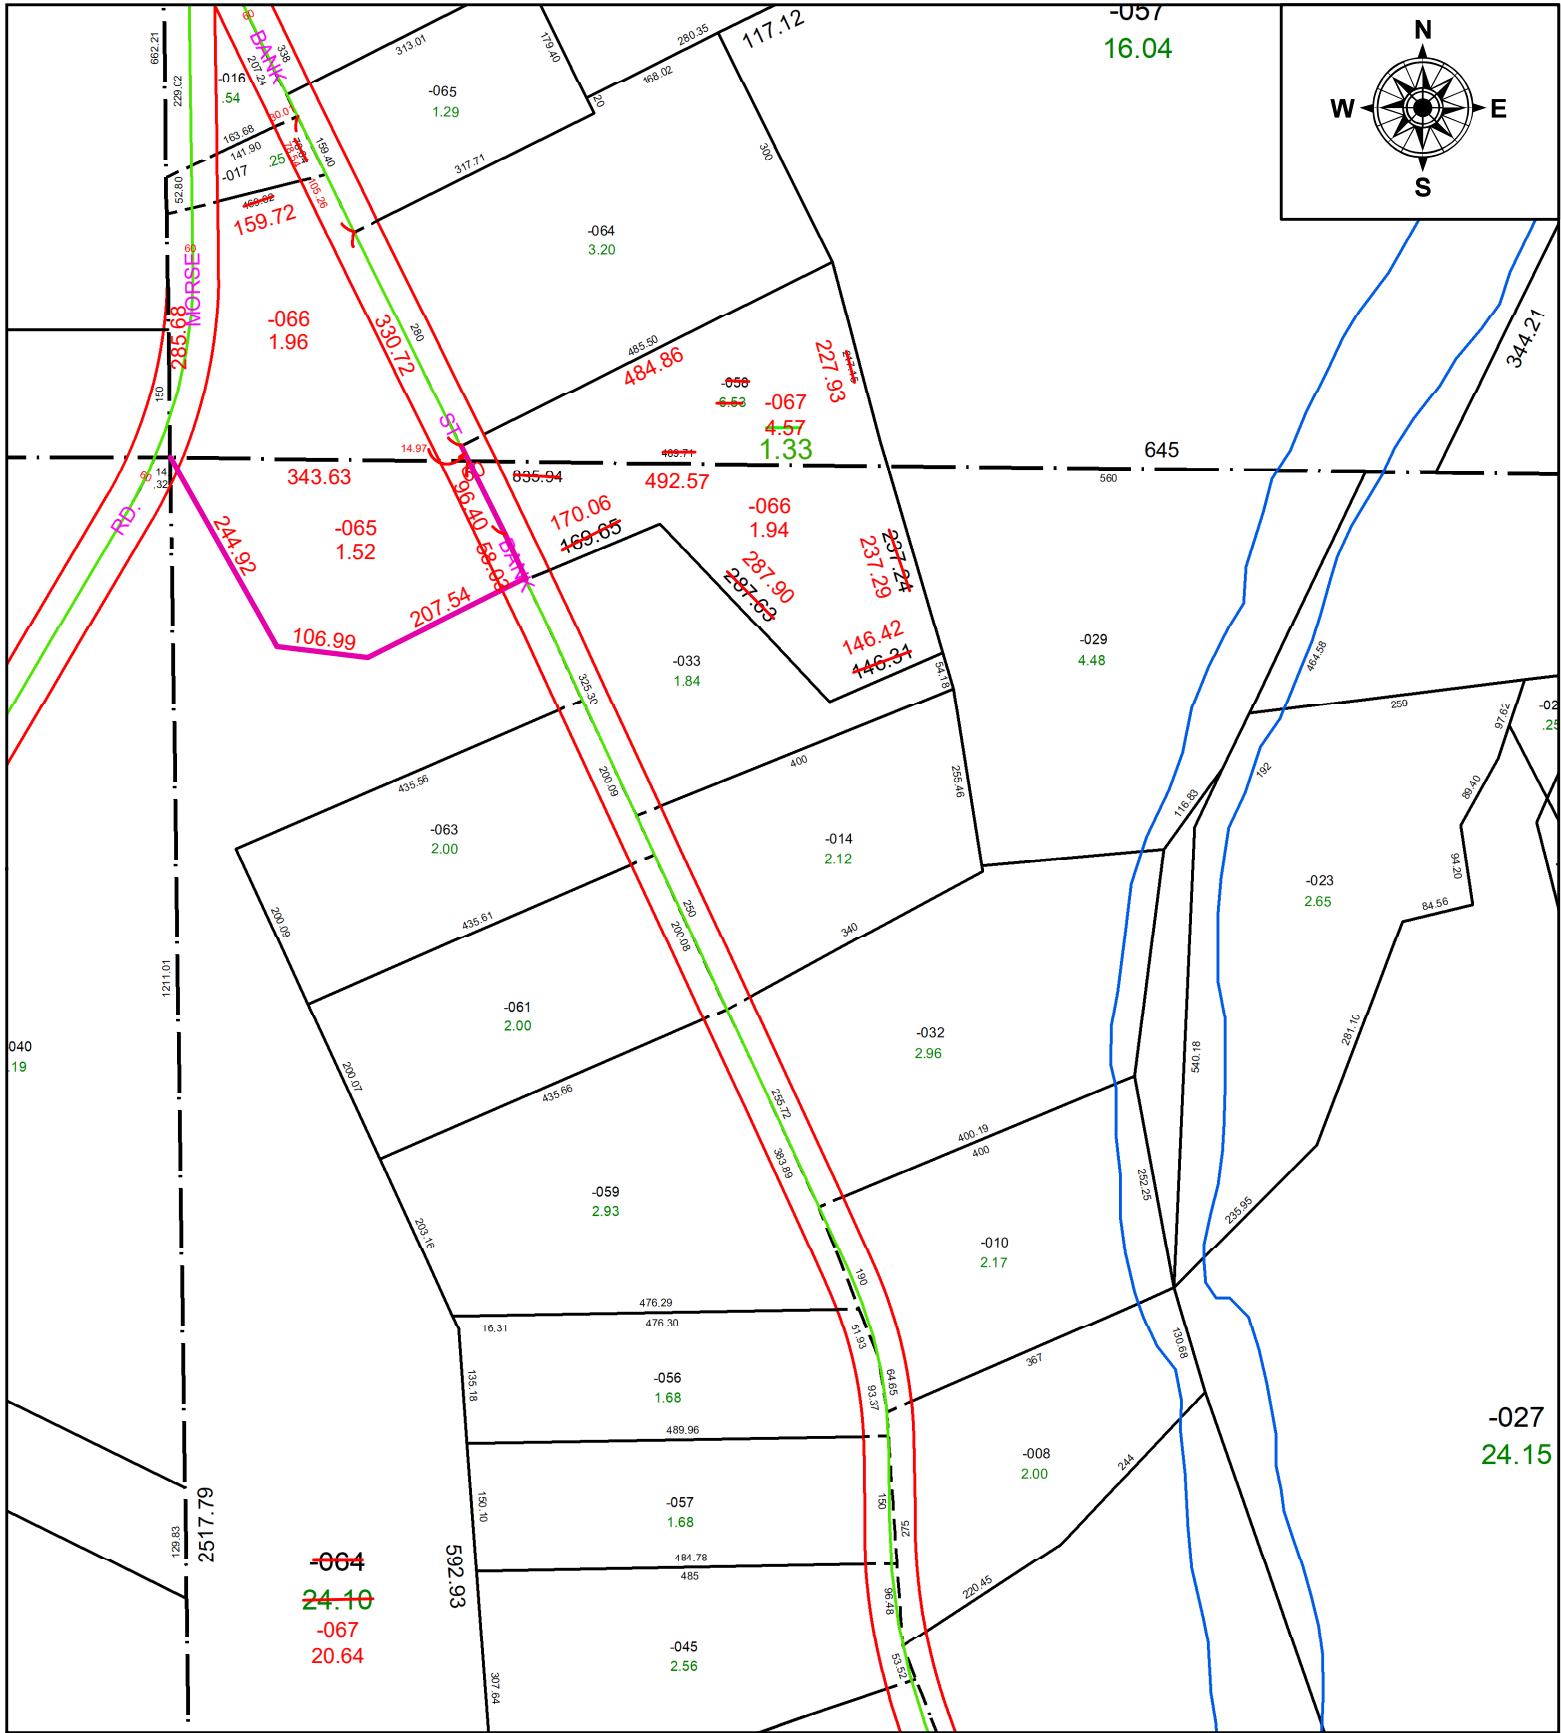

SPLITS/DEEDS PROCESSED
 LORAIN COUNTY TAX MAP DEPARTMENT
 226 MIDDLE AVE. ELYRIA, OH

SURVEYED BY: TIMOTHY D. HOZALSKI
CLOSURE: 1: 100789
MAP PAGE(S): 01-00-062 & -051
APPROVED BY: AC **DATE:** 6/9/2022
SCALE: 1" = 225 **PRIOR INSTRUMENT:** 2022- 0868904